1-00-035-A
1-00-046-A, B

#14882

Scan # 46504

01-00-035-005
01-00-046-000

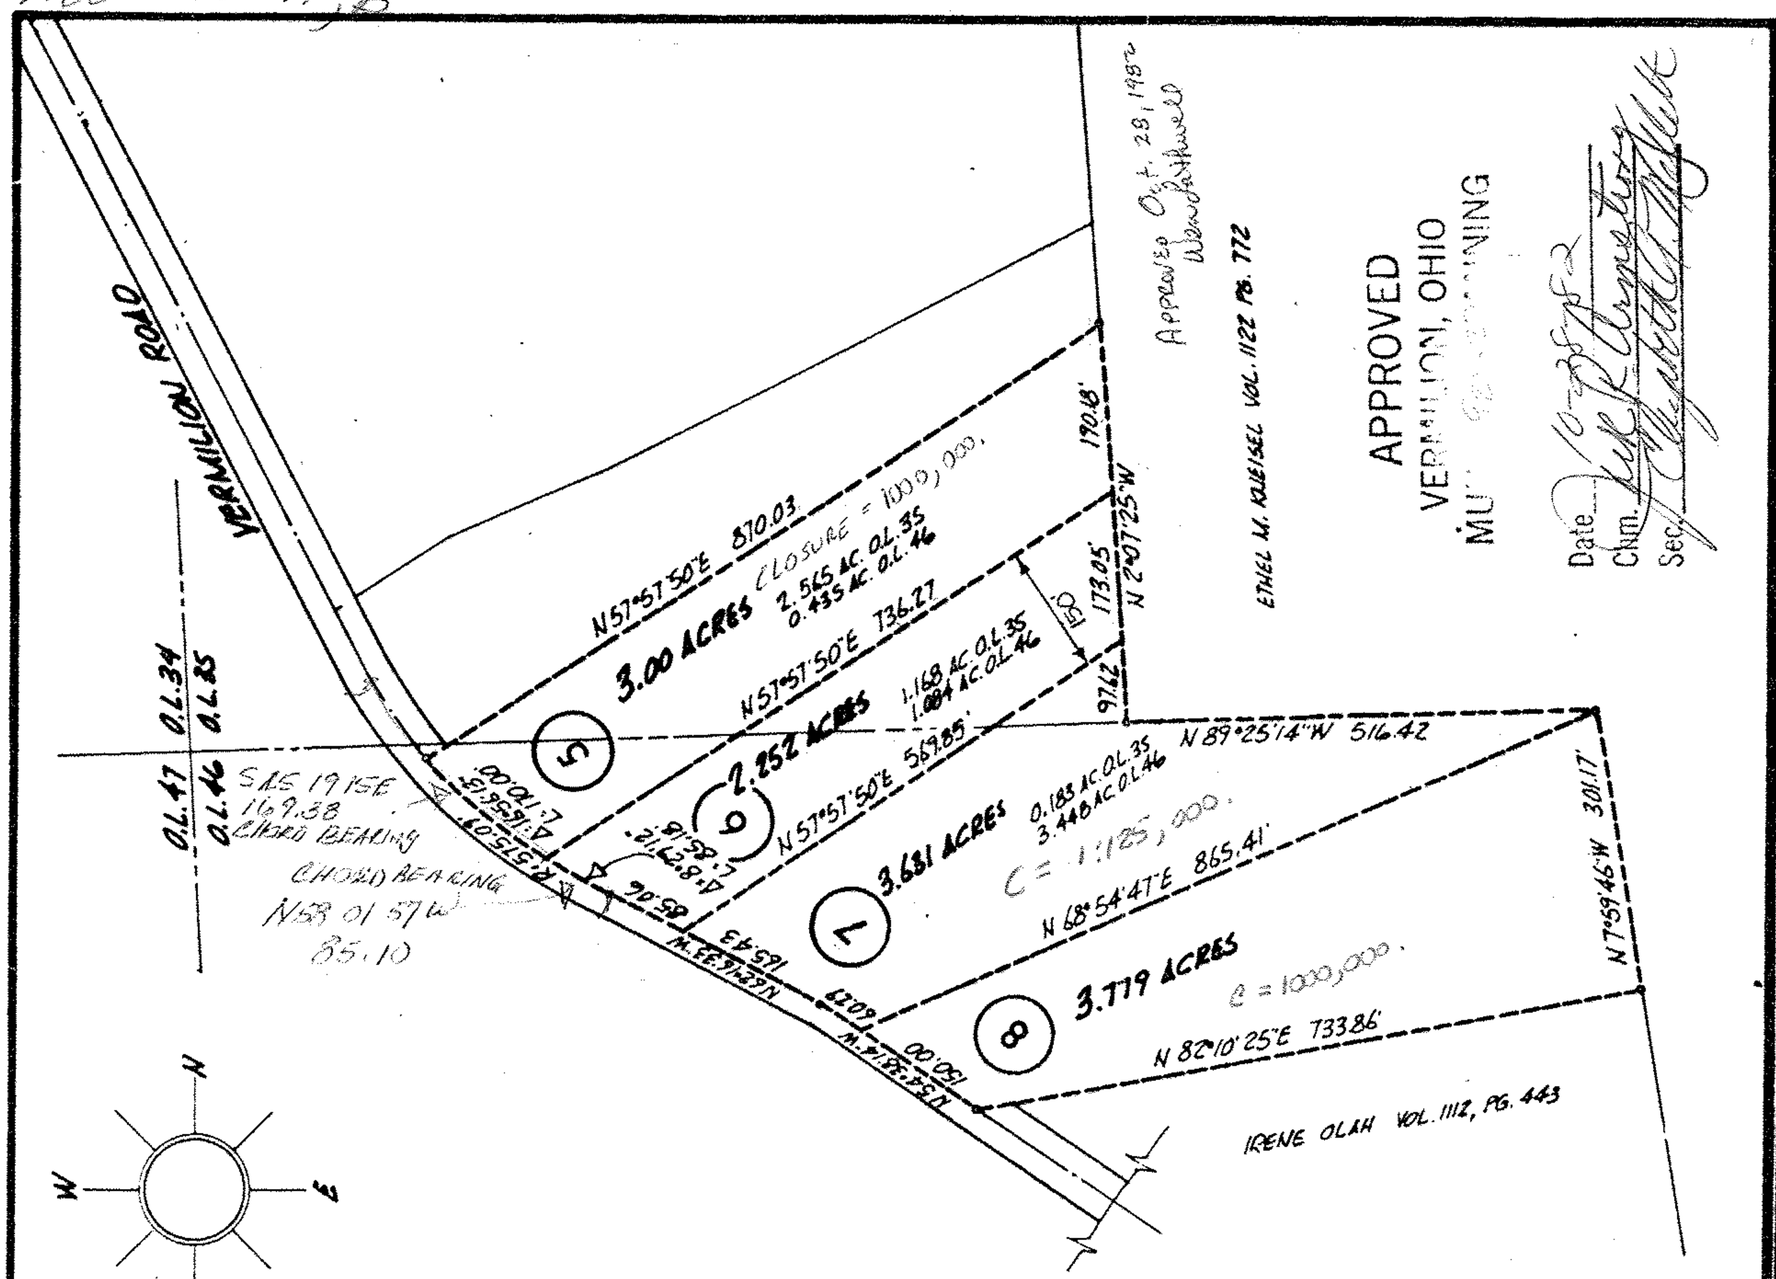

SCALE 1" = 200 FT. | DRAWN MGH

DATE 09-04-82

SITUATED IN THE CITY OF OHIO

ACREAGE 12.662

PREPARED FOR:
MR. JAMES ANADELL

PERMANENT PARCEL NO.
01-00-035-000-041
01-00-046-000-028

Michael G. Hura and Associates
3409 LIBERTY AVENUE VERMILION, OHIO

PERIMETER SURVEY

PART OF O.L. 35 / 46 TR. ____ SECTION ____ OF BROWNHELM Township LORAIN County, Ohio

SUBLOT ____ of ____ VOL. ____ PAGE ____ OF PLATS

#14882

APPROVED
LORAIN CO.
MAP DEPT.
DATE 11-4-82
PAGE 1-00-035-A
1-00-046-A, B
BY C Francis

VOID AFTER