


SCAN #46510

01-00-034-000

1-00-035-A
1-00-046-A

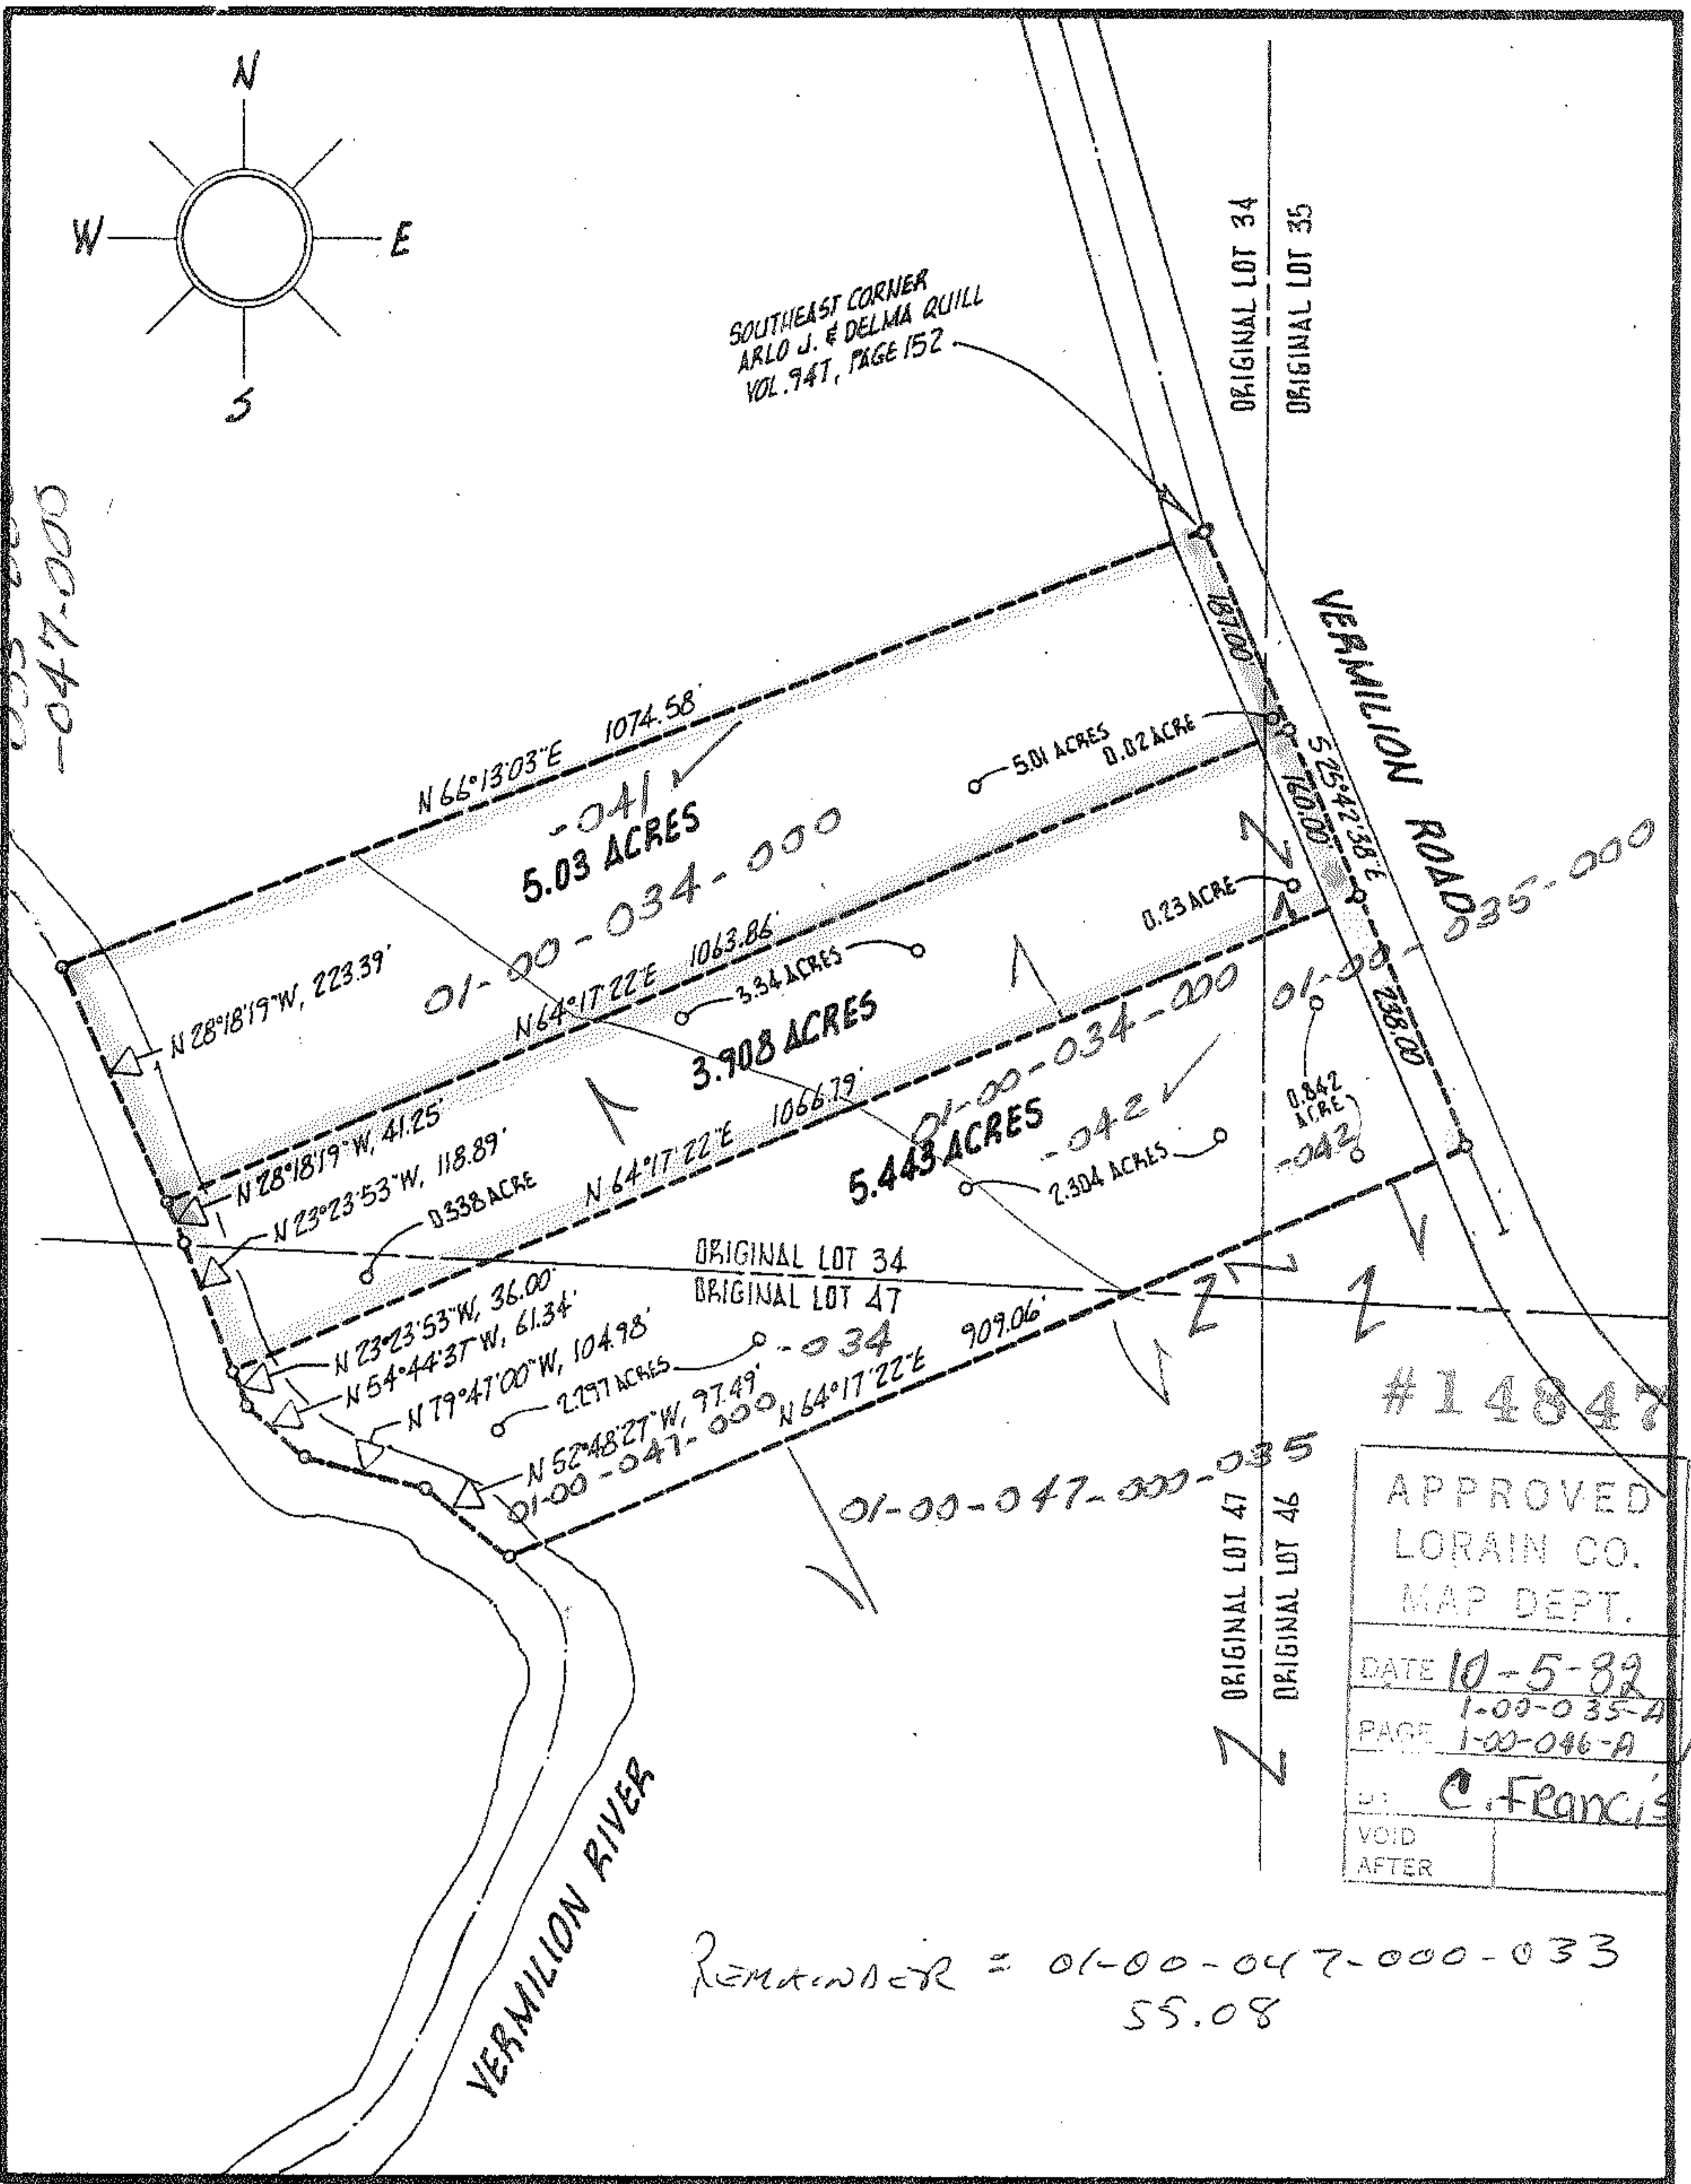

#14847

APPROVED
LORAIN CO.
MAP DEPT.

DATE 10-5-82
1-00-035-A

PAGE 1-00-046-A

C. Francis

VOID
AFTER

REMAINDER = 01-00-047-000-033
55.08

ACREAGE 14.381	DATE 09-27-82	SCALE 1" = 200 FT.	DRAWN MGH
PREPARED FOR:		SITUATED IN THE CITY OF	
		VERMILION OHIO	



Michael G. Hura and Associates
3409 LIBERTY AVENUE VERMILION, OHIO

PERIMETER SURVEY

PART OF O.L. 34, 35 & 47 TR. _____ SECTION _____ OF
BROWNHELM Township LORAIN County, Ohio

SUBLOT _____ of _____
VOL. _____ PAGE _____ OF PLATS

PERMANENT PARCEL NO.