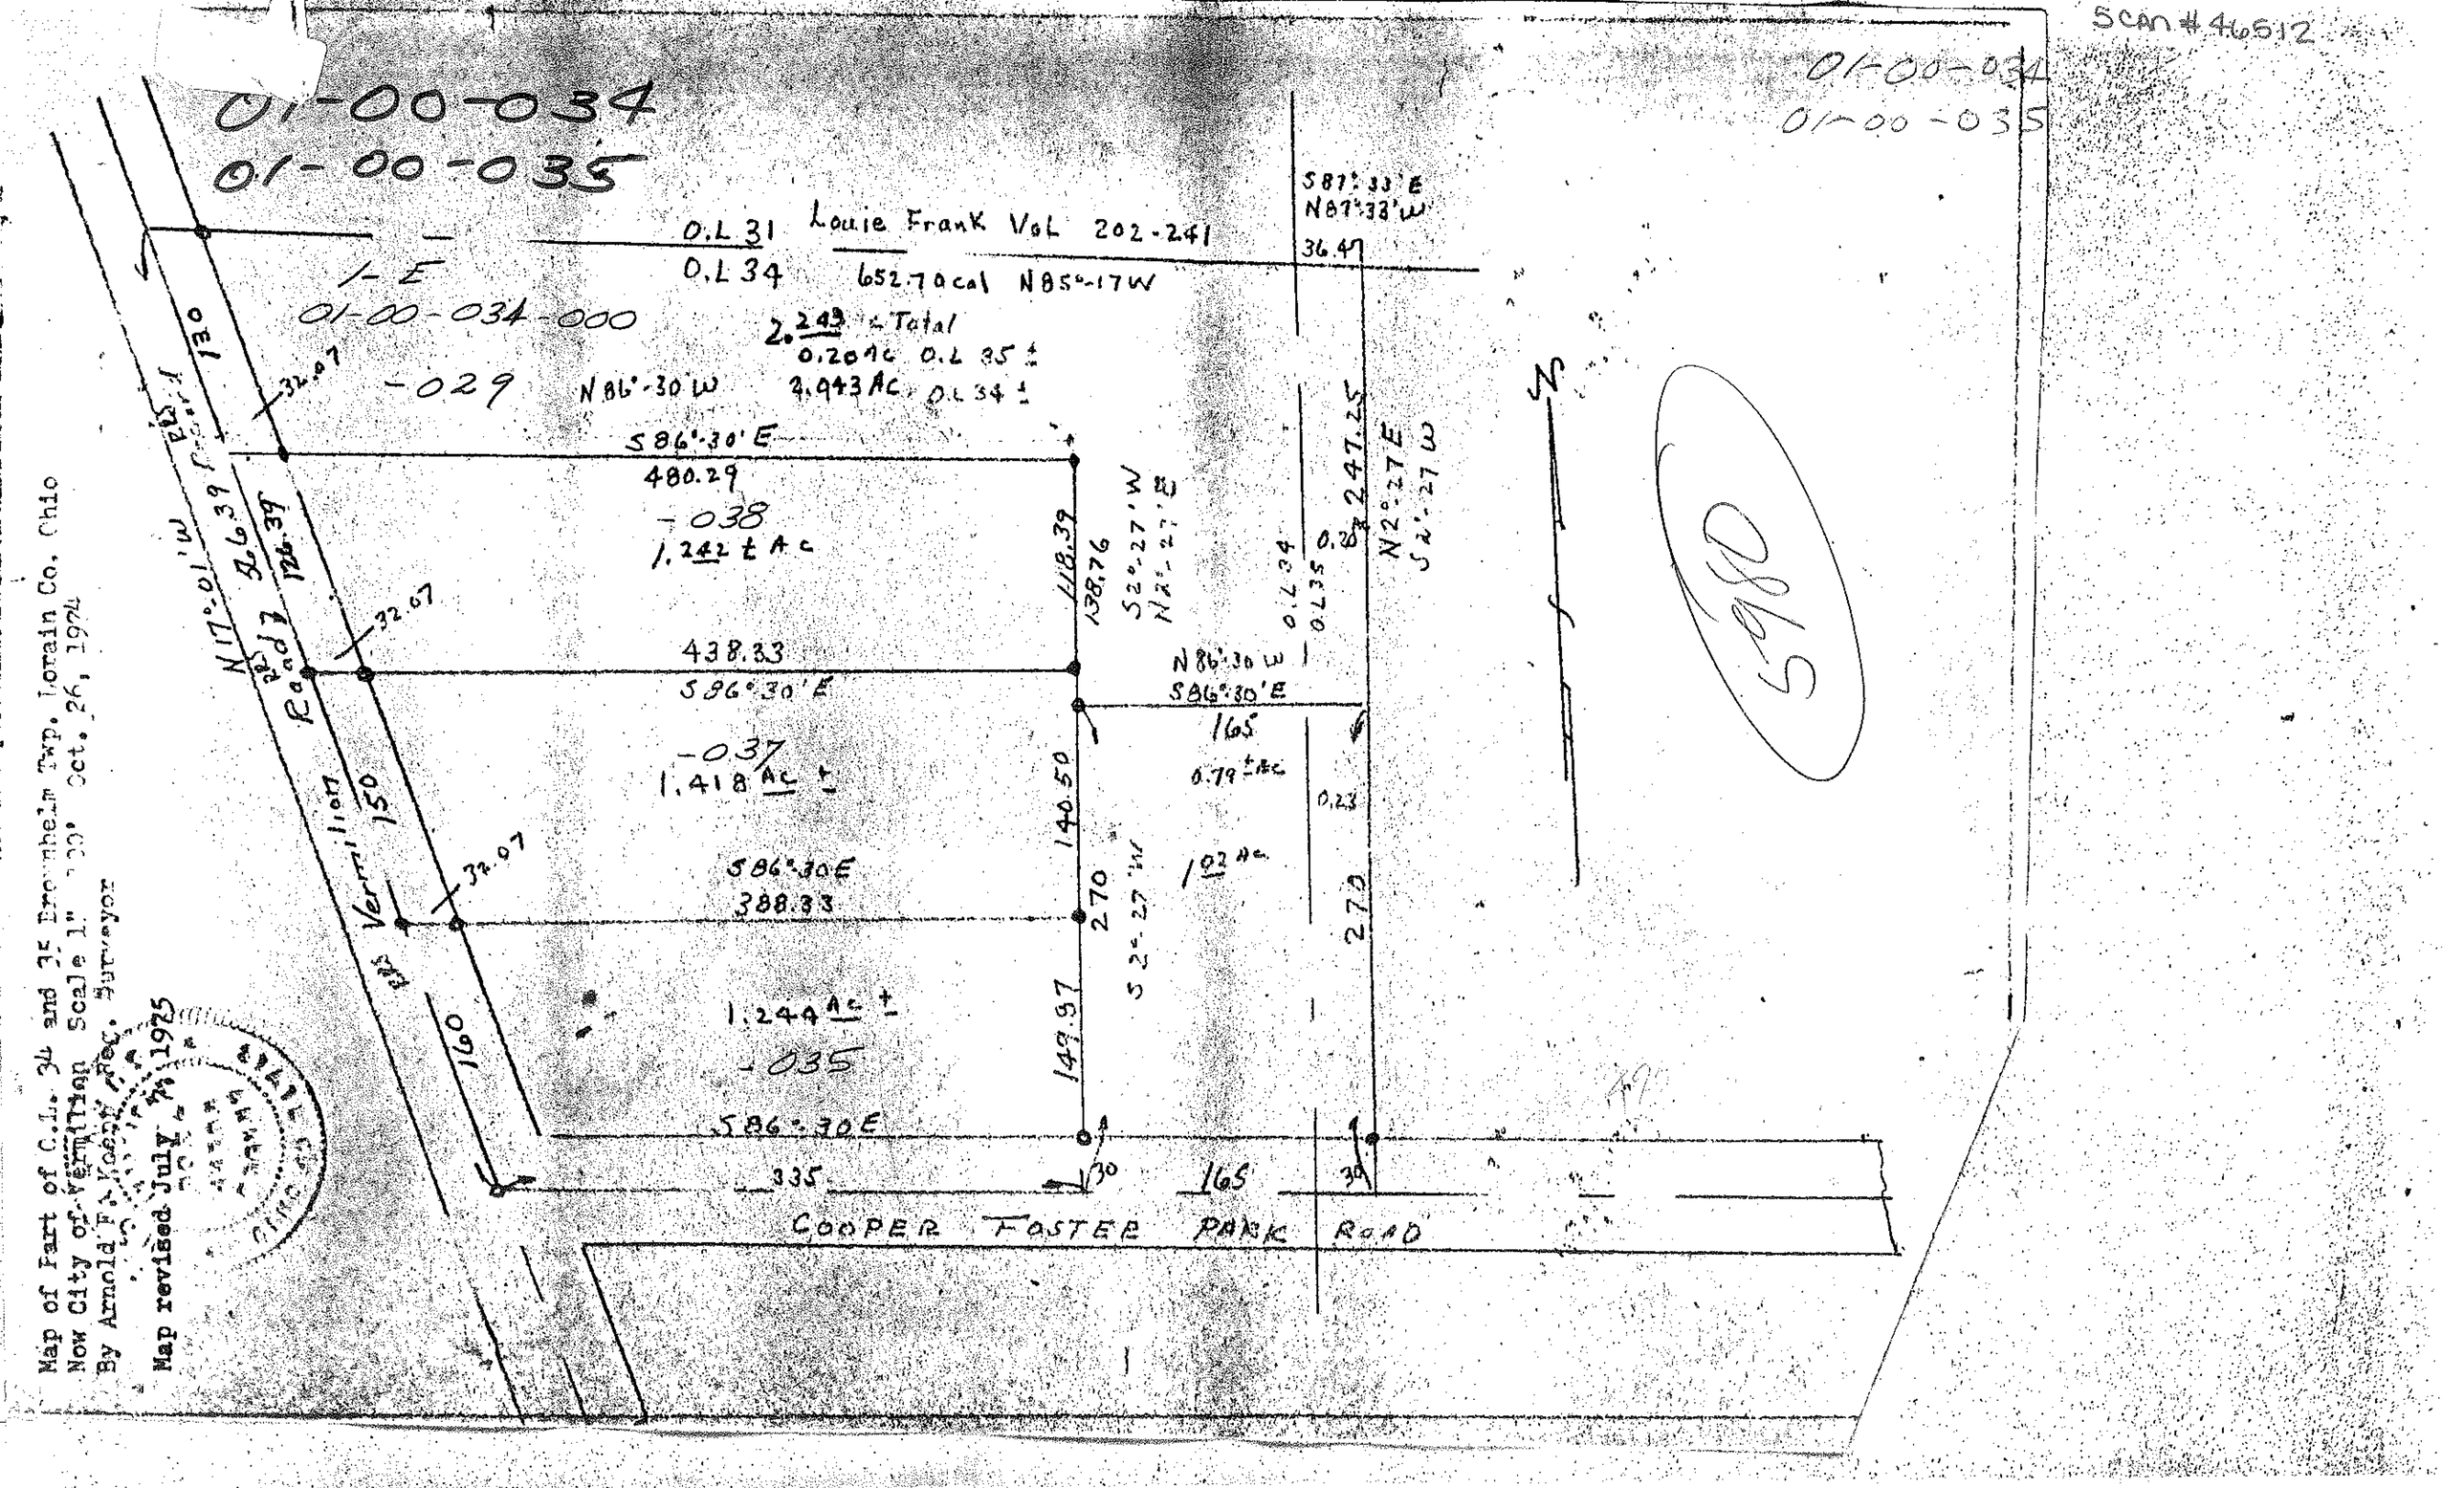

Map of Part of O.L. 34 and 35 Brownhelm Twp. Lorain Co. Ohio
Now City of Vermillion Scale 1" = 100' Oct. 26, 1974
By Arnold F. Koenig Reg. Surveyor
Map revised July 7, 1975