46517

TOTAL AREA = 67.16071 ACRES
TAKE AREA = 57.60813
REMAINDER = 9.46258

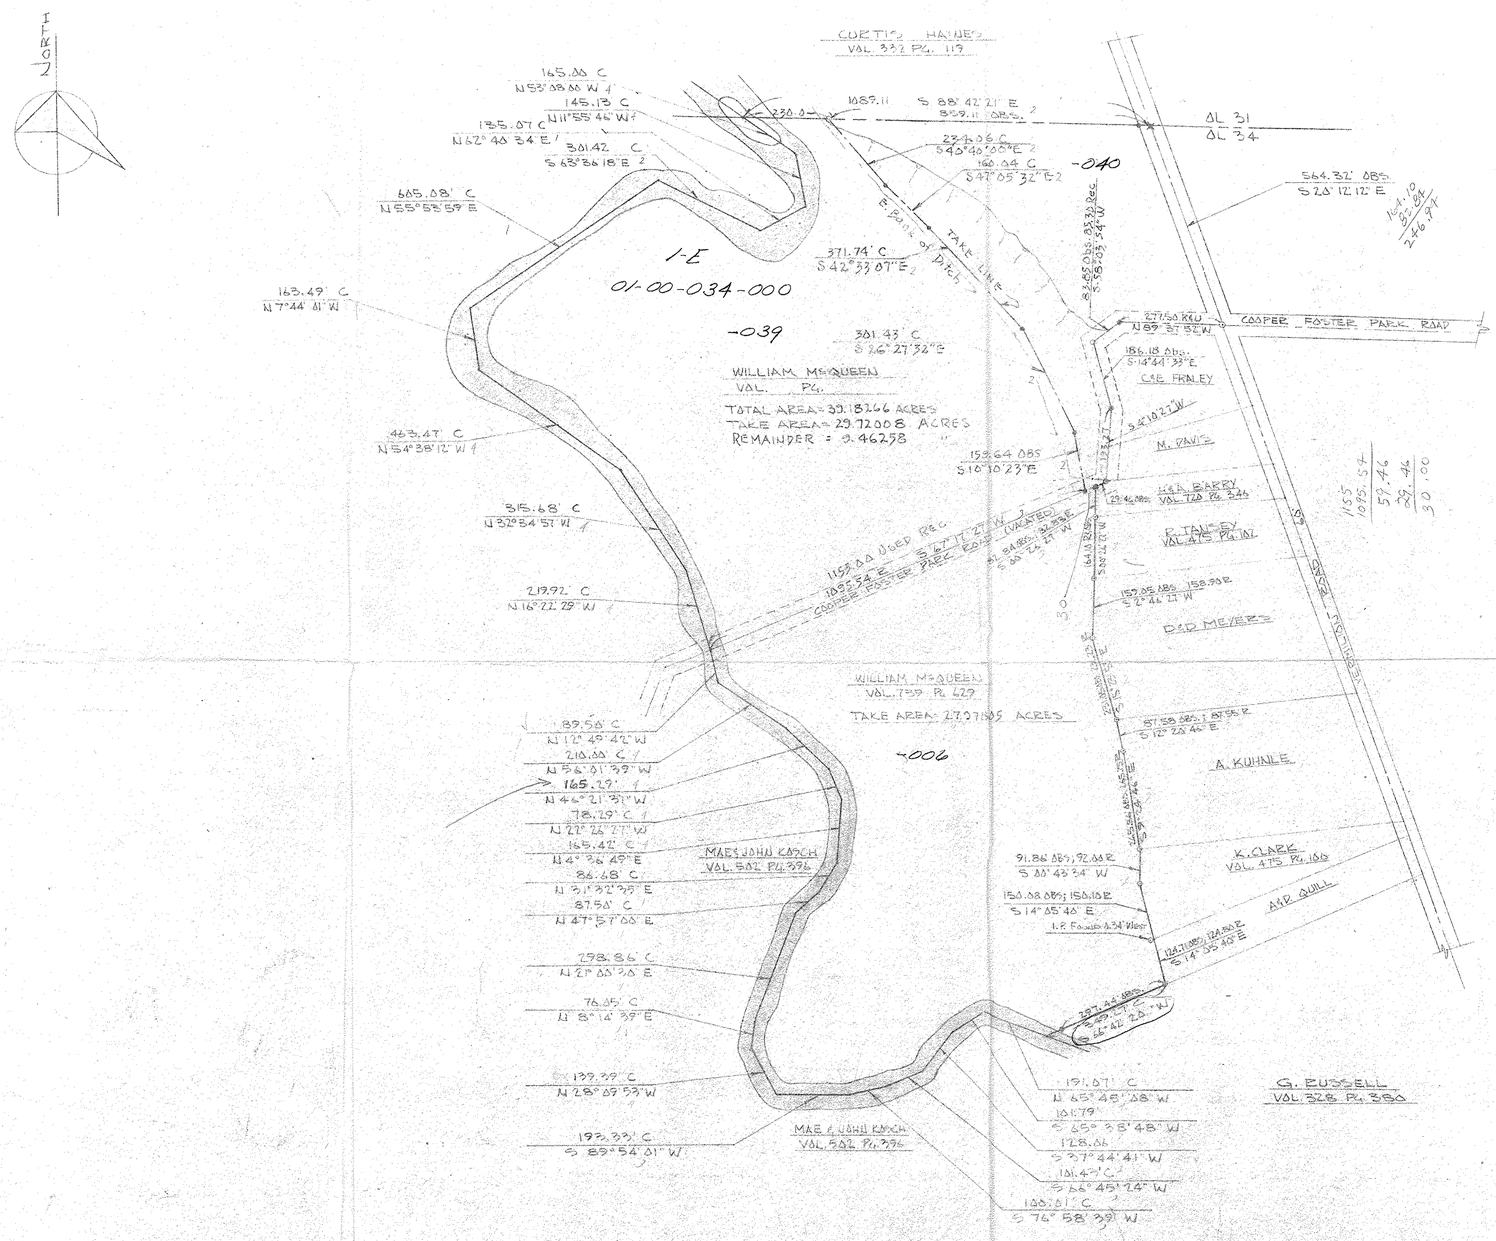

10697
1E
1-00-034

RECEIVED
OCT 4 1976
LORAIN COUNTY
AUDITOR

STATE OF OHIO
JOHN L. MENO
3662
REGISTERED
SURVEYOR

LEGEND
IRON PIN FOUND
IRON PIN SET
NAIL SET
RECORD
OBSERVED
MEASURED
USED
CALCULATED

REVISED TAKE LINE - 5-27-76
REVISED TAKE LINE 6-22-76

LORAIN COUNTY METROPOLITAN PARK DISTRICT
LAND ACQUISITION SURVEY
WILLIAM McQUEEN PROPERTY
BROWNHELM TOWNSHIP

Enviro Tech Consultants
ENGINEERS • SURVEYORS • LAND PLANNERS
4055 OBERLIN AVENUE
LORAIN, OHIO 44053

VRV
10

ORIGINAL LOT	34	DATE	3-28-73
TOWNSHIP	BROWNHELM	SCALE	1"=200'
CITY OF	VERMILION	FIELD BOOK	220 PG. 52-53
COUNTY OF	LORAIN	DRAWN BY	JFR
STATE OF	OHIO	CHECKED BY	JLM
W. O.	51091	FILE NO.	1-00-34