


9-00-075-110-010
9-00-075-B
Scan # 46552

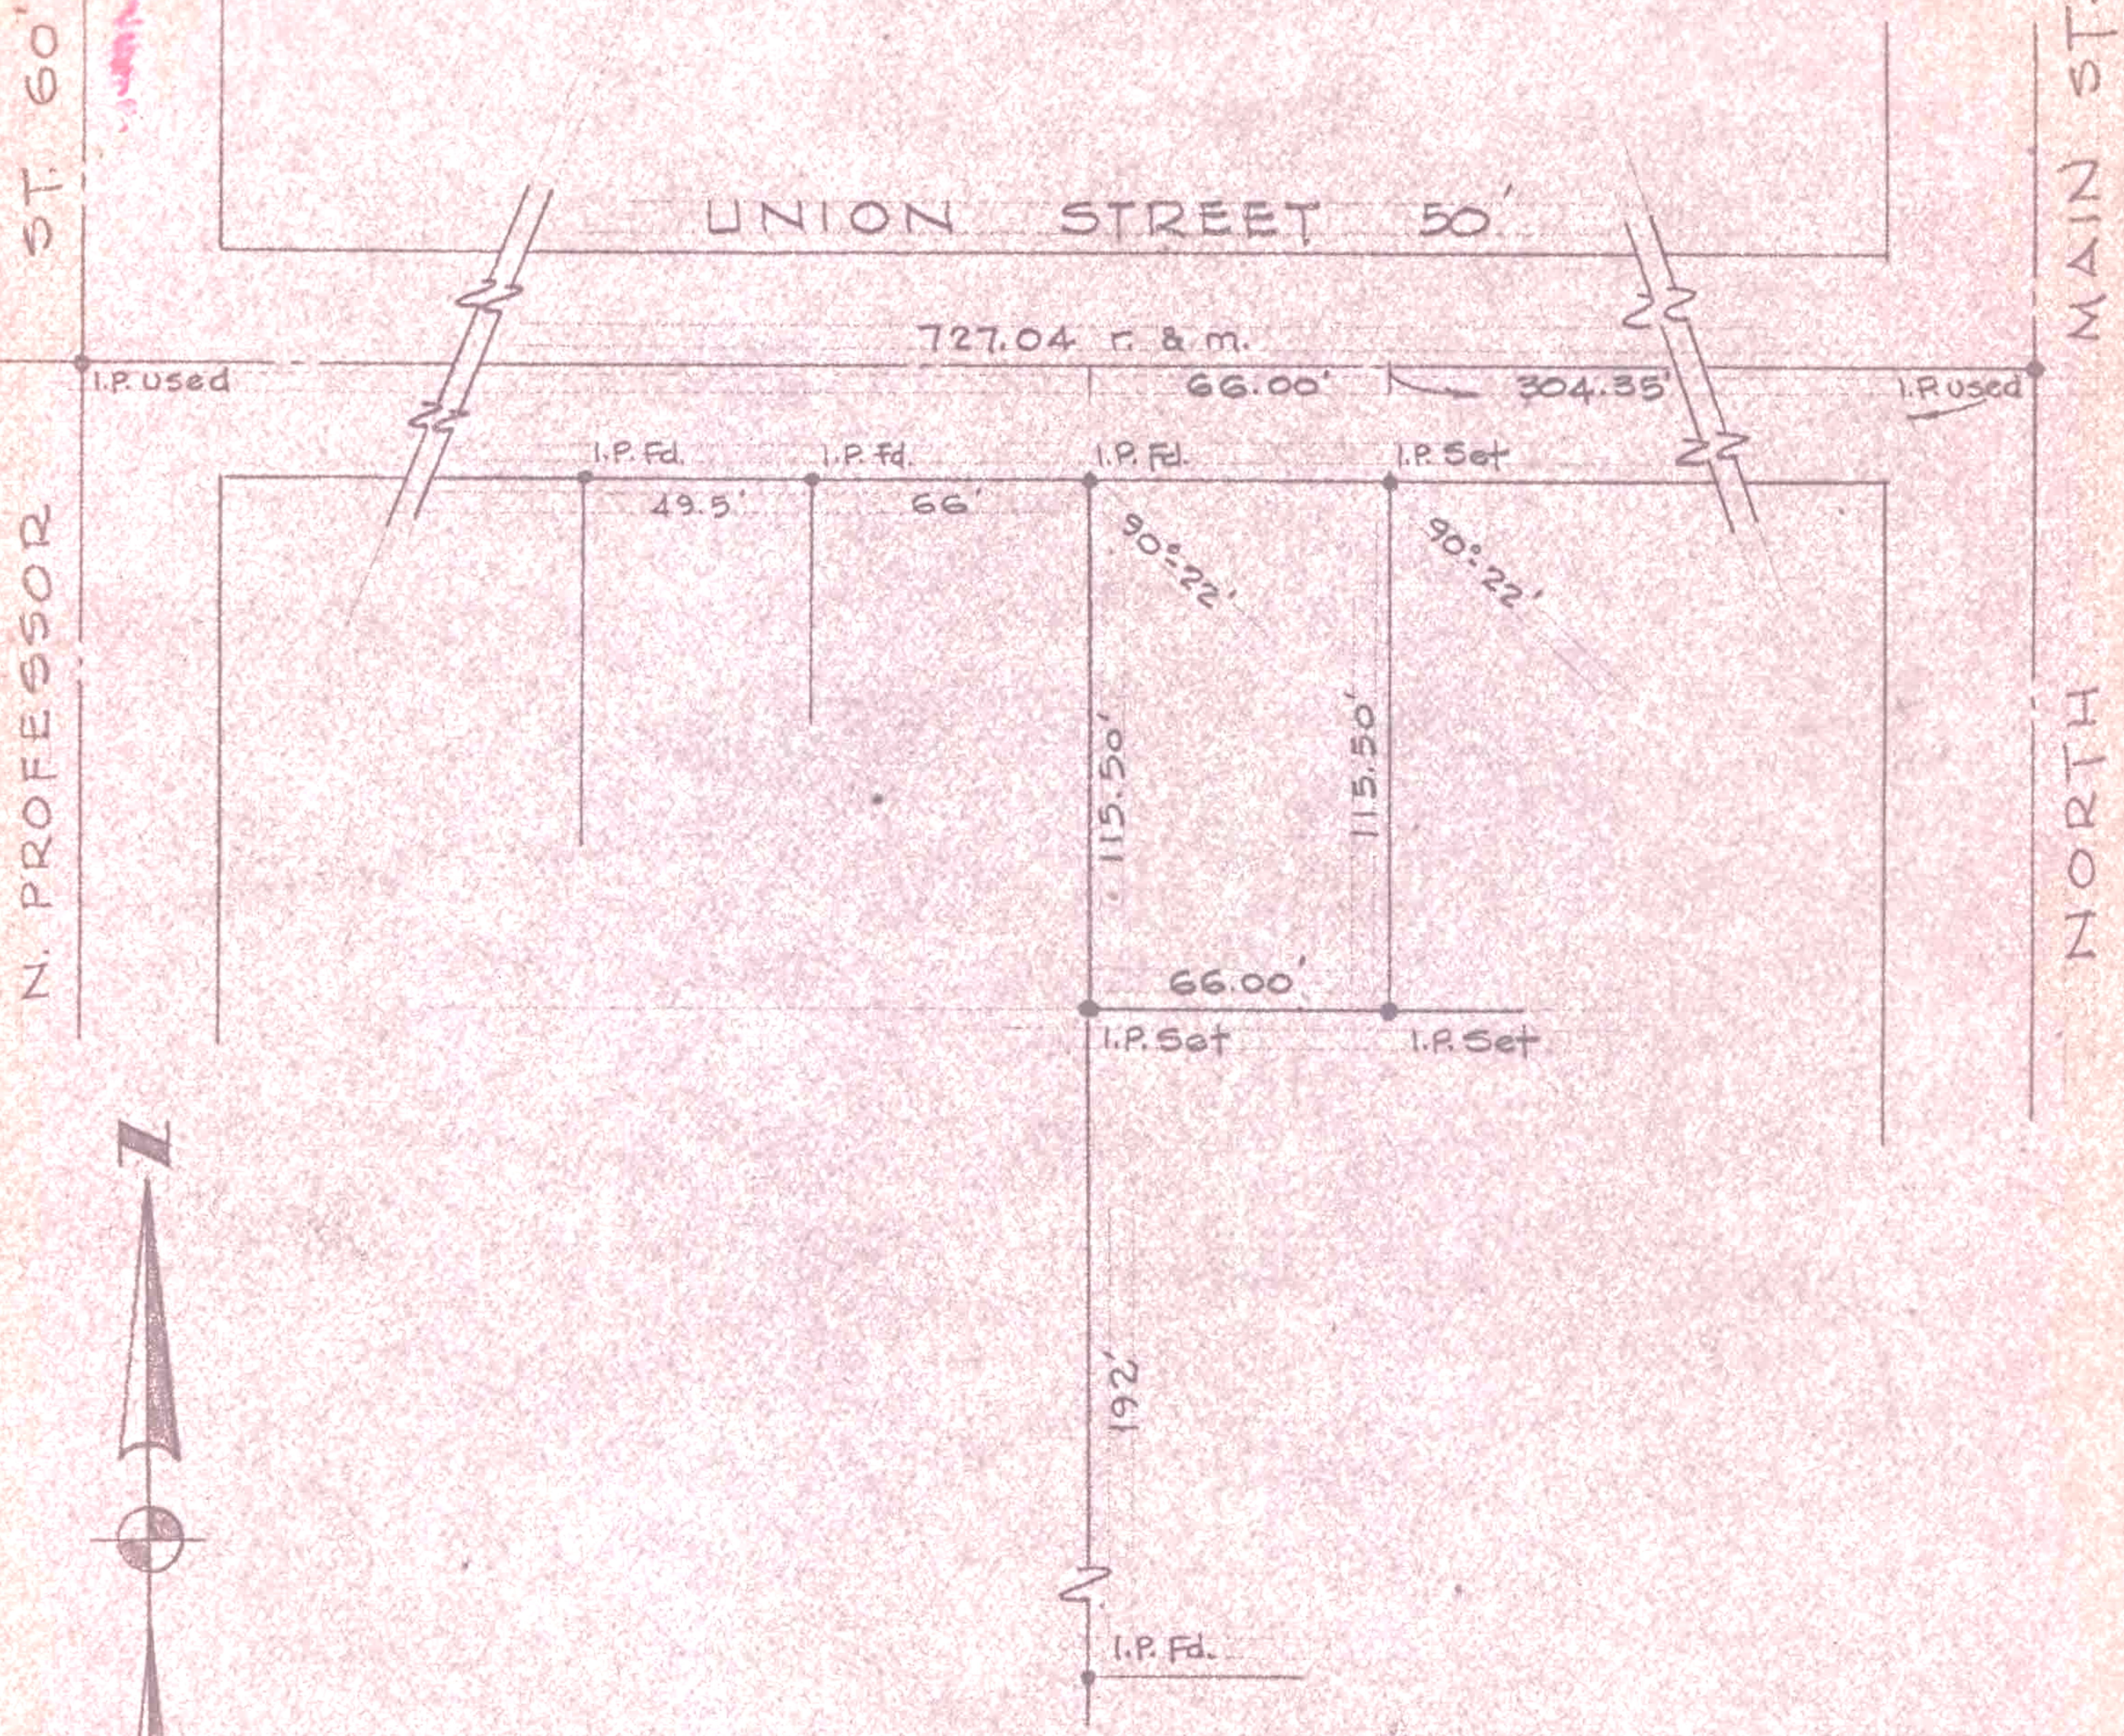

SURVEY FOR A. H. CLARK

PART OF O.V.P. 49 P.V. 5 PAGE 31
 O.L. 75 RUSSIA TWP. LORAIN COUNTY OHIO
 CITY OF OBERLIN - 1"=60' - OCT. 1974
 LAUNDON • SIMON • CAHL & ASSOC.
 ENGINEERS SURVEYORS