


9-00-077-102-001  
 9-00-077-102-002  
 9-00-077-102-005  
 9-00-077-102-007  
 9-00-077-102-008  
 9-00-077-8  
 SCAN# 46563

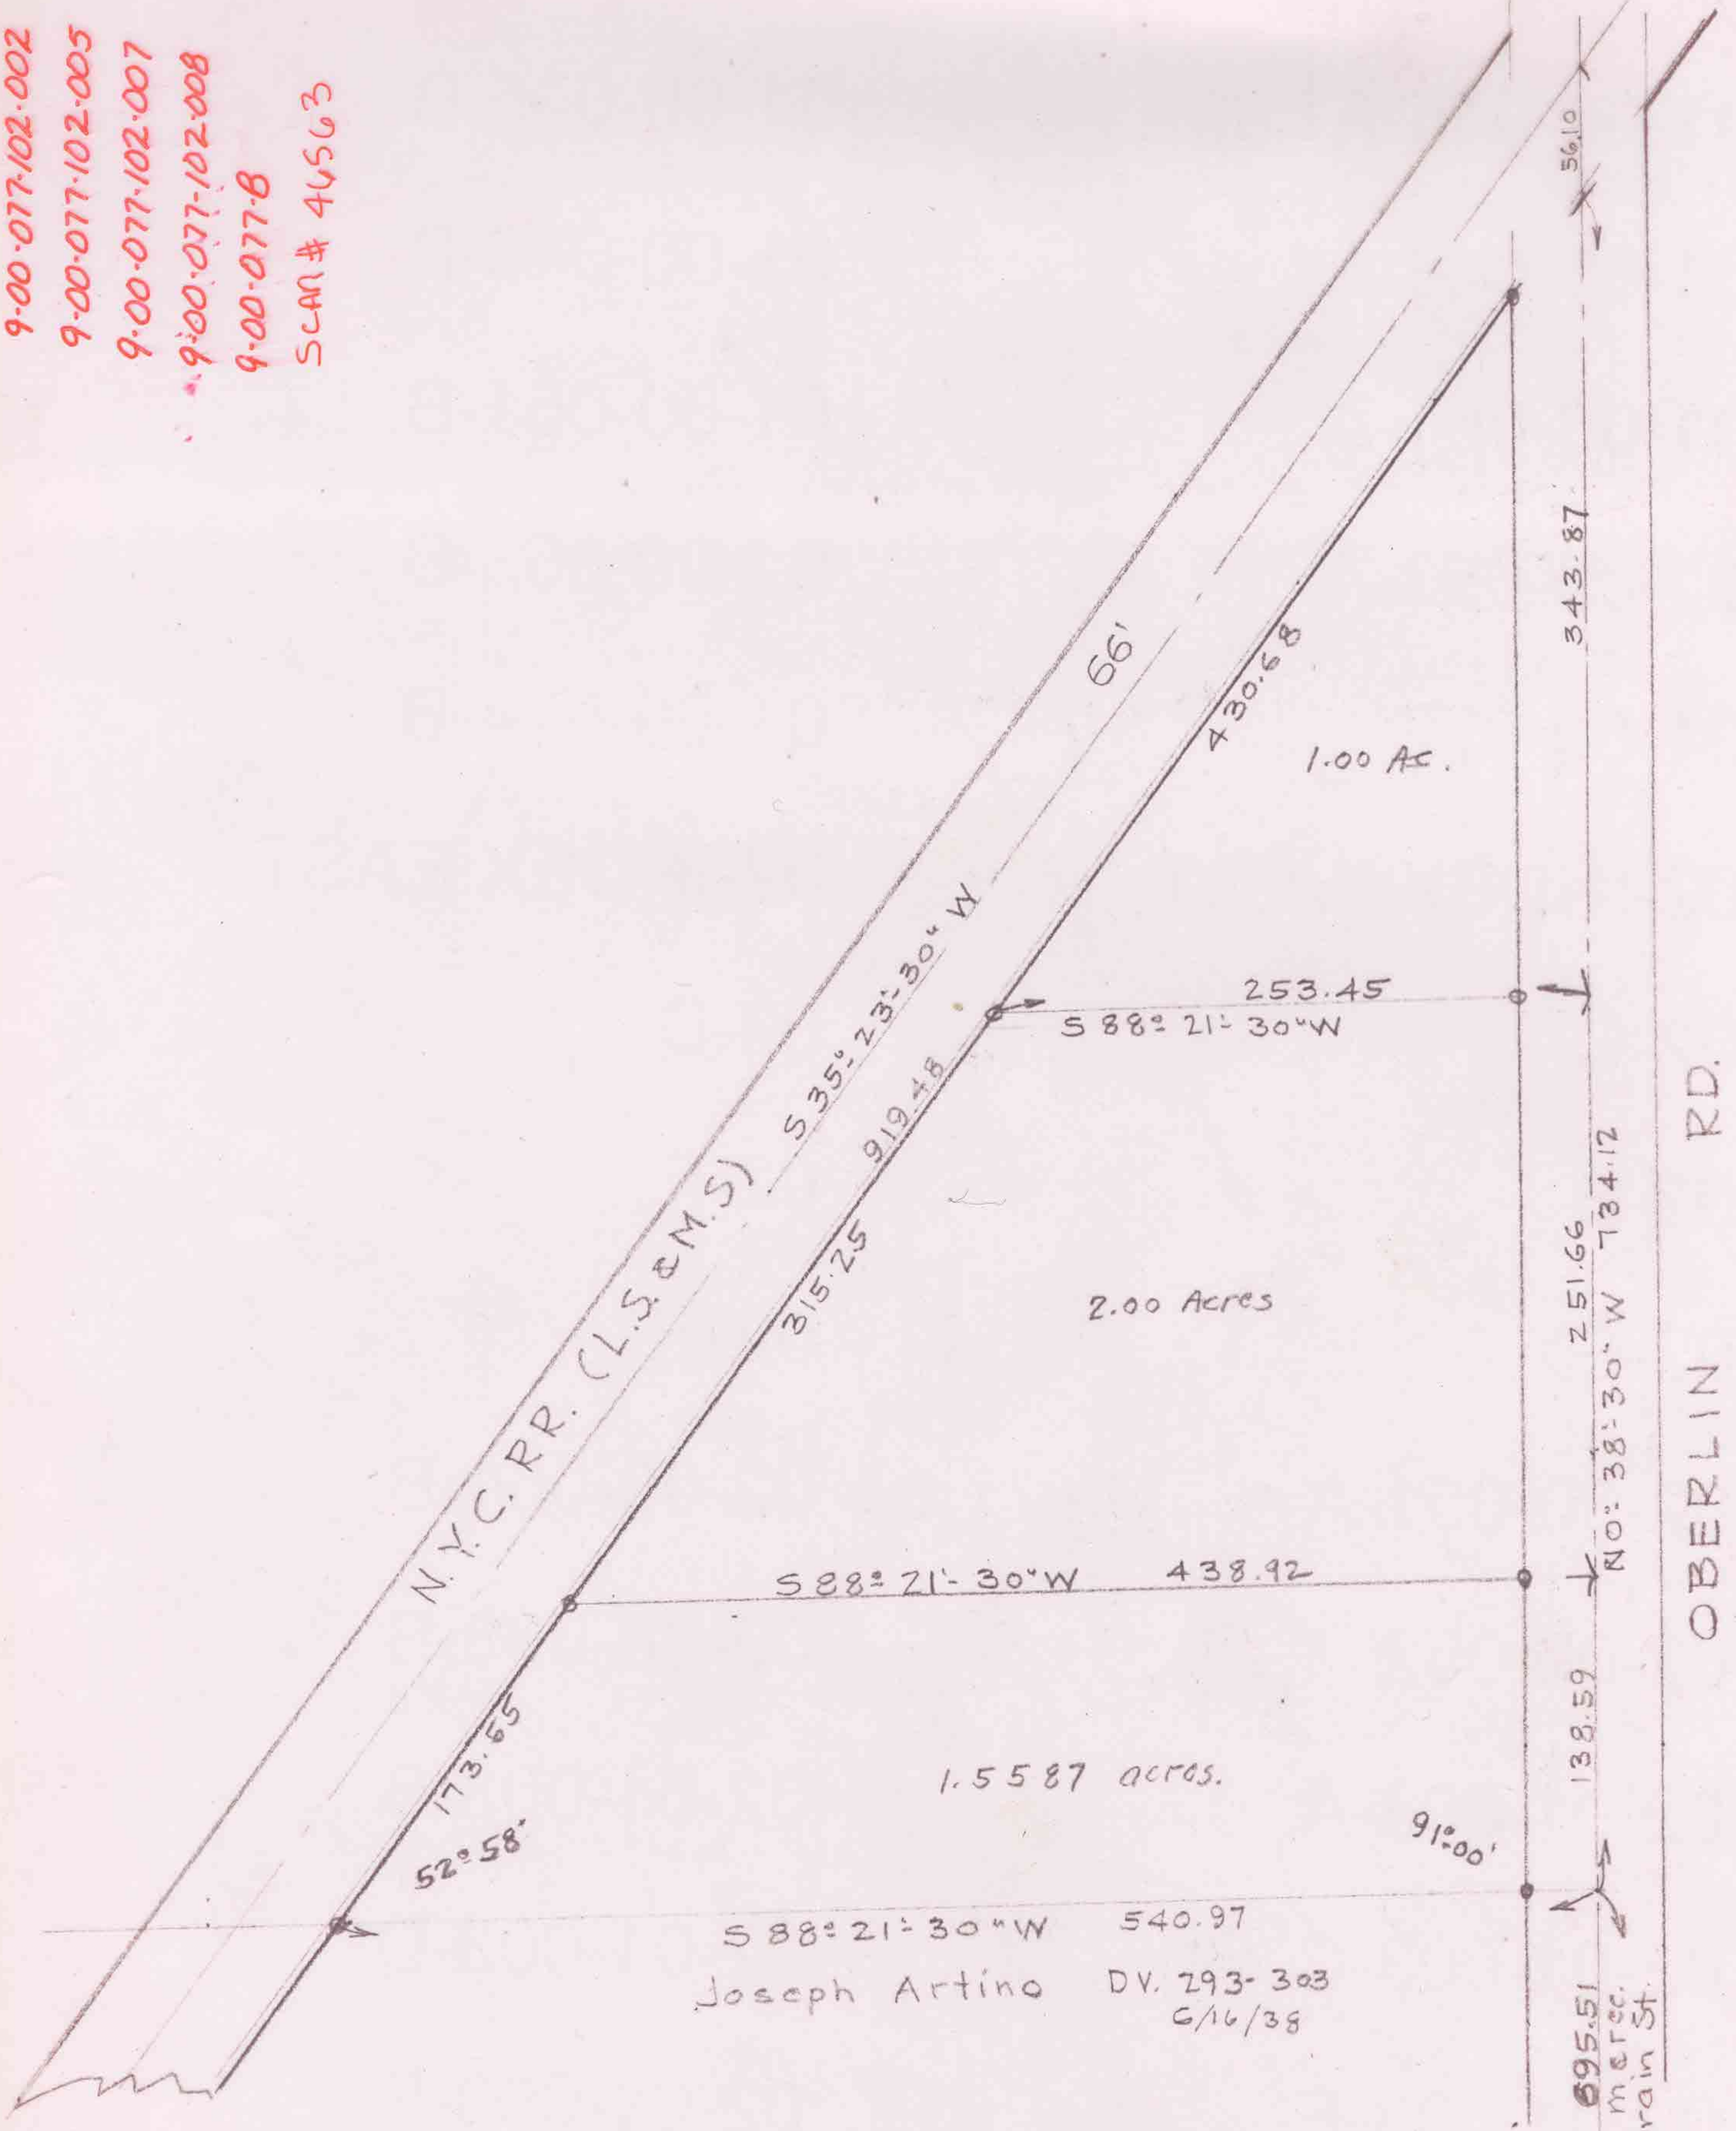

OBERLIN RD.

Joseph Artino DV. 293-303  
 6/16/38

Francis. E. & Jessie M. Wooldridge  
 O.L. 77 Russia Tp. City of Oberlin  
 Lorain Co. Ohio. Scale 1"=100'  
 Sept. 4. 1953 T.W. Laundon Reg. Surveyor