9-00-085-101-03
9-00-085-A
Scan #46574

LAUNDON - HUFFMAN - SIMON
CIVIL ENGINEERS - SURVEYORS
517 Broad St. Elyria, Ohio

Thomas W. Laundon, P.E.
David C. Huffman, P.E.
Rodger G. Simon, R.S.

Municipal Engineering
Subdivisions
Land Surveys

W. LORAIN ST 66'

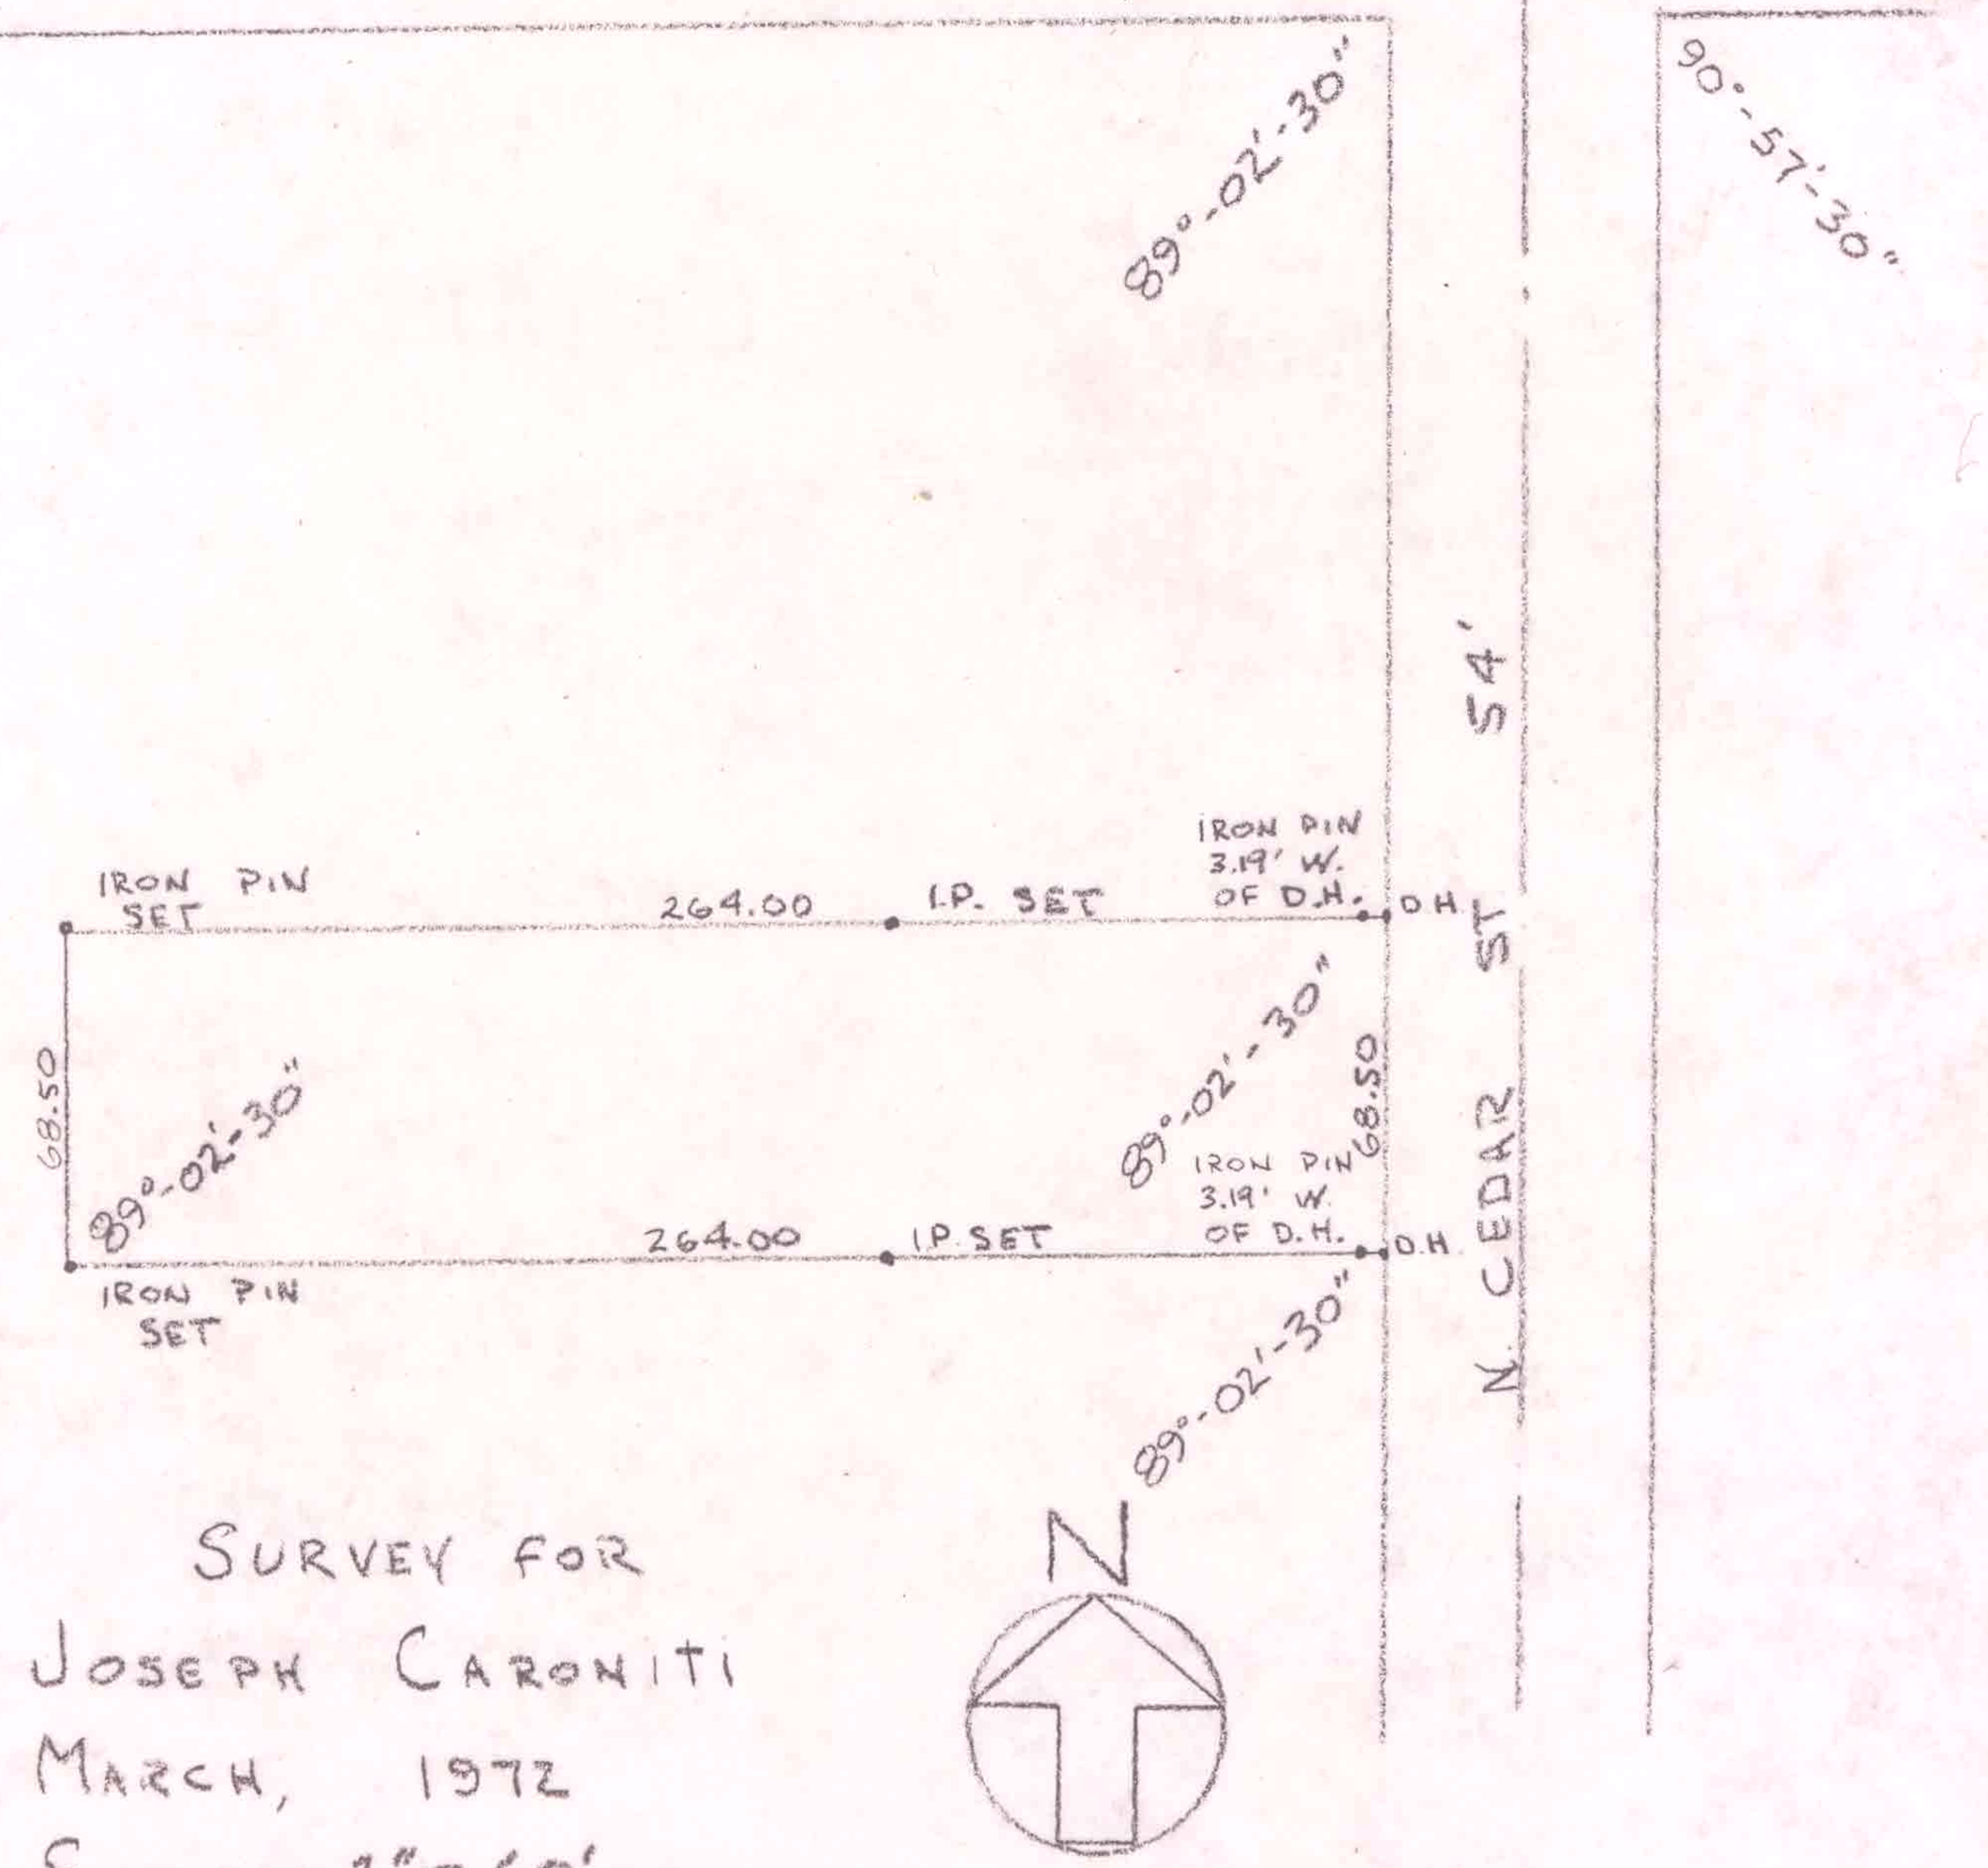

SURVEY FOR
JOSEPH CARONITI
MARCH, 1972
SCALE: 1" = 60'