


SCAN # 46580

9-00-085-104-023

9-00-085-104-024

9-00-085-A

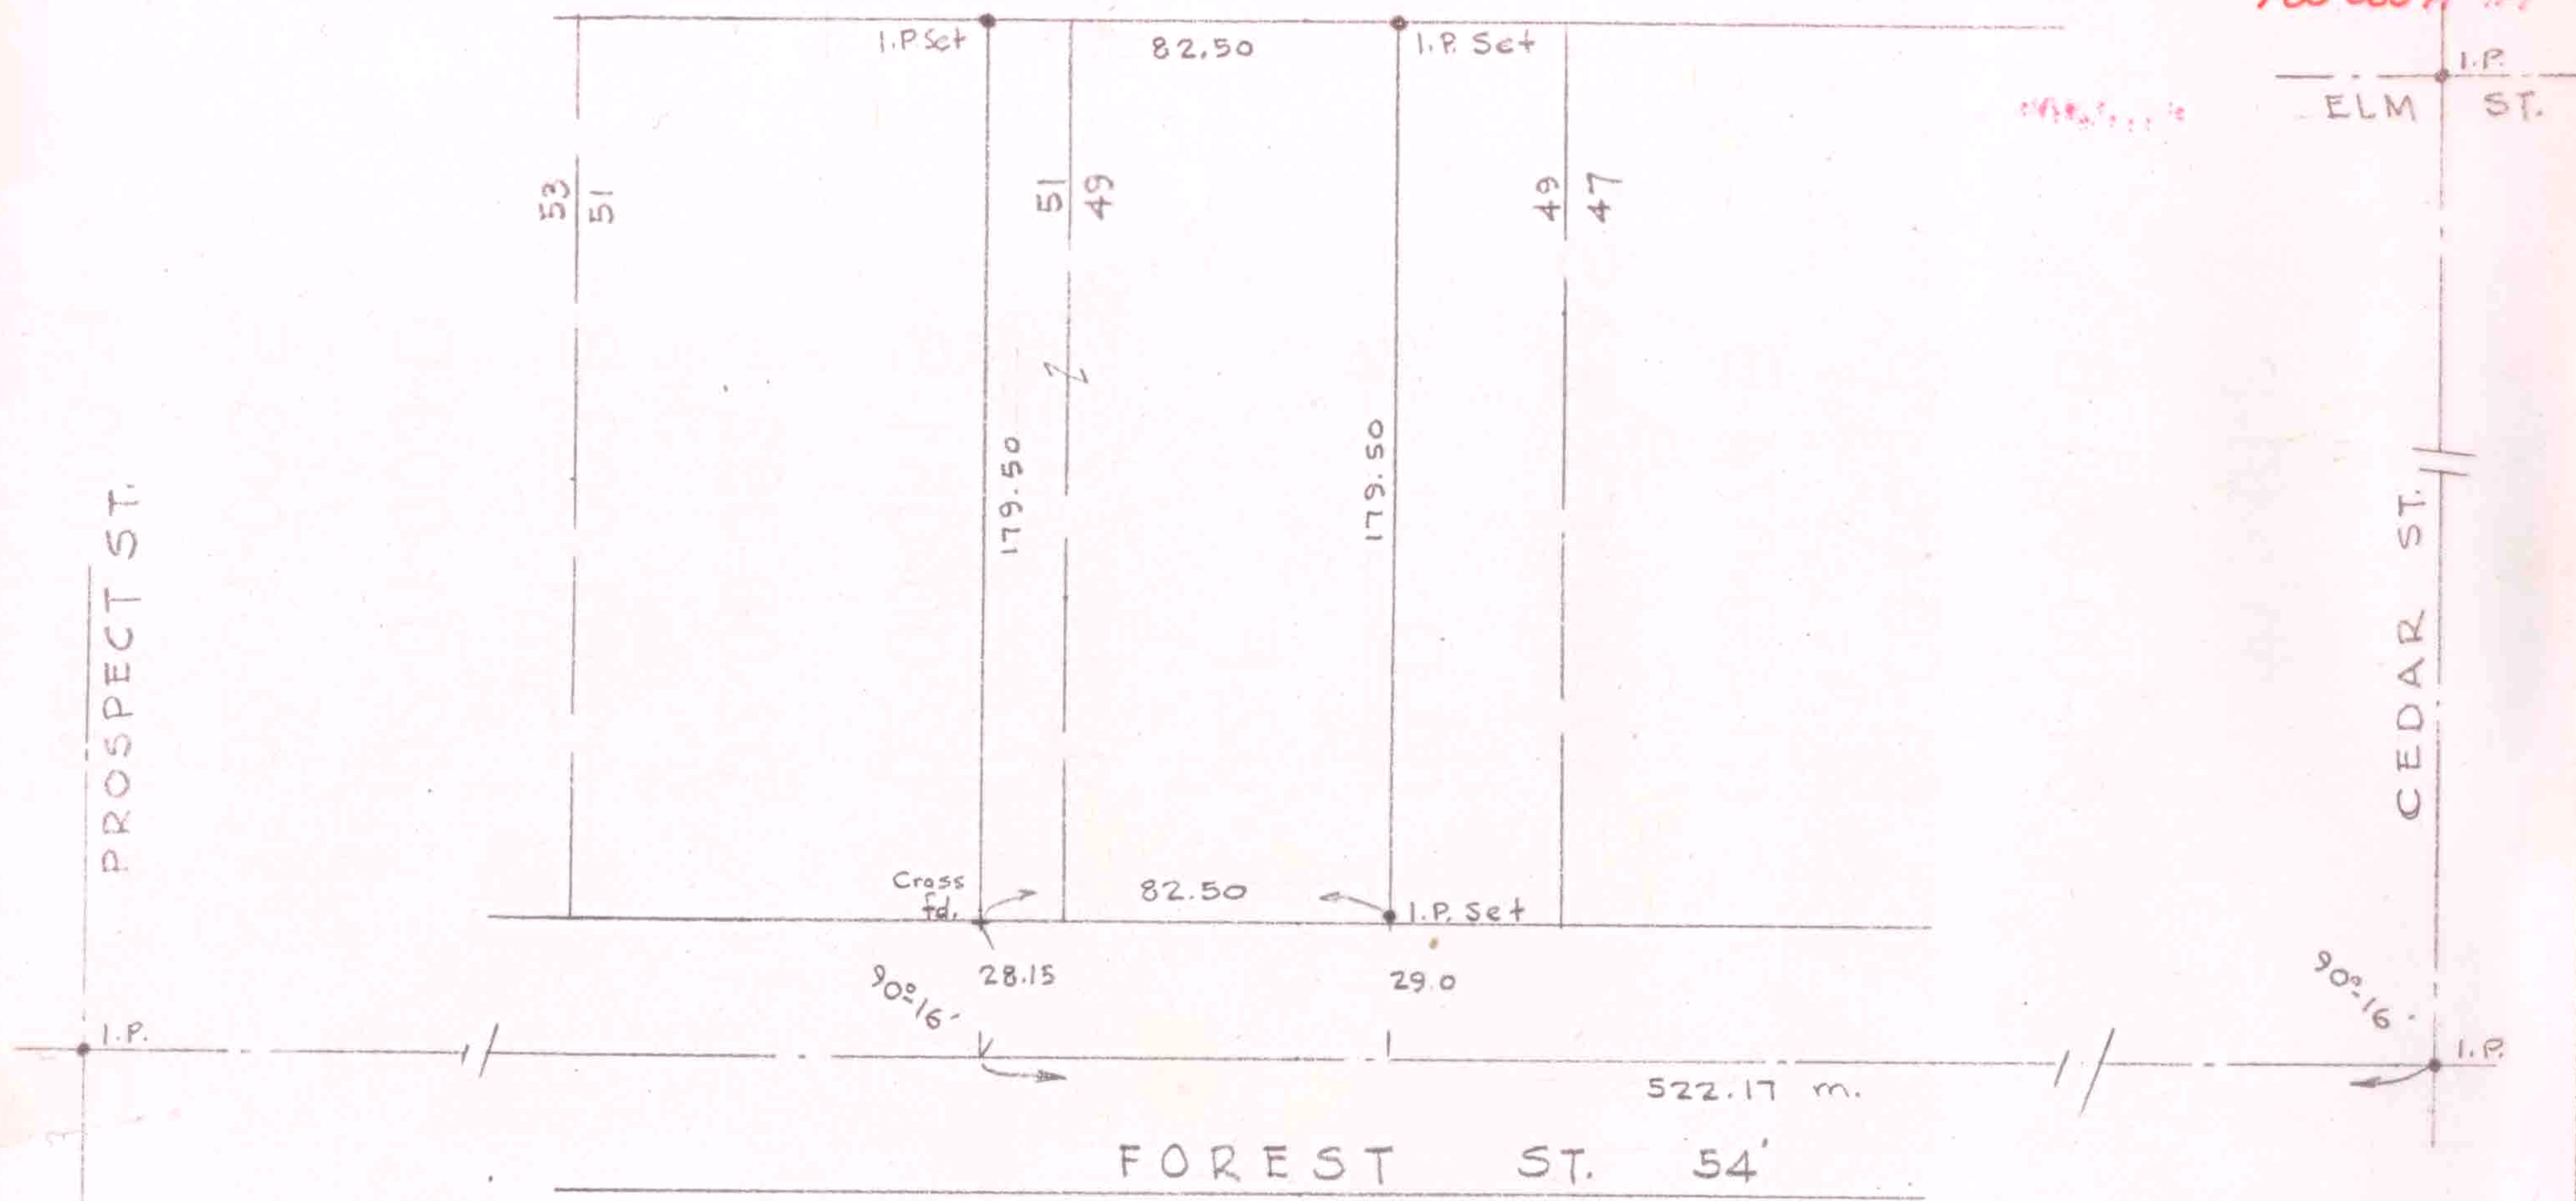

SURVEY FOR MRS. RUTH YOCOM
 PARTS OF S/L's 49 & 51 W. W. WRIGHT'S ADD'N.
 O.L. 85 RUSSIA TWP. OBERLIN CITY
 LORAIN COUNTY OHIO
 SCALE 1" = 50' MAY, 1965
 LAUNDON, HUFFMAN & SIMON - SURVEYORS