9-00-085-105-022
9-00-085-105-023
9-00-085-105-024
9-00-085-A

Scan #46581

...te of Ohio
...red Professional
...er and Surveyor

...e Home 2094
Office 3211

THOMAS W. LAUNDON

CIVIL ENGINEER AND SURVEYOR
405 Elyria Building
ELYRIA - OHIO

Municipal Engineering
Surveys - City, Farm,
Sub-divisions

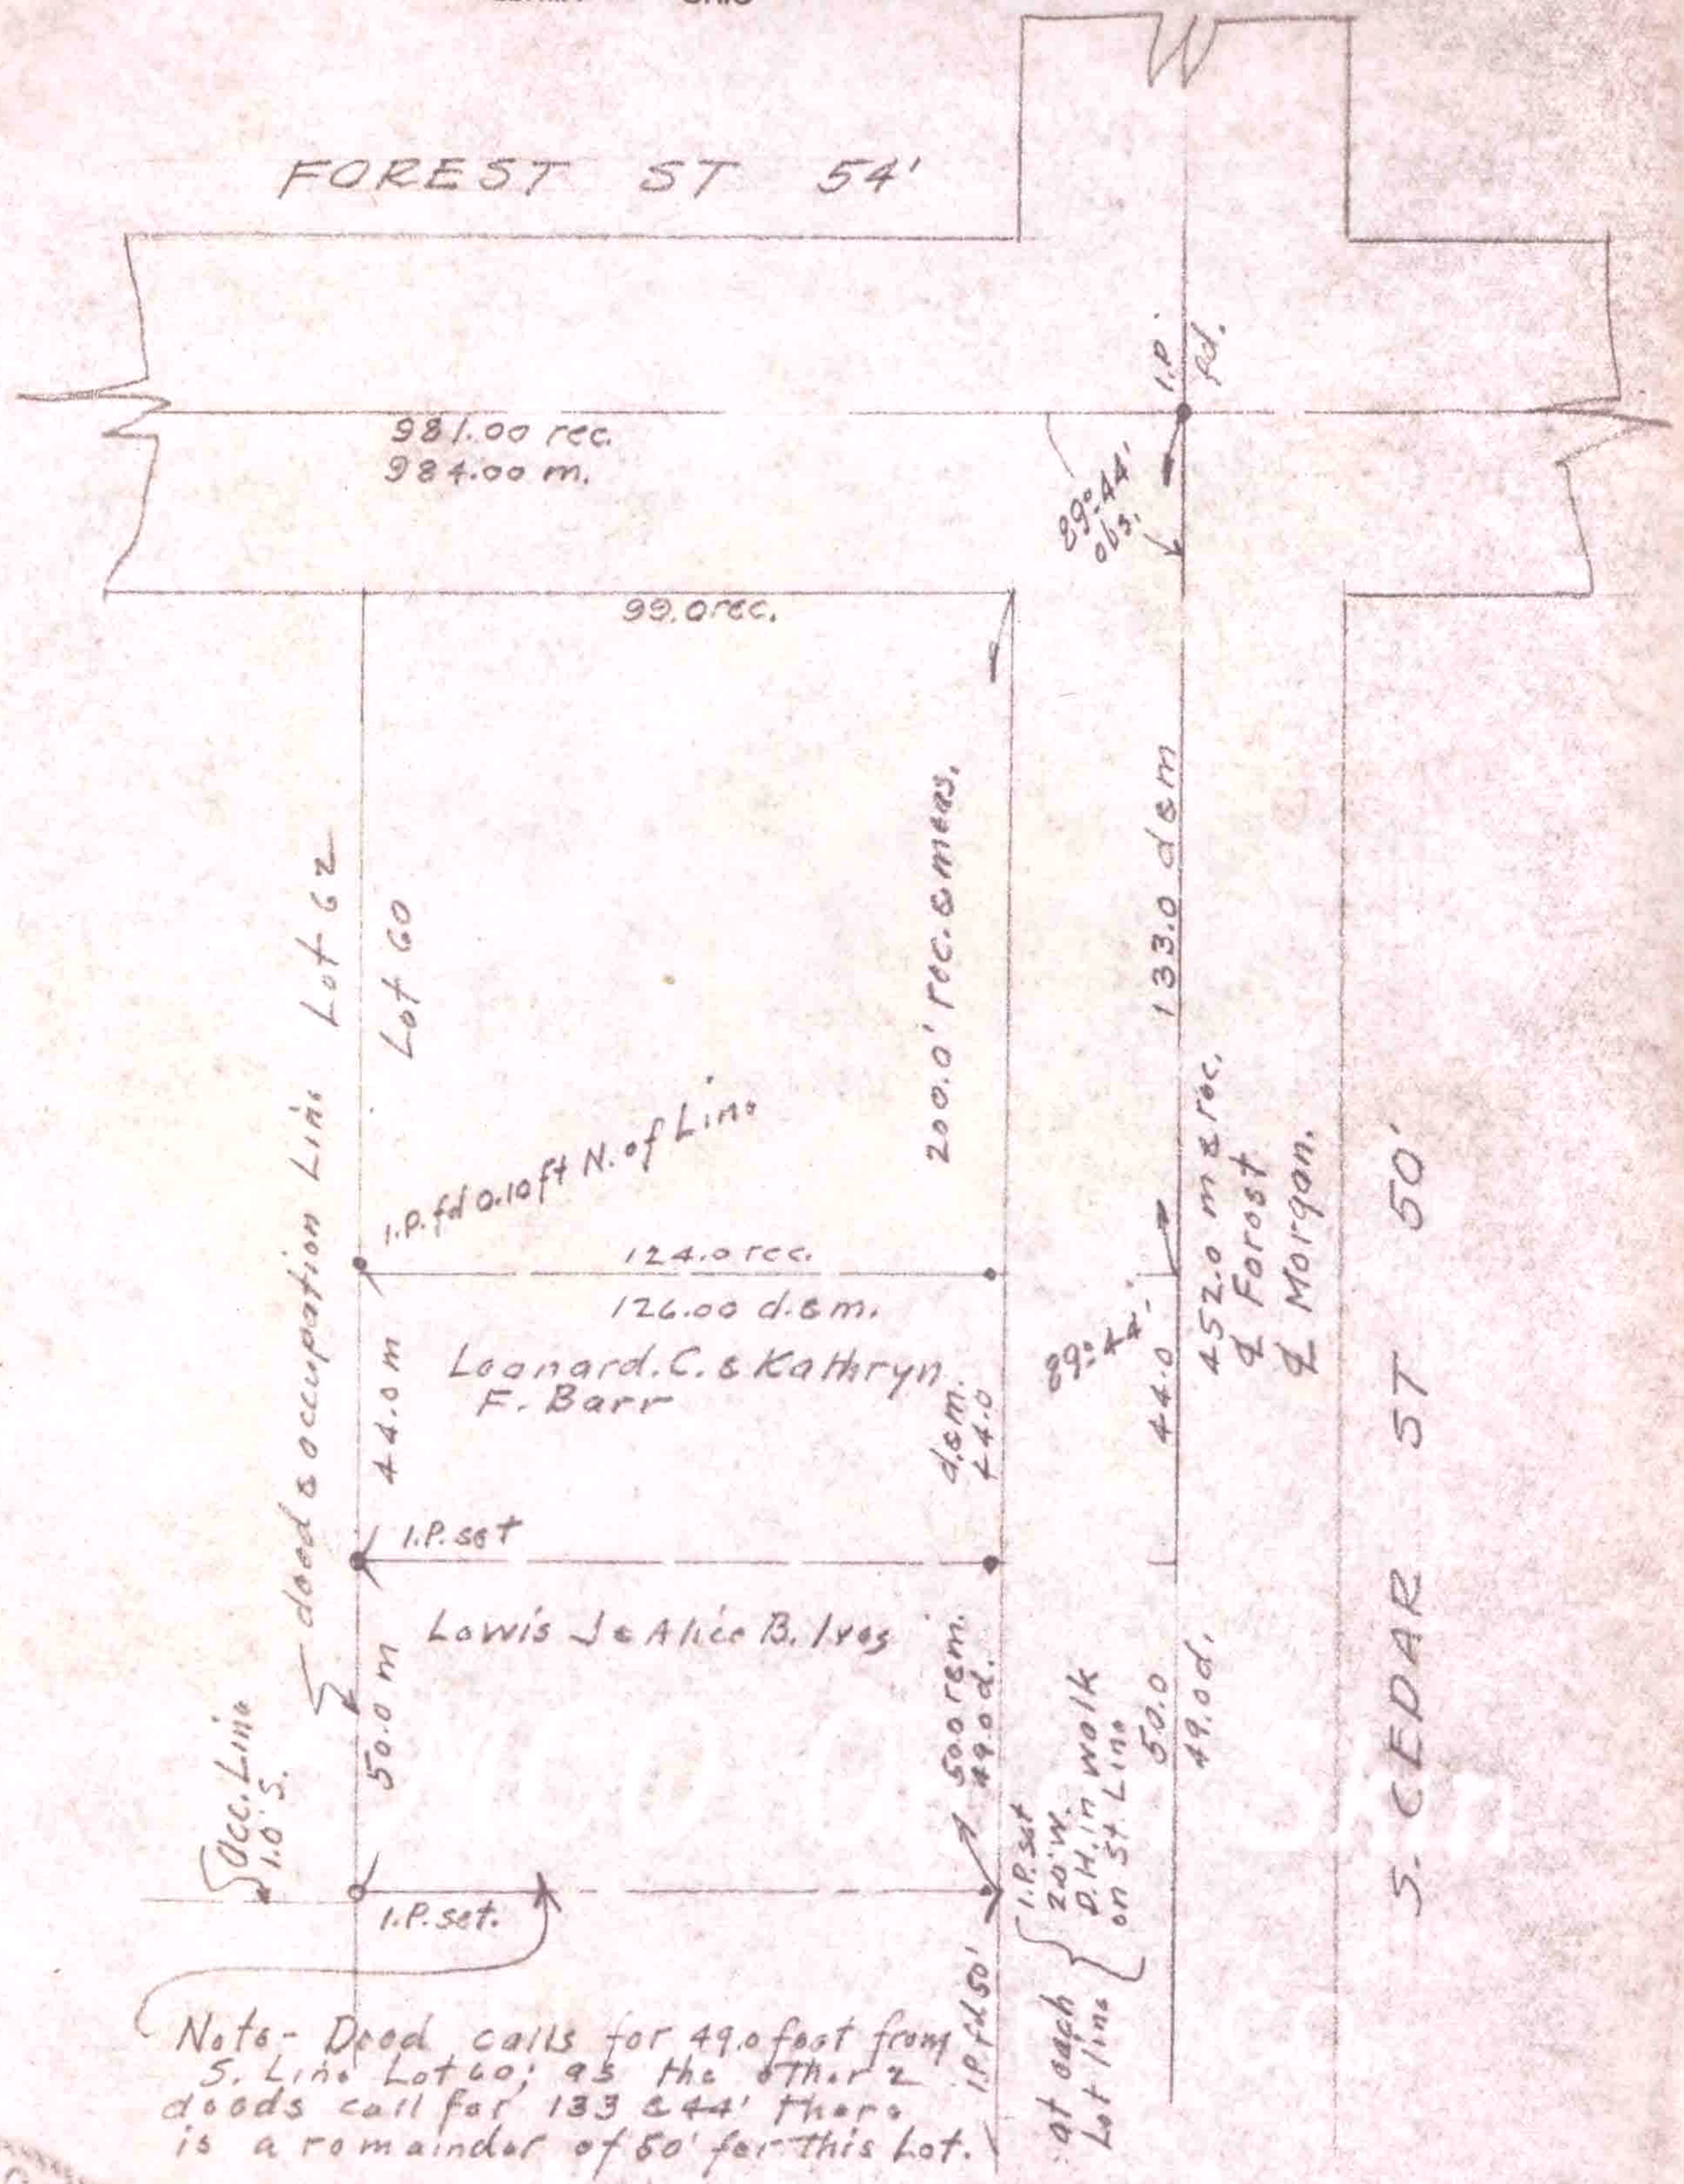

Note - Deed calls for 49.0 feet from S. Line Lot 60; as the other 2 deeds call for 133 & 44' there is a remainder of 50' for this Lot.

STATE OF OHIO
THOMAS
W.
LAUNDON
669
REGISTERED
SURVEYOR

Survey for Lewis Ivey & Leonard Barr
Part of Lot 60 W. W. Wright's Addn. P.V. 3-37
Oberlin Village. Lorain Co. Ohio Scale 1"=40'
Mar 5, 1948 T. W. Laundon Registered Surveyor