9-00-085-106-004
9-00-085-106-005
9-00-085-4

Scan # 46583

State of Ohio
Registered Professional
Engineer and Surveyor

Phone Home ~~2894~~
~~Office 3211~~

THOMAS W. LAUNDON
CIVIL ENGINEER AND SURVEYOR
~~405 Dyke Building~~
ELYRIA - OHIO

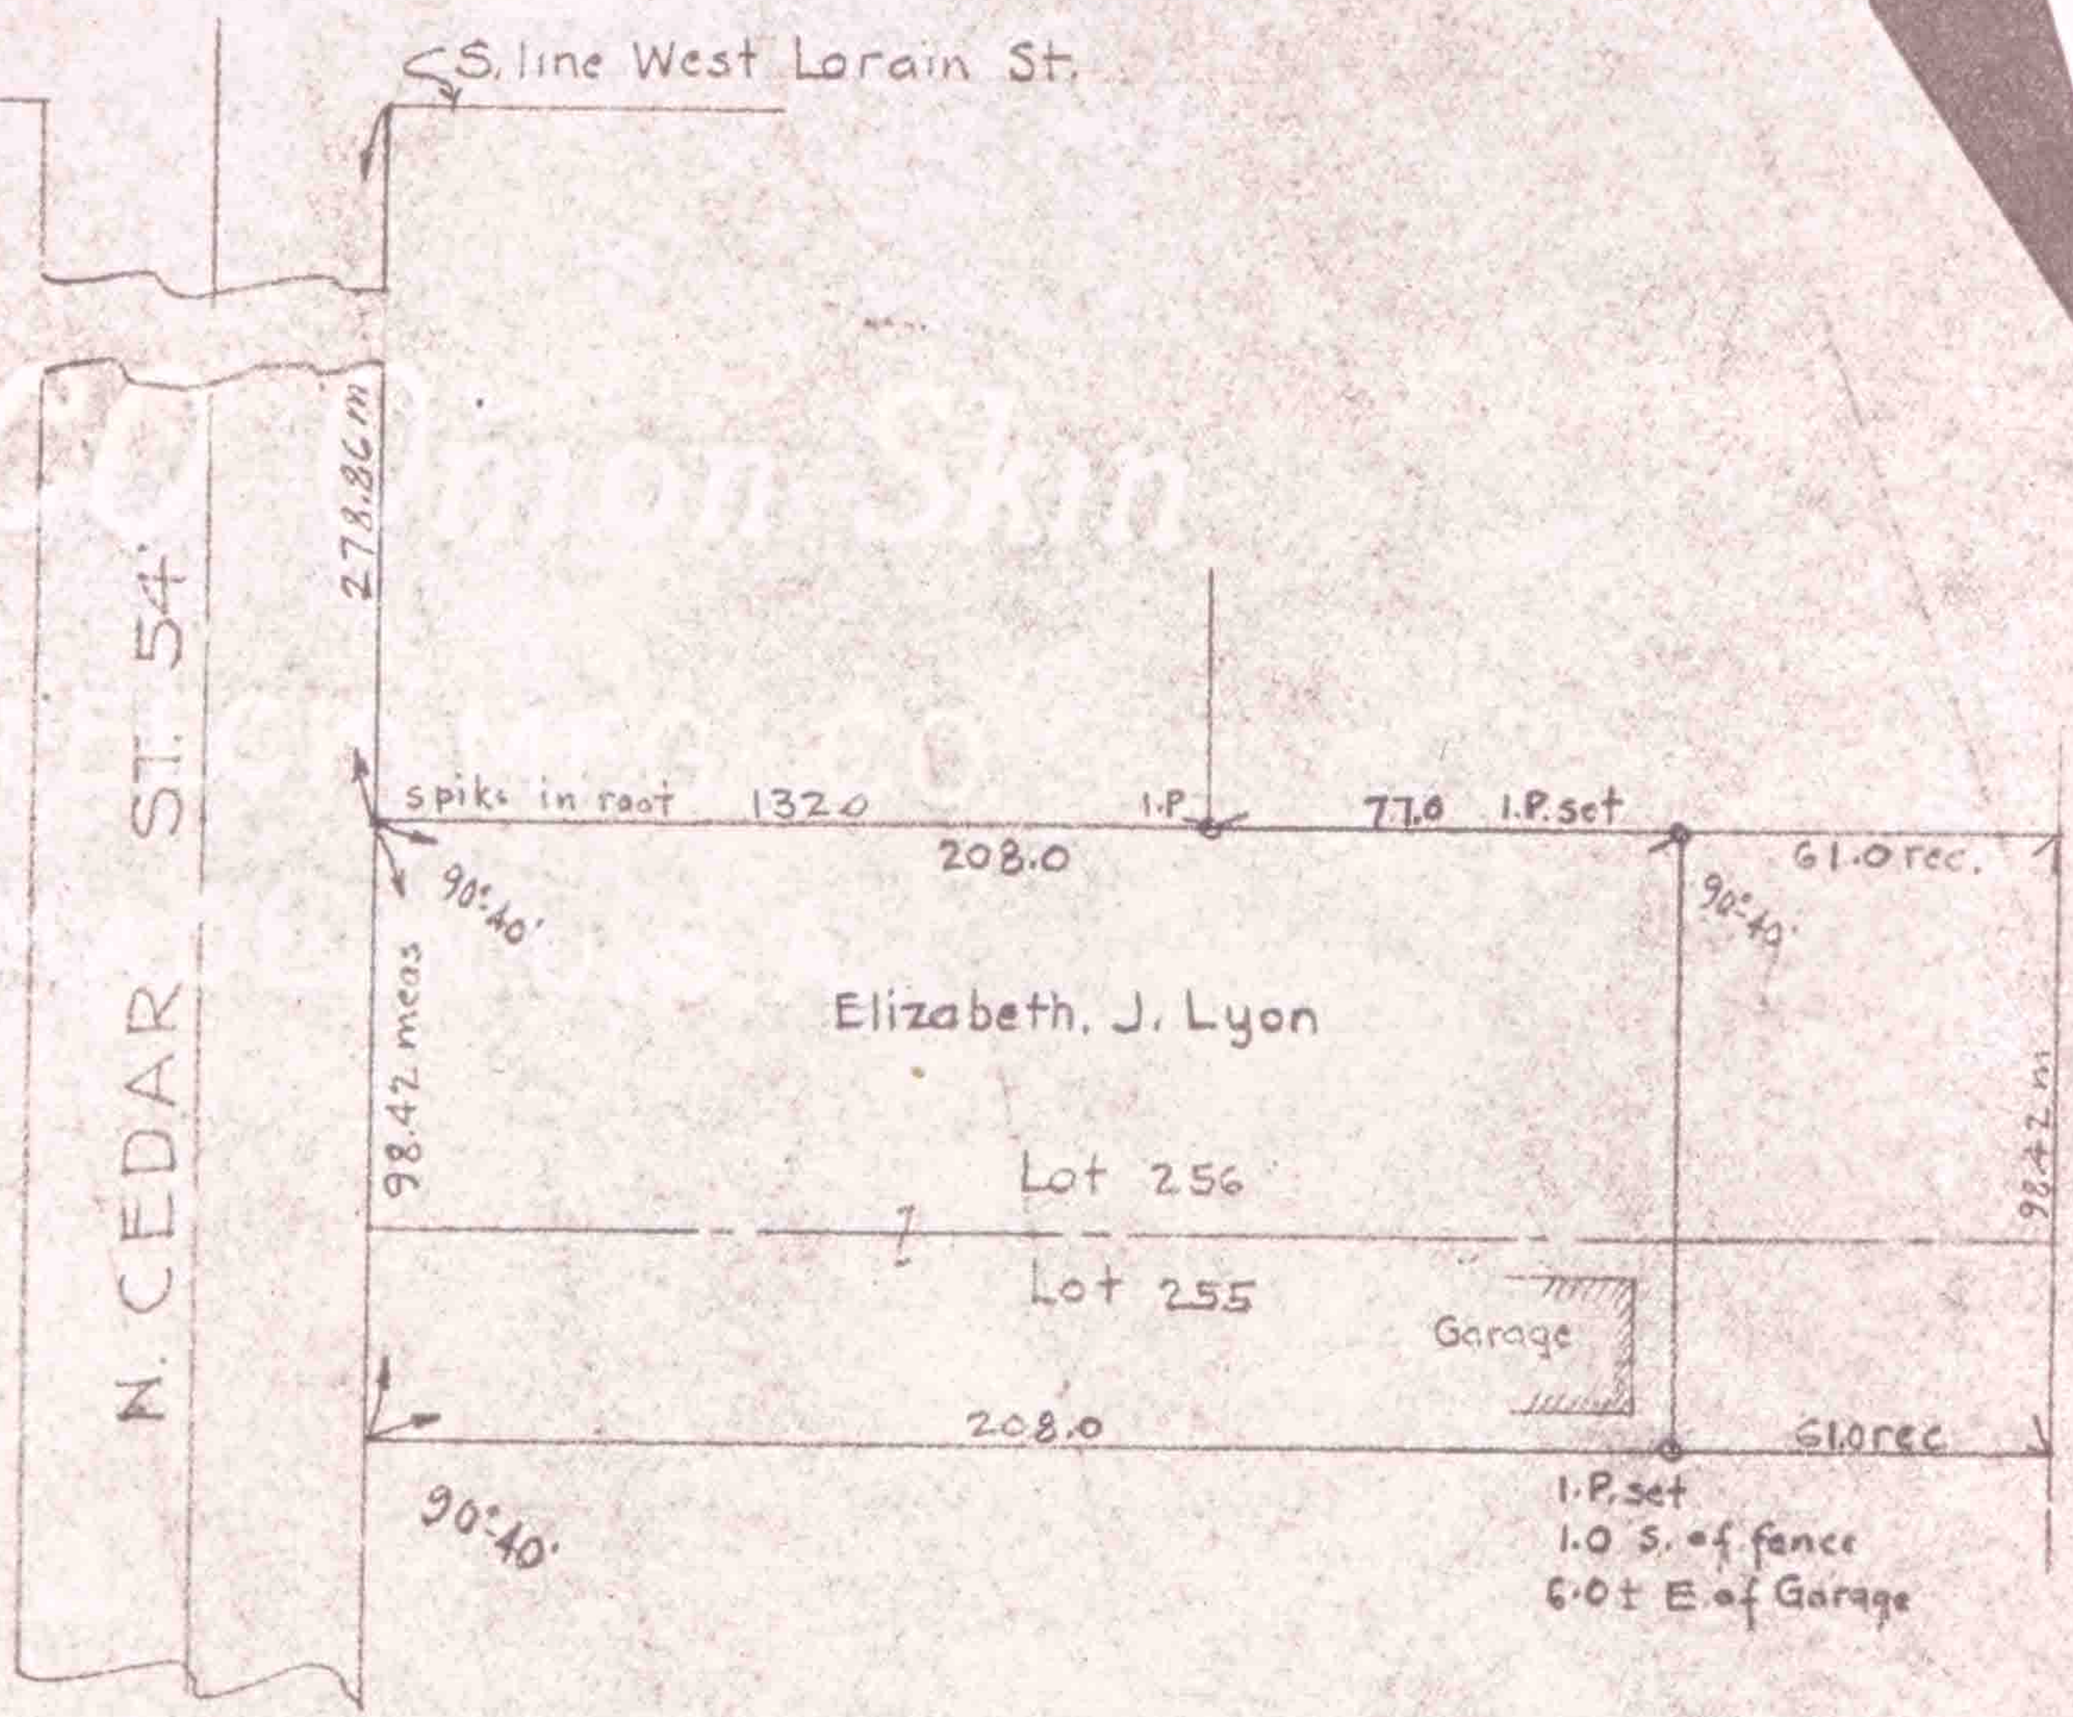

N

Survey for The Board of Trustees of Oberlin Colle
Parts of lots 255 & 256 Original Village Plat
Village of Oberlin. Lorain Co. Ohio.
Scale 1" = 50' Apr. 23, 1946
T.W. Laundon Registered Surveyor.