


9-00-085-106
 9-00-085-A
 SCAN # 46585

of Ohio
 Professional
 and Surveyor
 ome 2094

THOMAS W. LAUNDON
 CIVIL ENGINEER AND SURVEYOR

Municipal Engineering
 Surveys - City, Farm,
 Sub-divisions

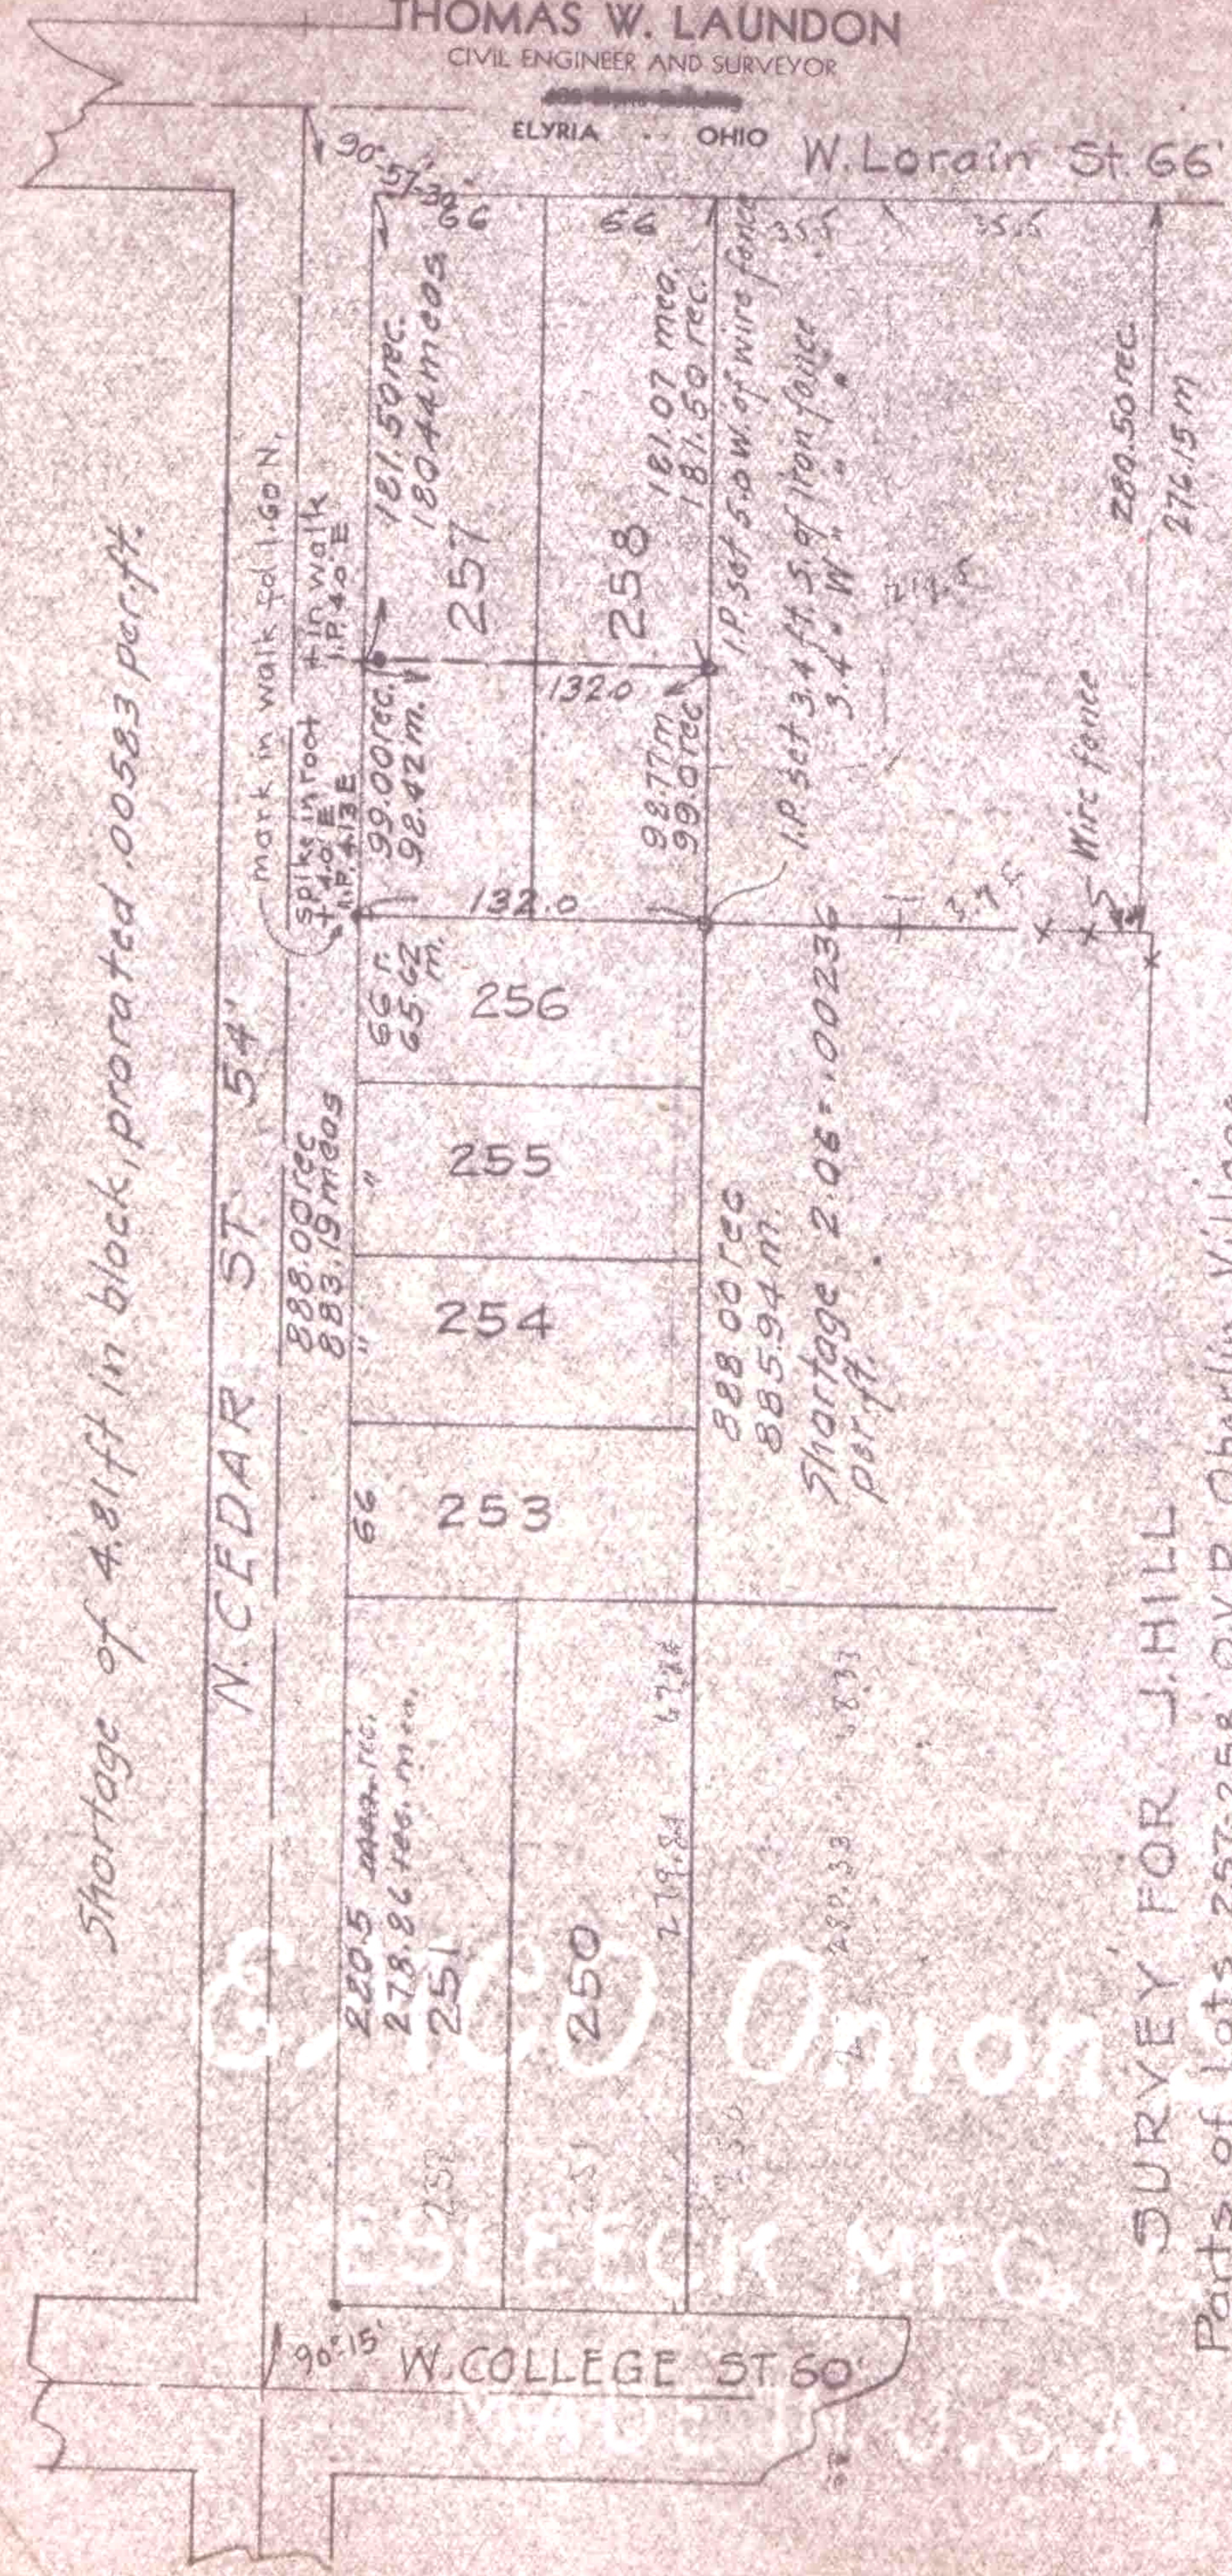

SURVEY FOR J. HILL
 Parts of Lots 257-258 O.V.P. Oberlin Village
 Lorain Co. Ohio. Scale 1" = 100' Sept 26, 1943
 T.W. Laundon Registered Surveyor.

ONION

WESLECK MFG.

MADE IN U.S.A.