


9-00-085-106
9-00-085-A
SCAN # 46587

W. LORAIN ST. 66'

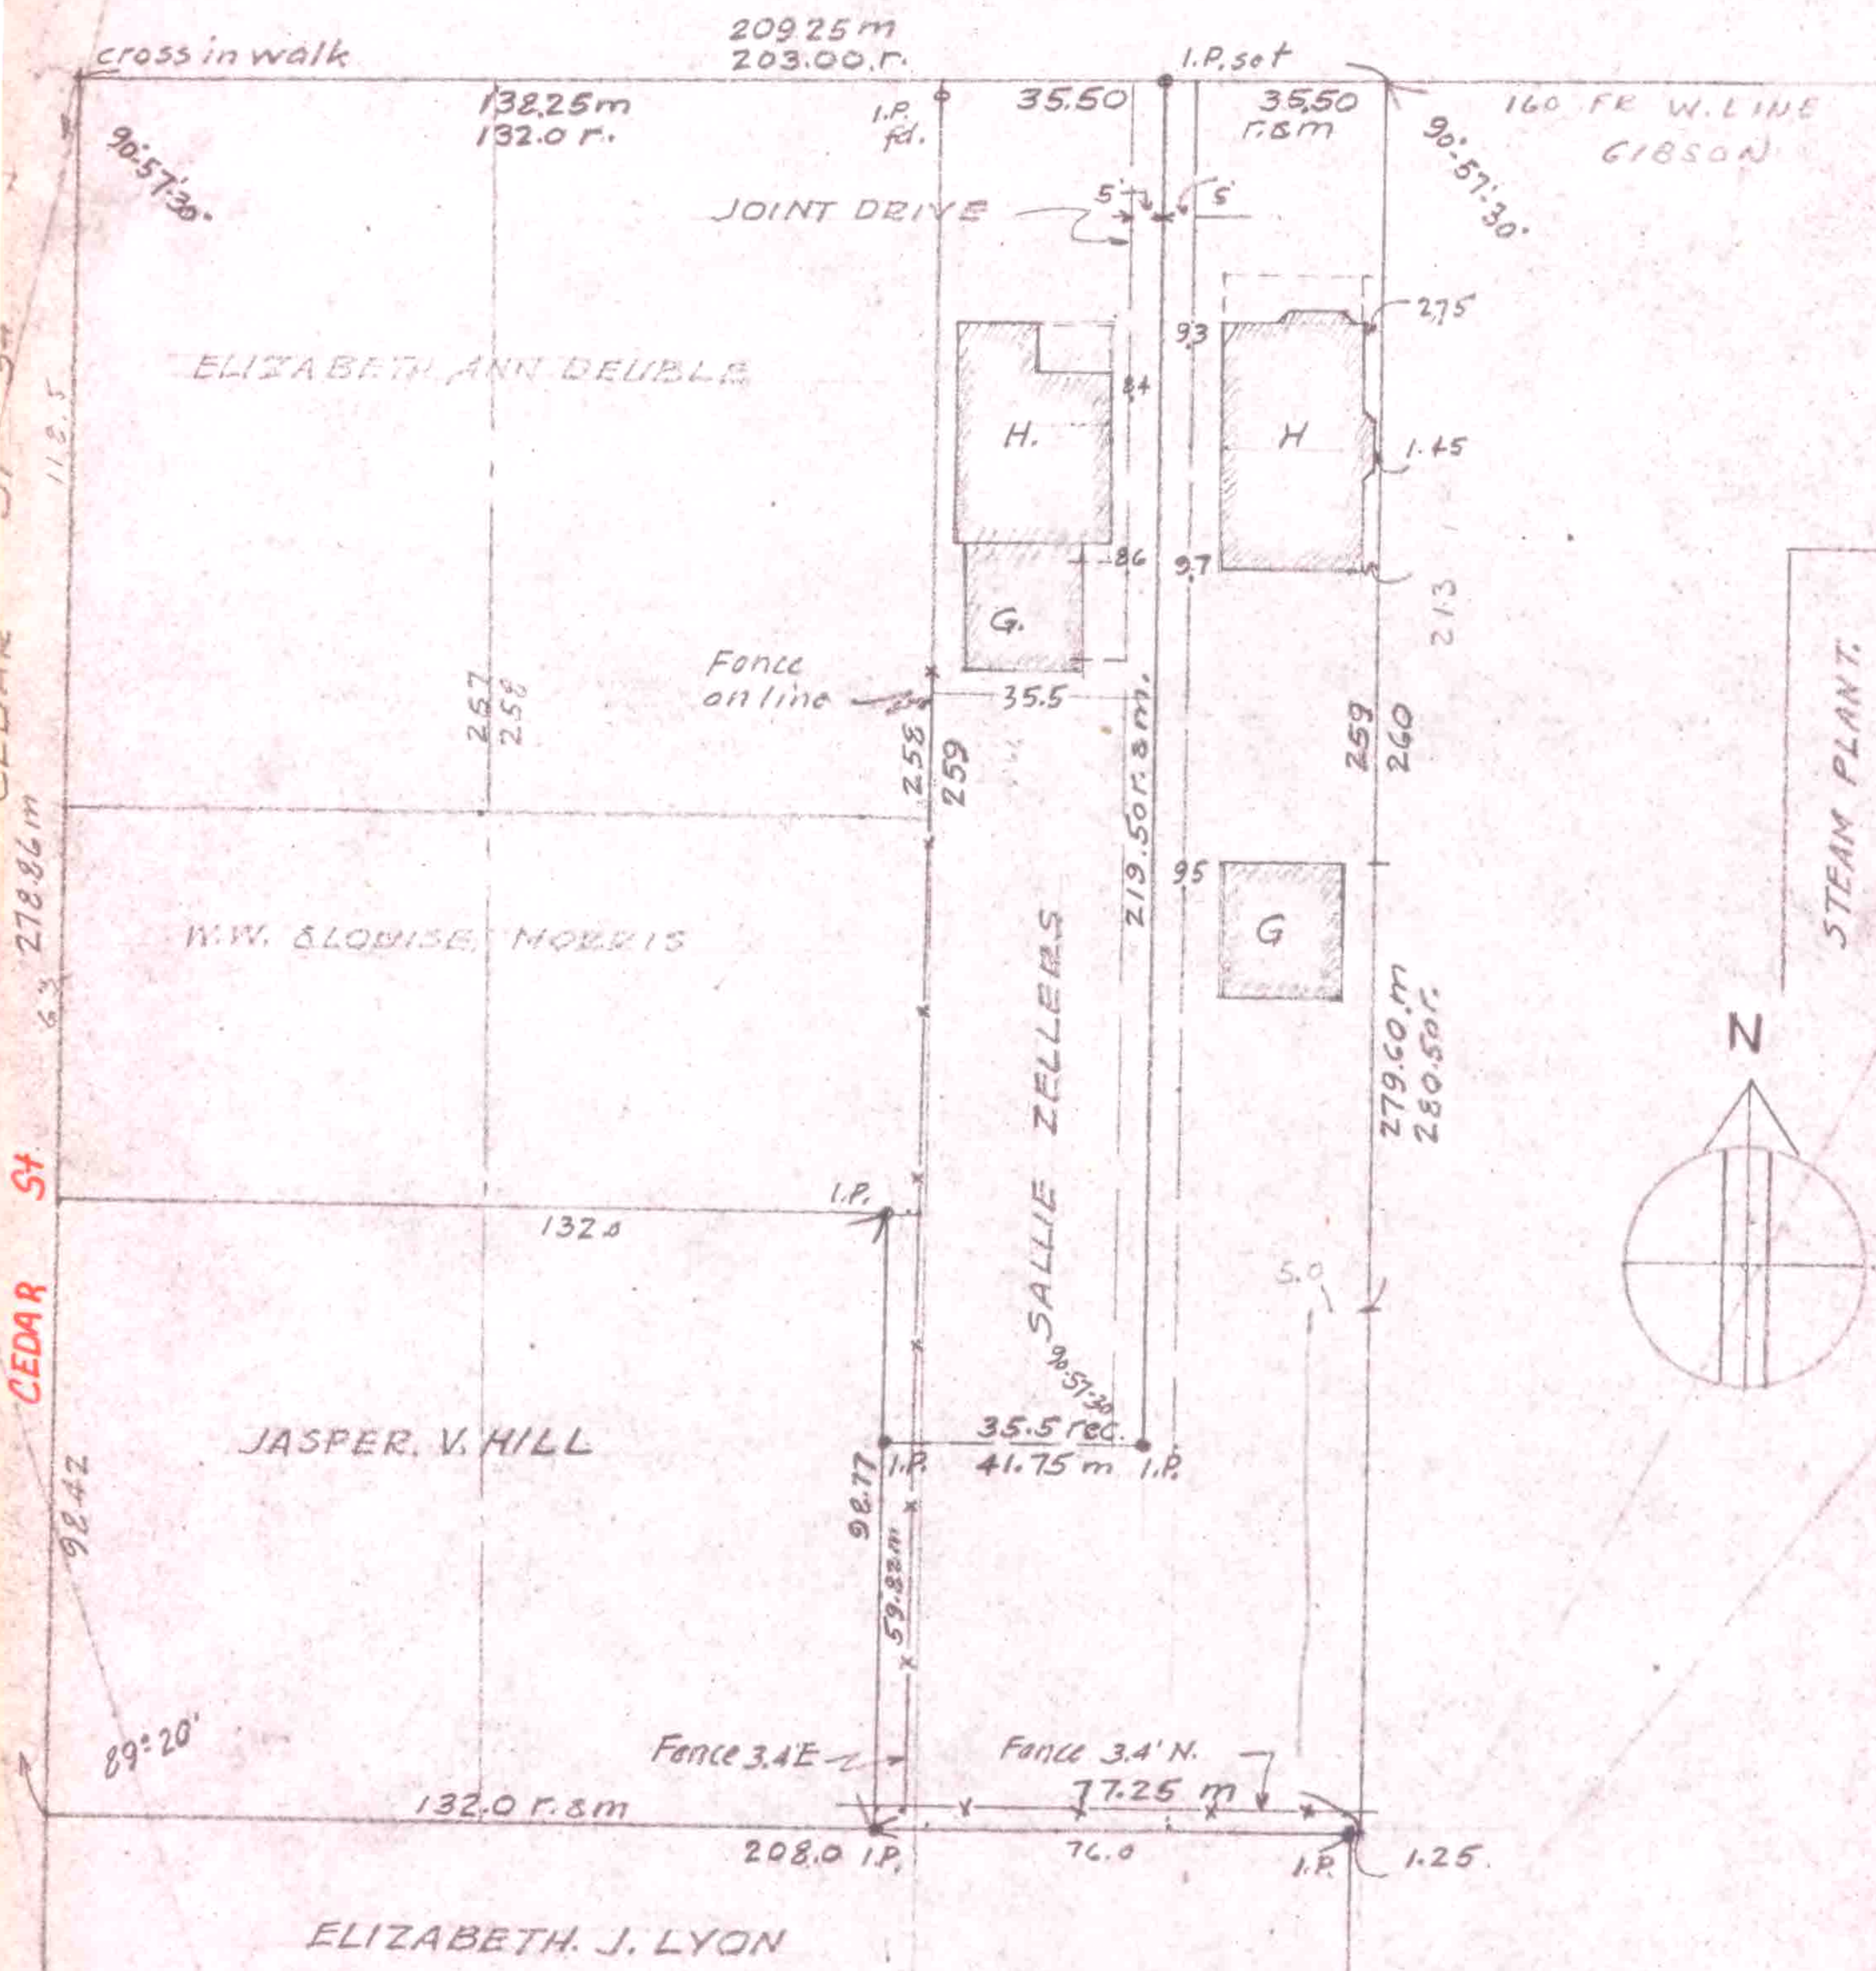

SURVEY FOR
 THE BOARD OF TRUSTEES OF OBERLIN COLLEGE
 PART OF O.V.P. 259 OBERLIN VILLAGE, LORAIN, CO. OHIO
 SCALE 1" = 40' NOV. 19, 1949.
 T.W. LAUNDON REGISTERED SURVEYOR