9-00-085-107-019
9-00-085-B
Scan # 46588

Ohio
ofessional
Surveyor

e 2094
ce 3211

THOMAS W. LAUNDON
CIVIL ENGINEER AND SURVEYOR
~~405 Elyria Building~~
ELYRIA - OHIO

Municipal Engineering
Surveys - City, Farm,
Sub-divisions

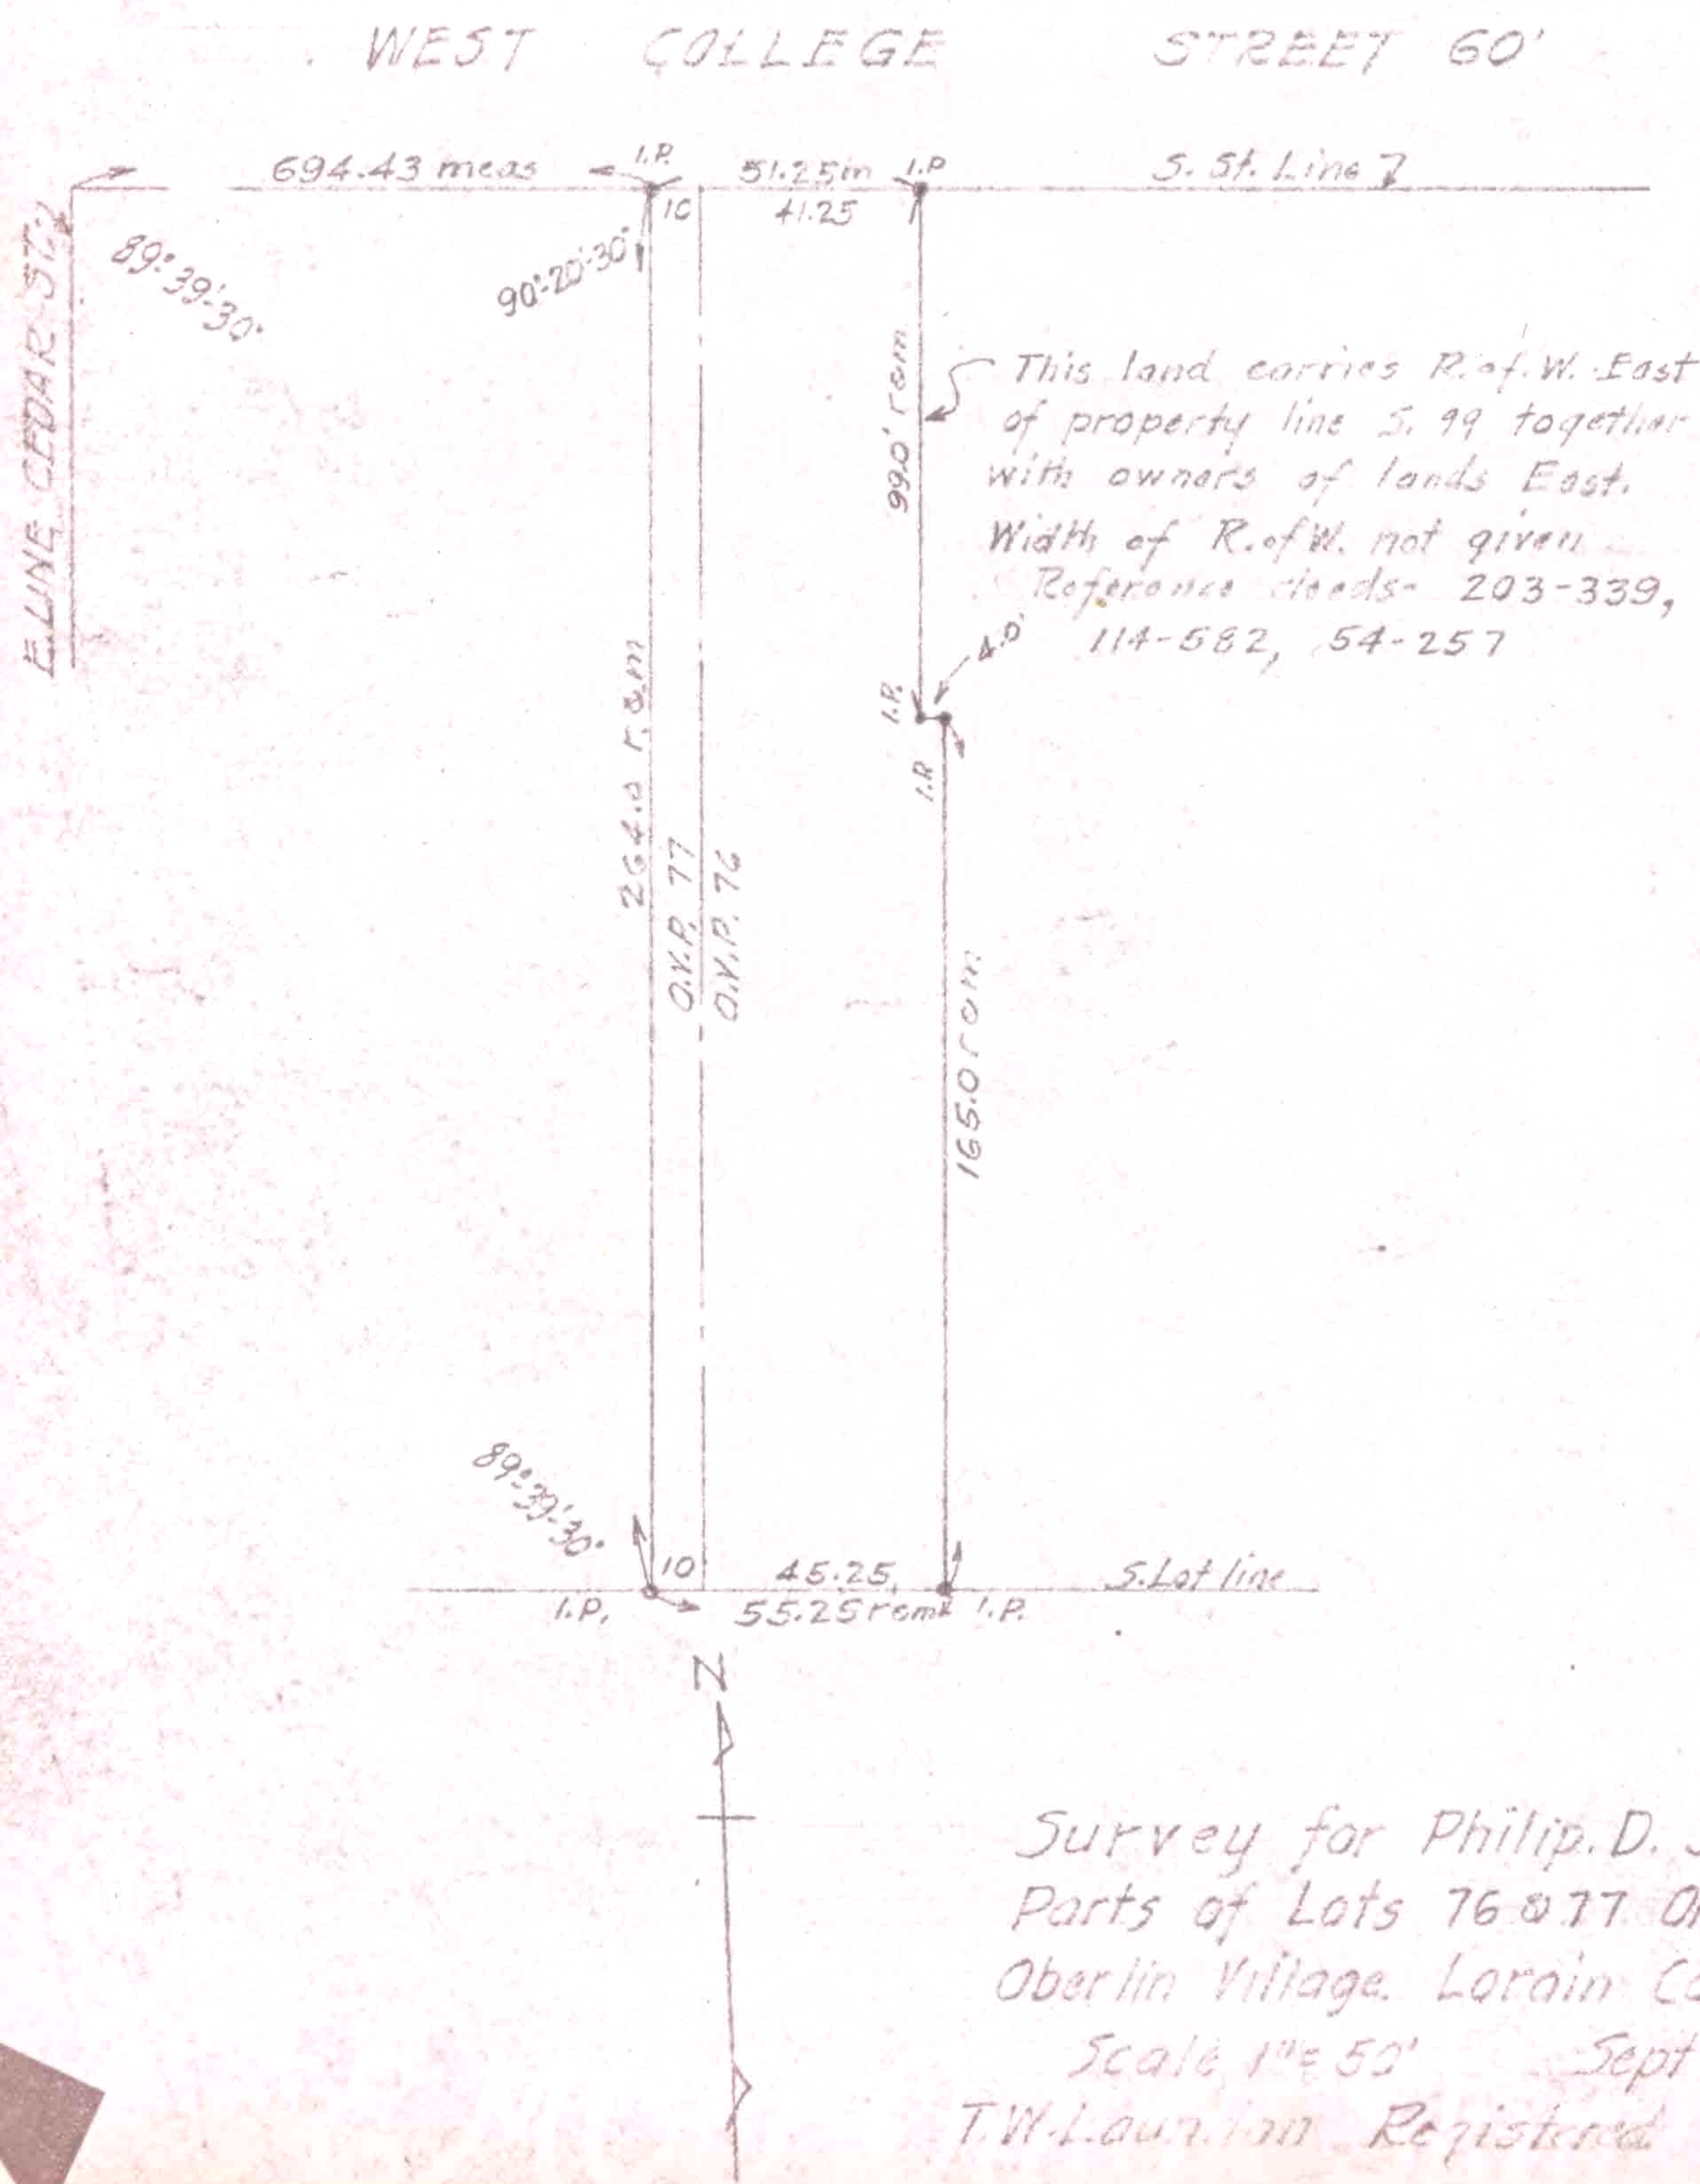

Survey for Philip. D. Sherman
Parts of Lots 76 & 77 Original Village Plat
Oberlin Village. Lorain Co. Ohio.
Scale 1" = 50' Sept 16, 1944
T.W. Laundon Registered Surveyor