9-00-086-105-017

9-00-086-A

Scan# 46604

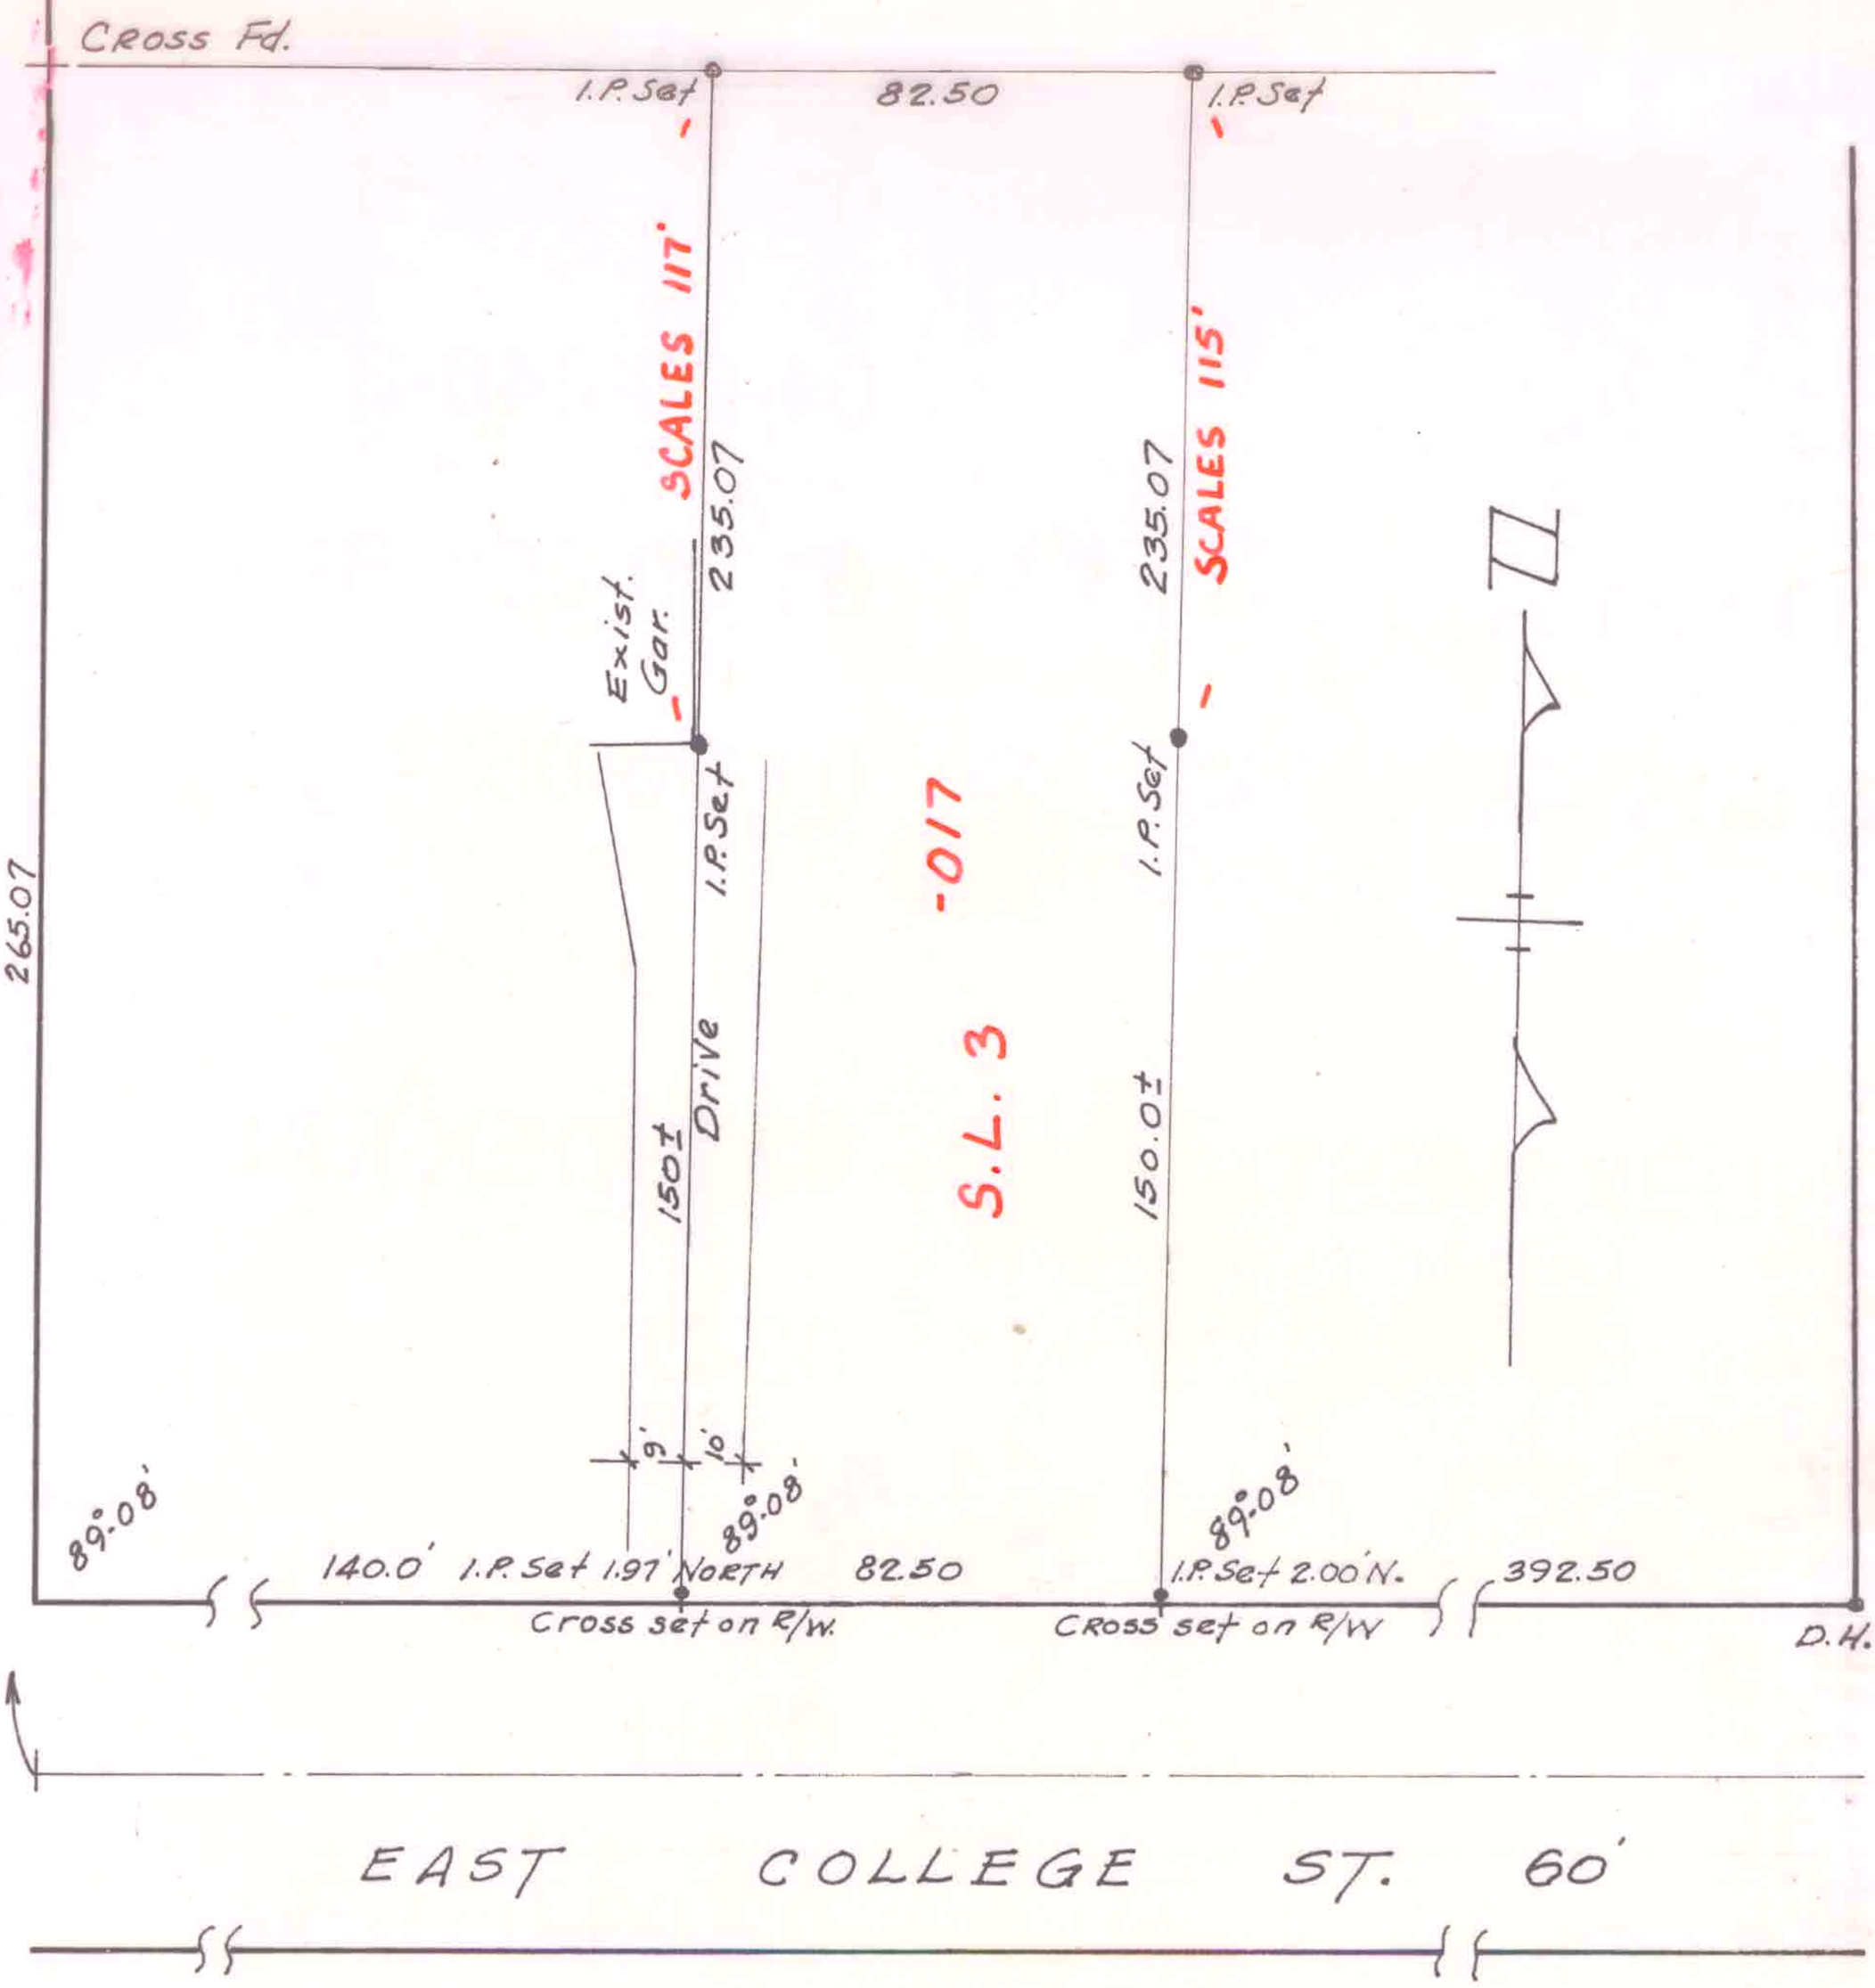

SURVEY FOR ESTHER CARSON SPERRY

PART OF VILLAGE LOT 22 OBERLIN CITY

LORAIN COUNTY OHIO

SCALE 1"=50' JULY 8, 1968

LAUNDON, HUFFMAN & SIMON. SURVEYORS

NUMBERS IN RED PUT ON BECAUSE SURVEY DID NOT MATCH TAX MAP PUT ON BY R.C 7-15-82

NOT PART OF SURVEY