


Stone & Lorain St.

9-00-087-101-030
9-00-087-A

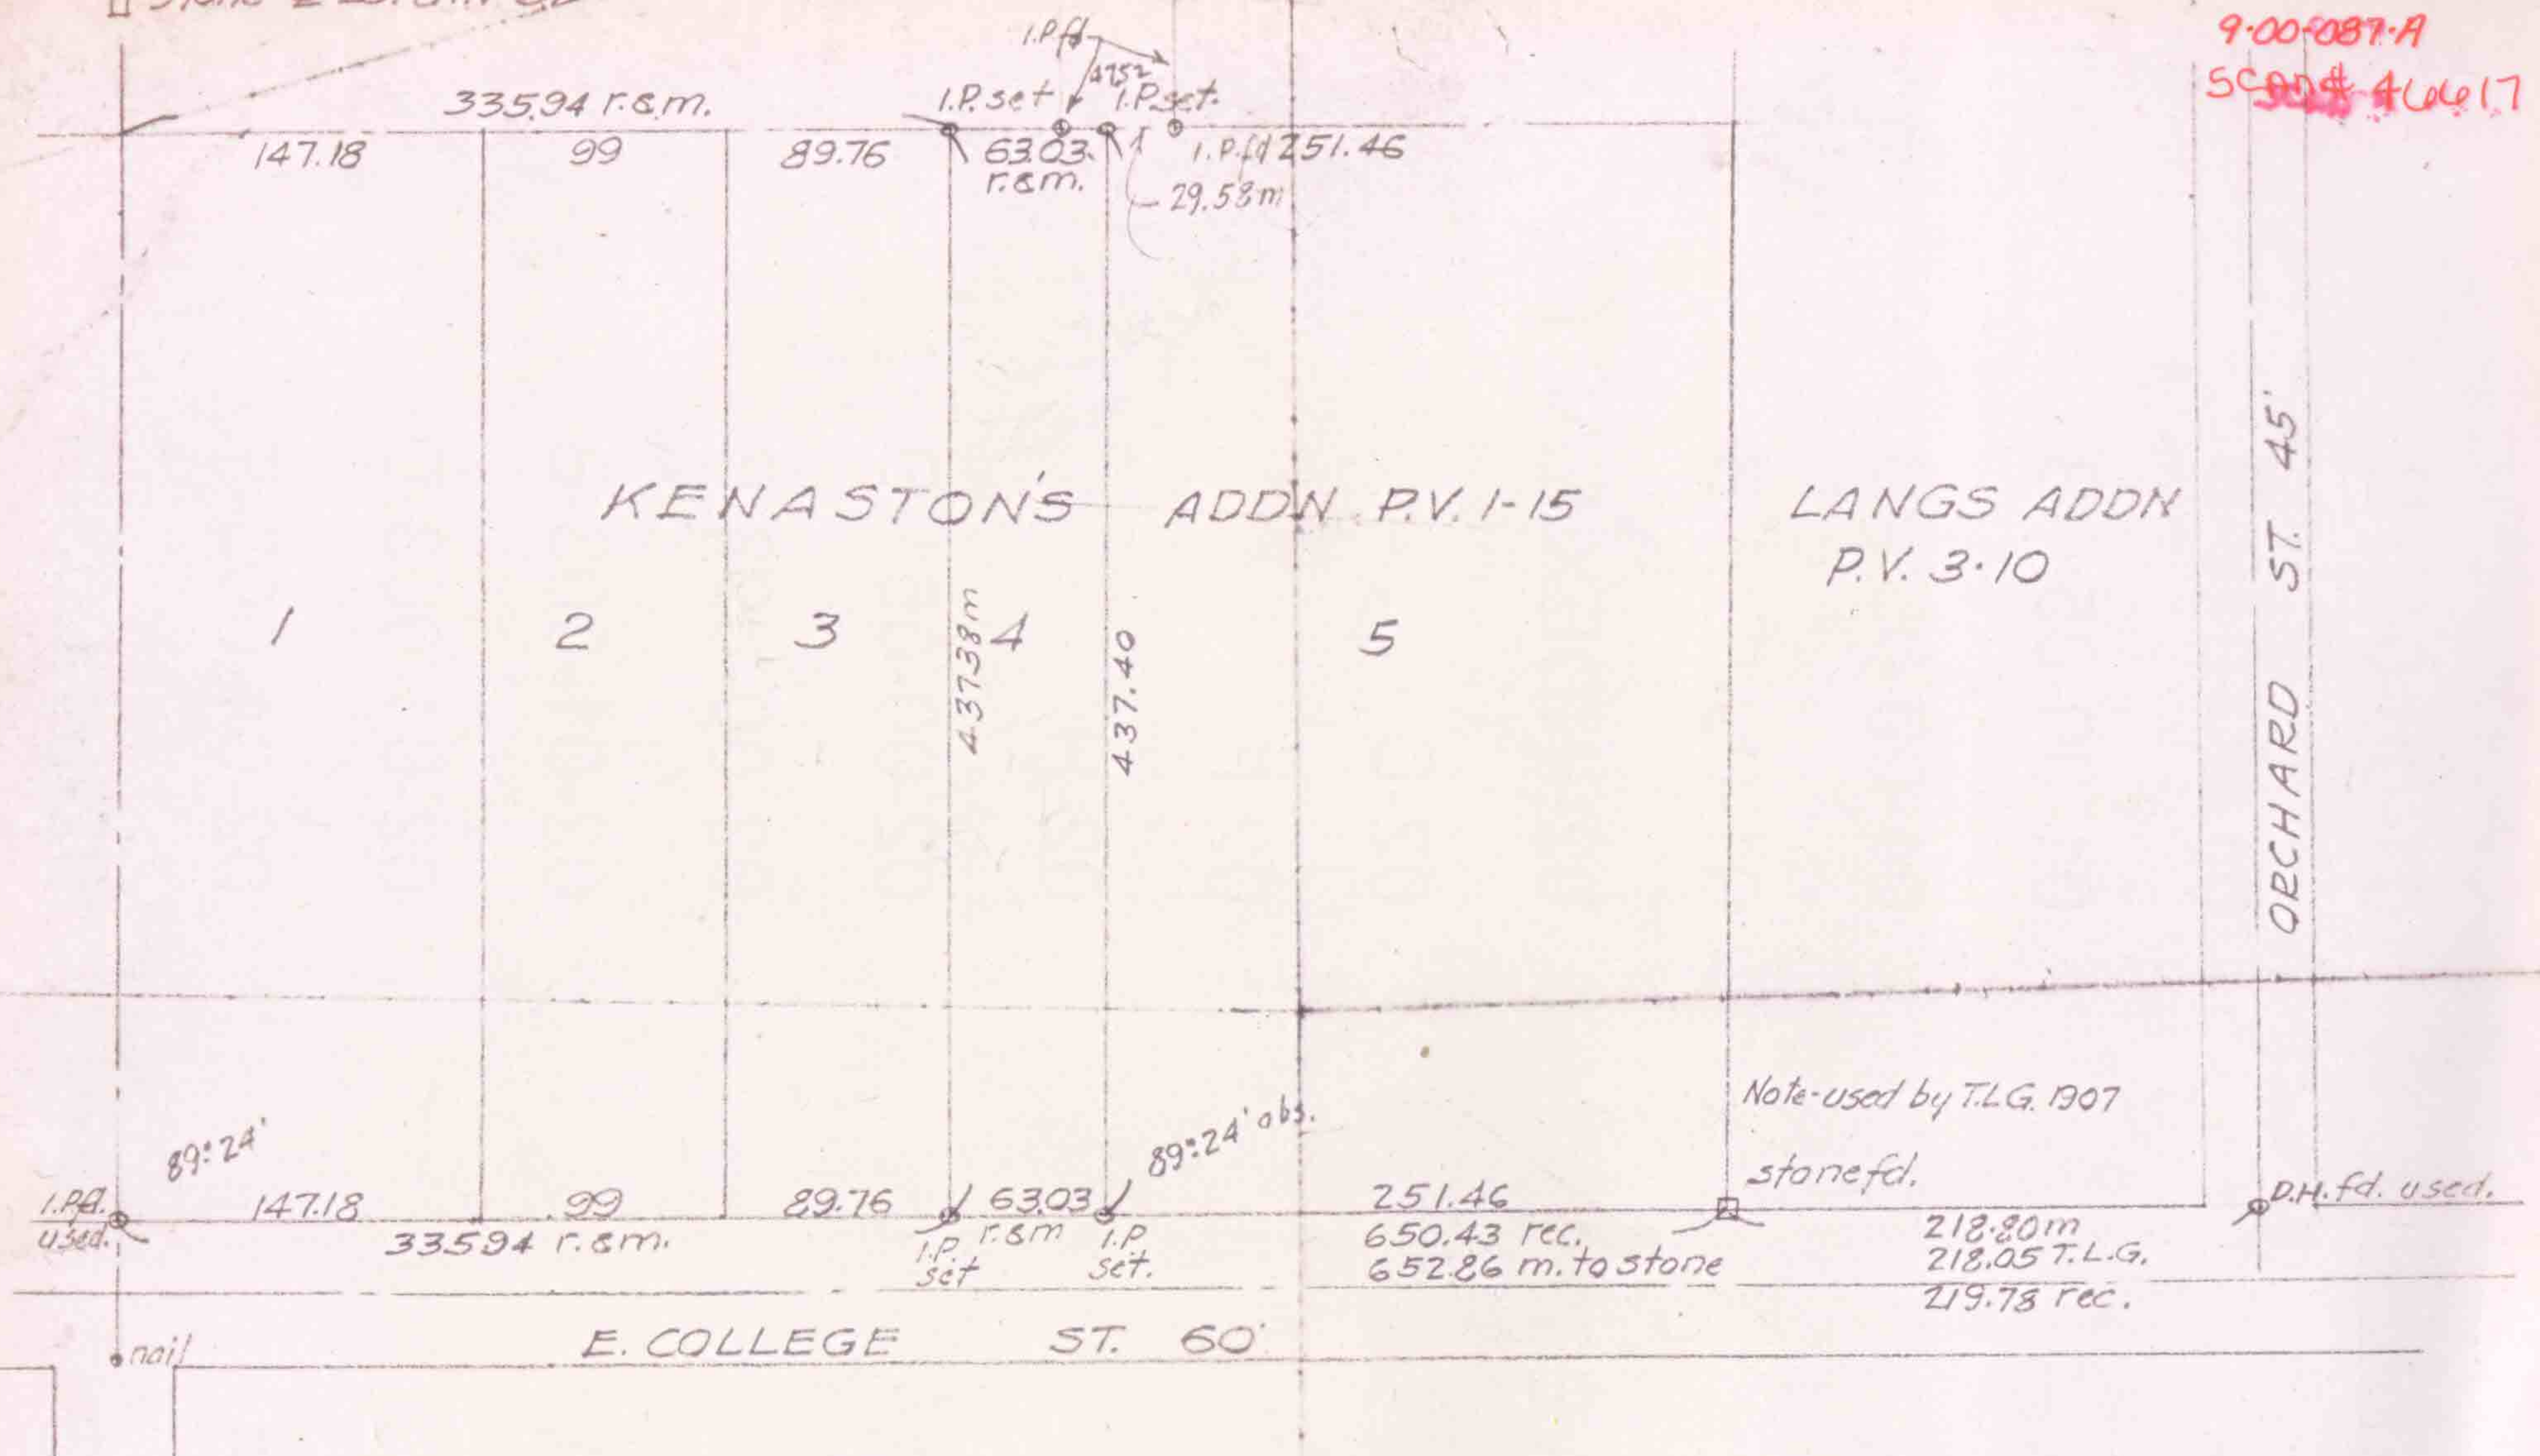

 LOT 4 KENASTON'S ADDN. P.V. 1- PG. 15
 OBERLIN VILLAGE. LORAIN CO OHIO.
 SCALE 1" = 100' SEPT. 26. 1951
 T.W. LAUNDON REG SURVEYOR.