


9-00-087-104-000  
 9-00-087-A  
 5' SW 1/4 # 46620

E. College

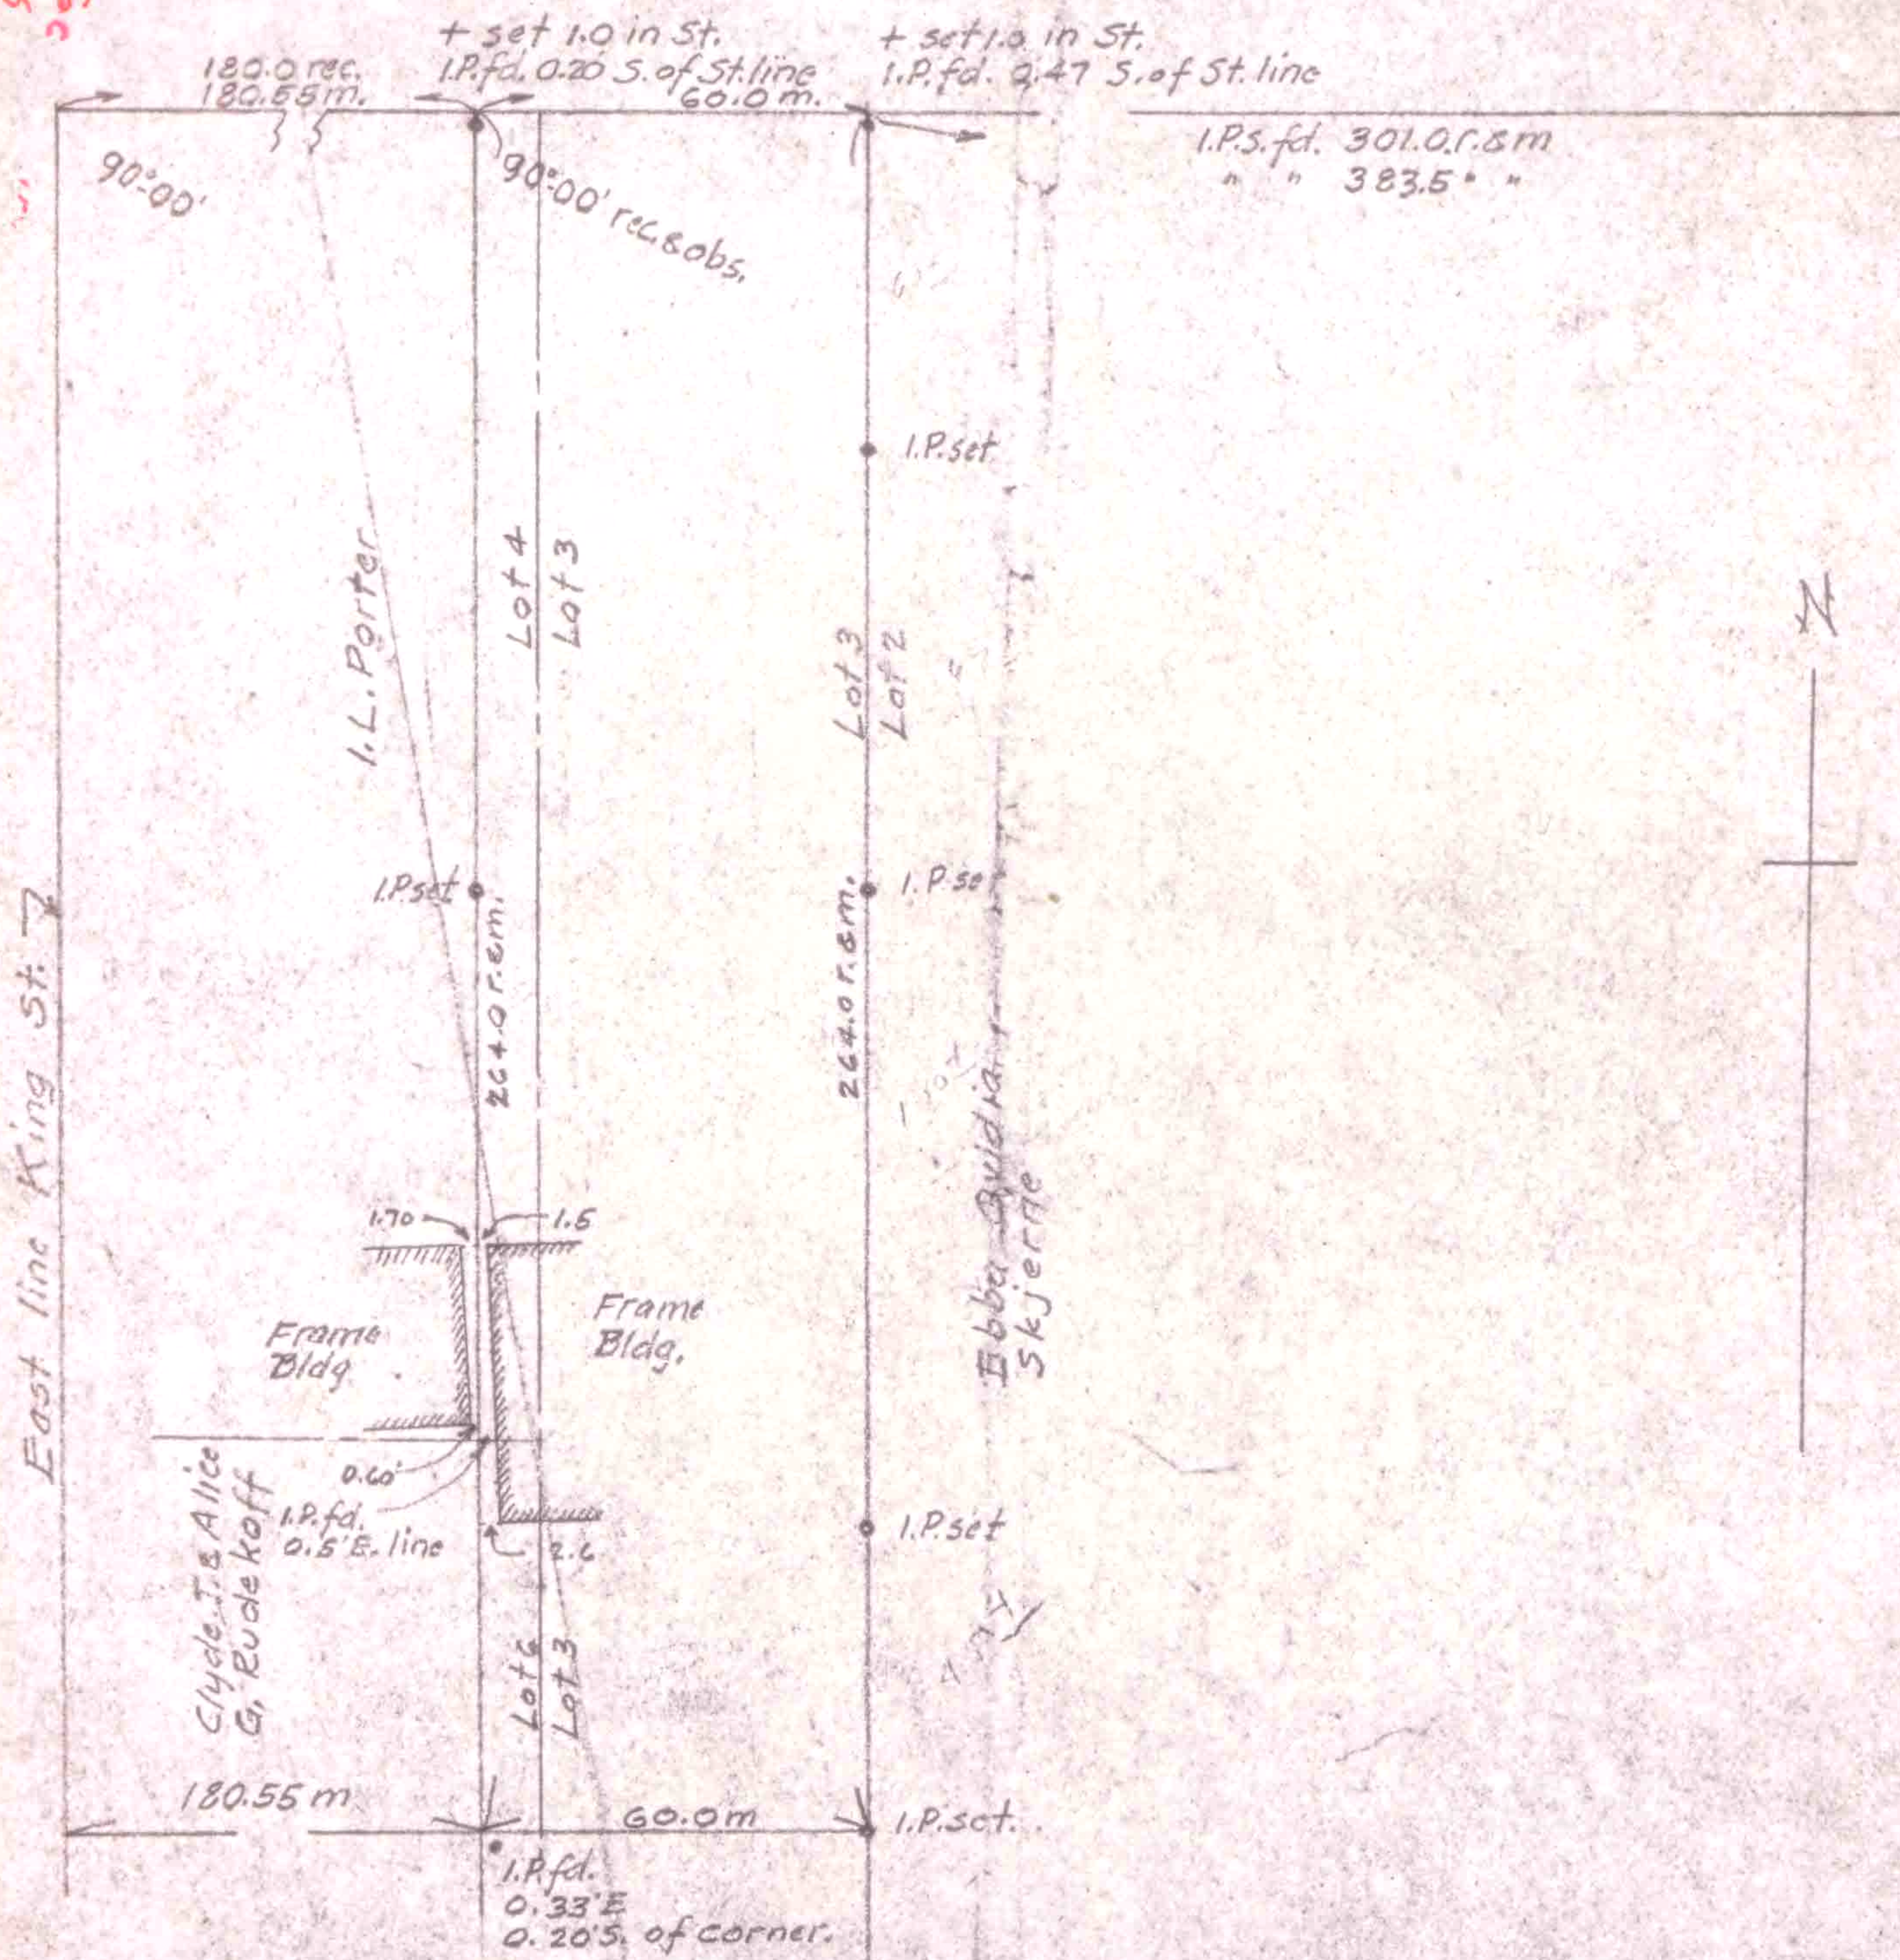

Survey for John Hanson Estate  
 Parts of Lots 4 & 6. All of Lot 3  
 Kings Addn. P.V. 5 Pg 4 L.C.R.P.  
 Oberlin Village, Lorain Co. Ohio  
 Scale 1" = 40' Apr. 25, 1950  
 T.W. Laundon, Registered Surveyor.