


9-00-094-101-013

9-00-094-B

SCAN # 46628

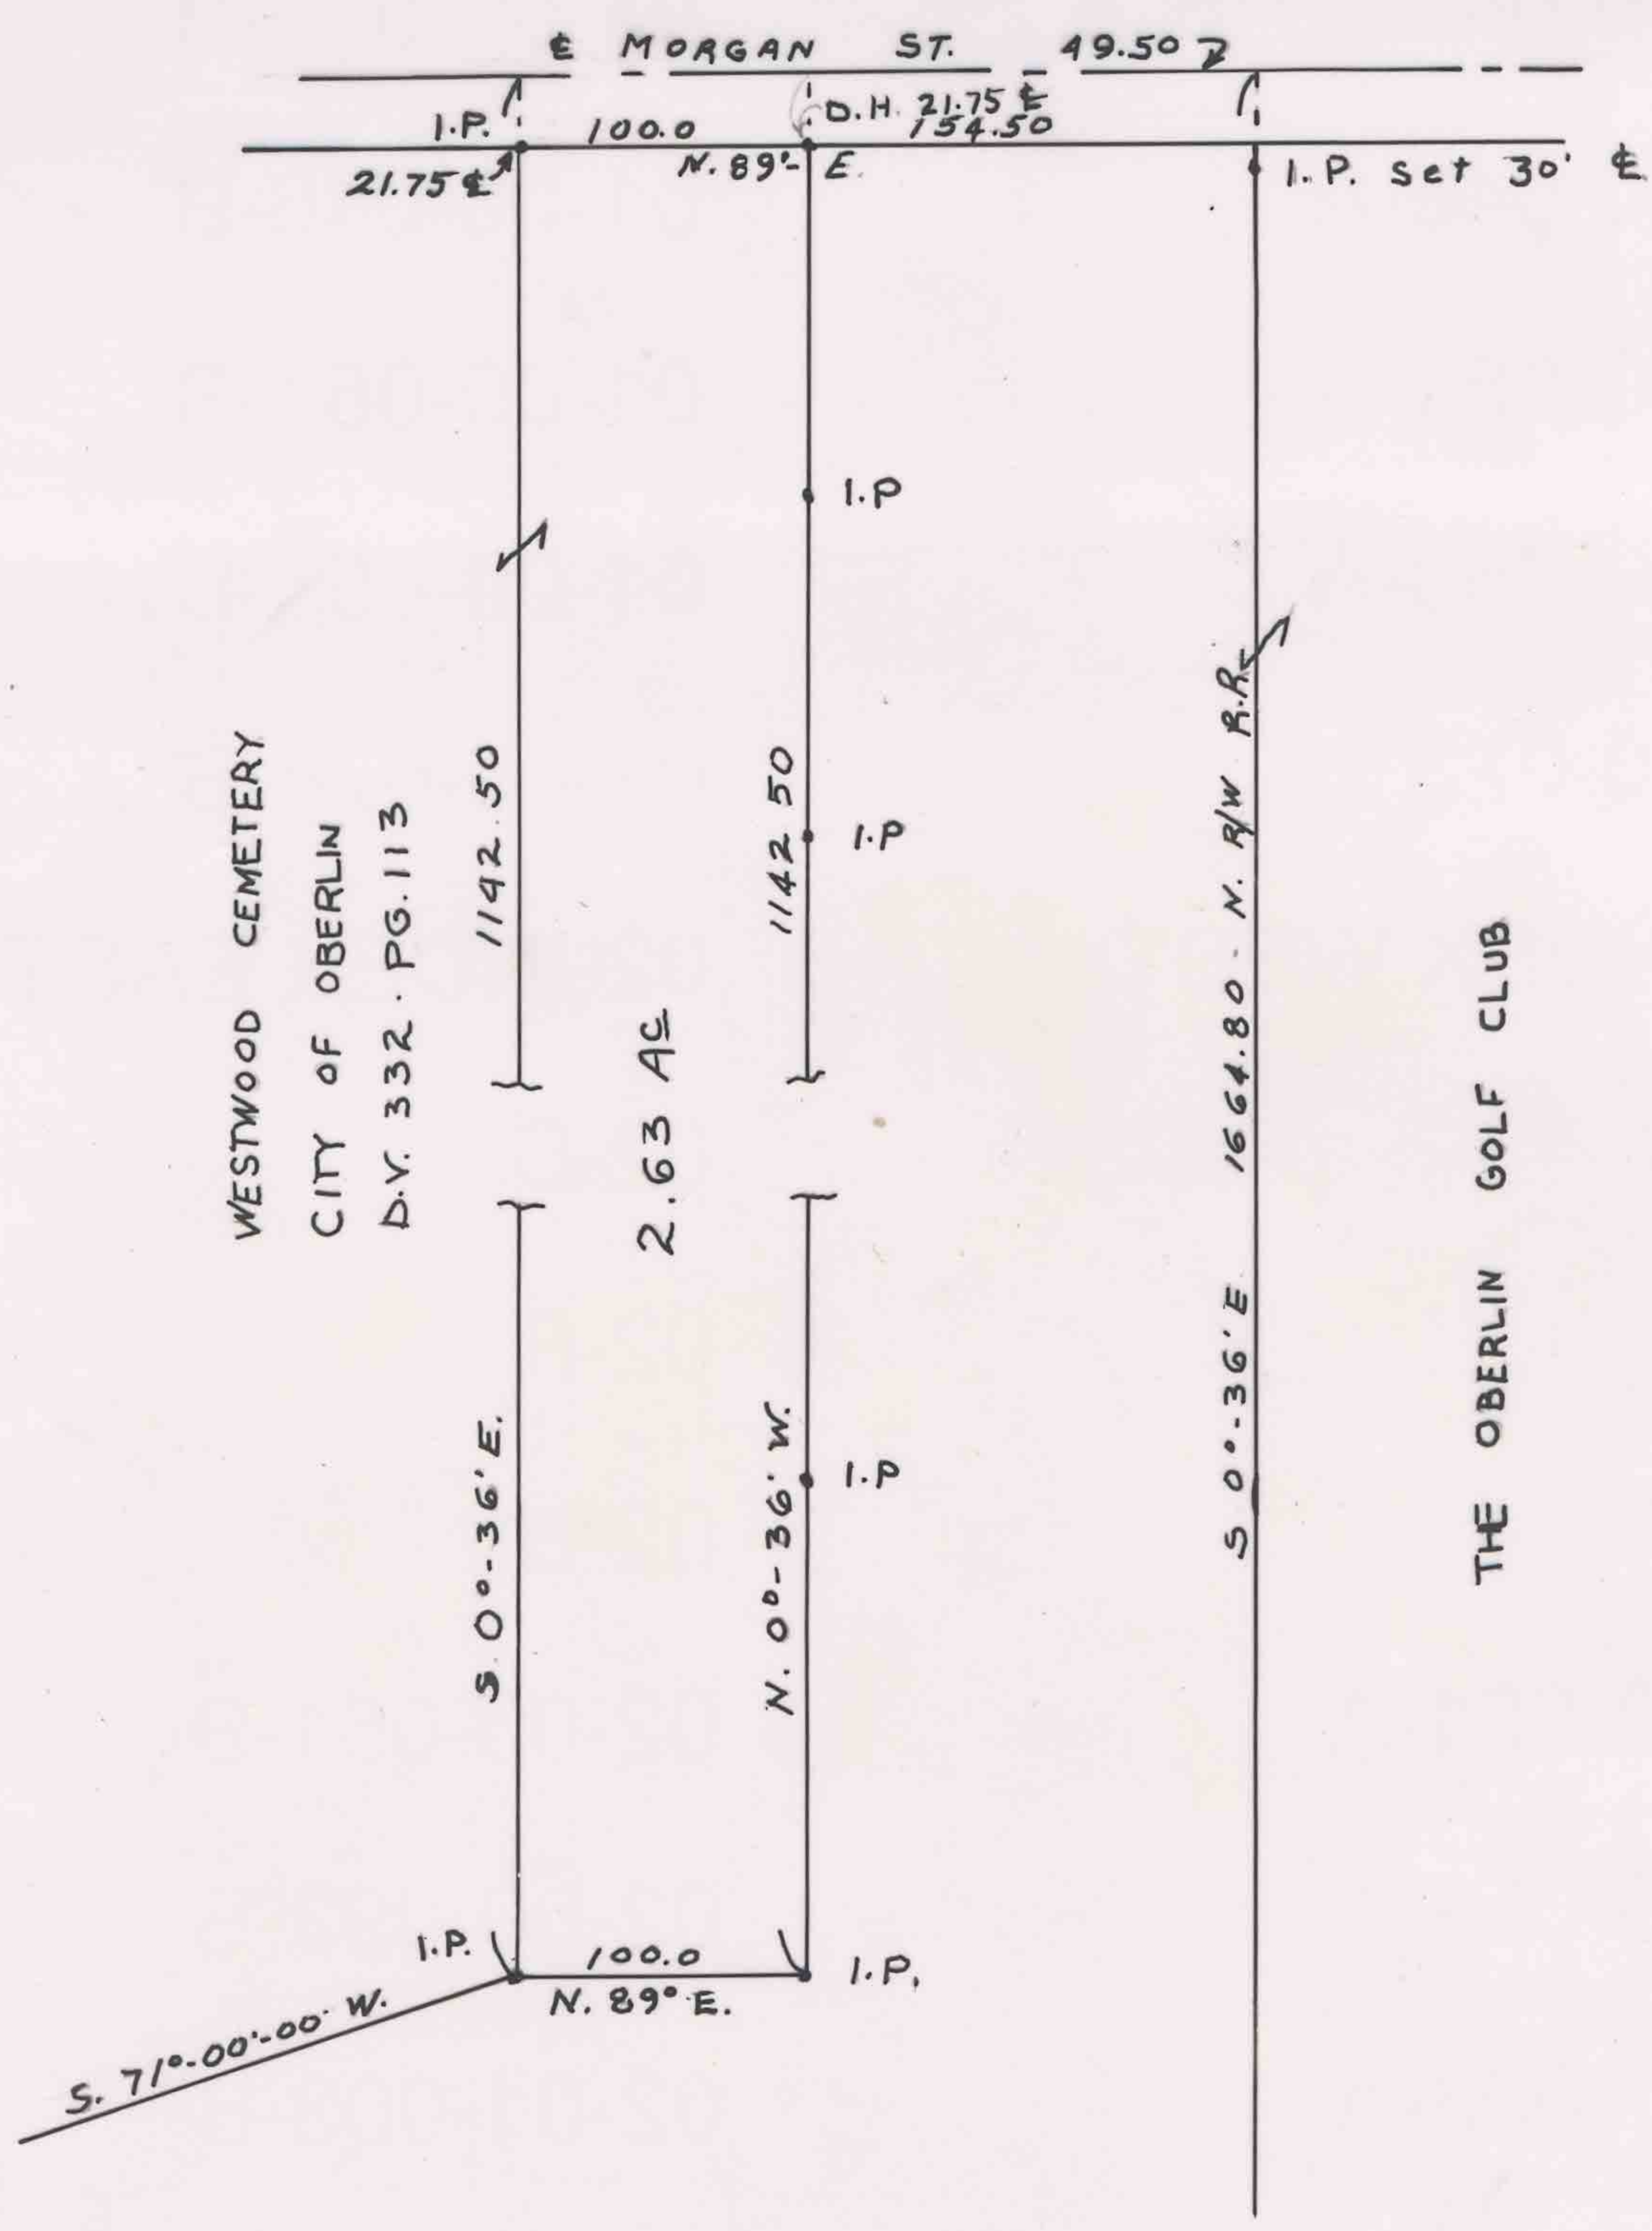

WESTWOOD CEMETERY  
CITY of OBERLIN  
O.L. 94 RUSSIA TWP  
LOR COUNTY - OHIO  
SCALE - 1" = 100'