


9-00-095-104-001
9-00-095-B
SCAN# 46632

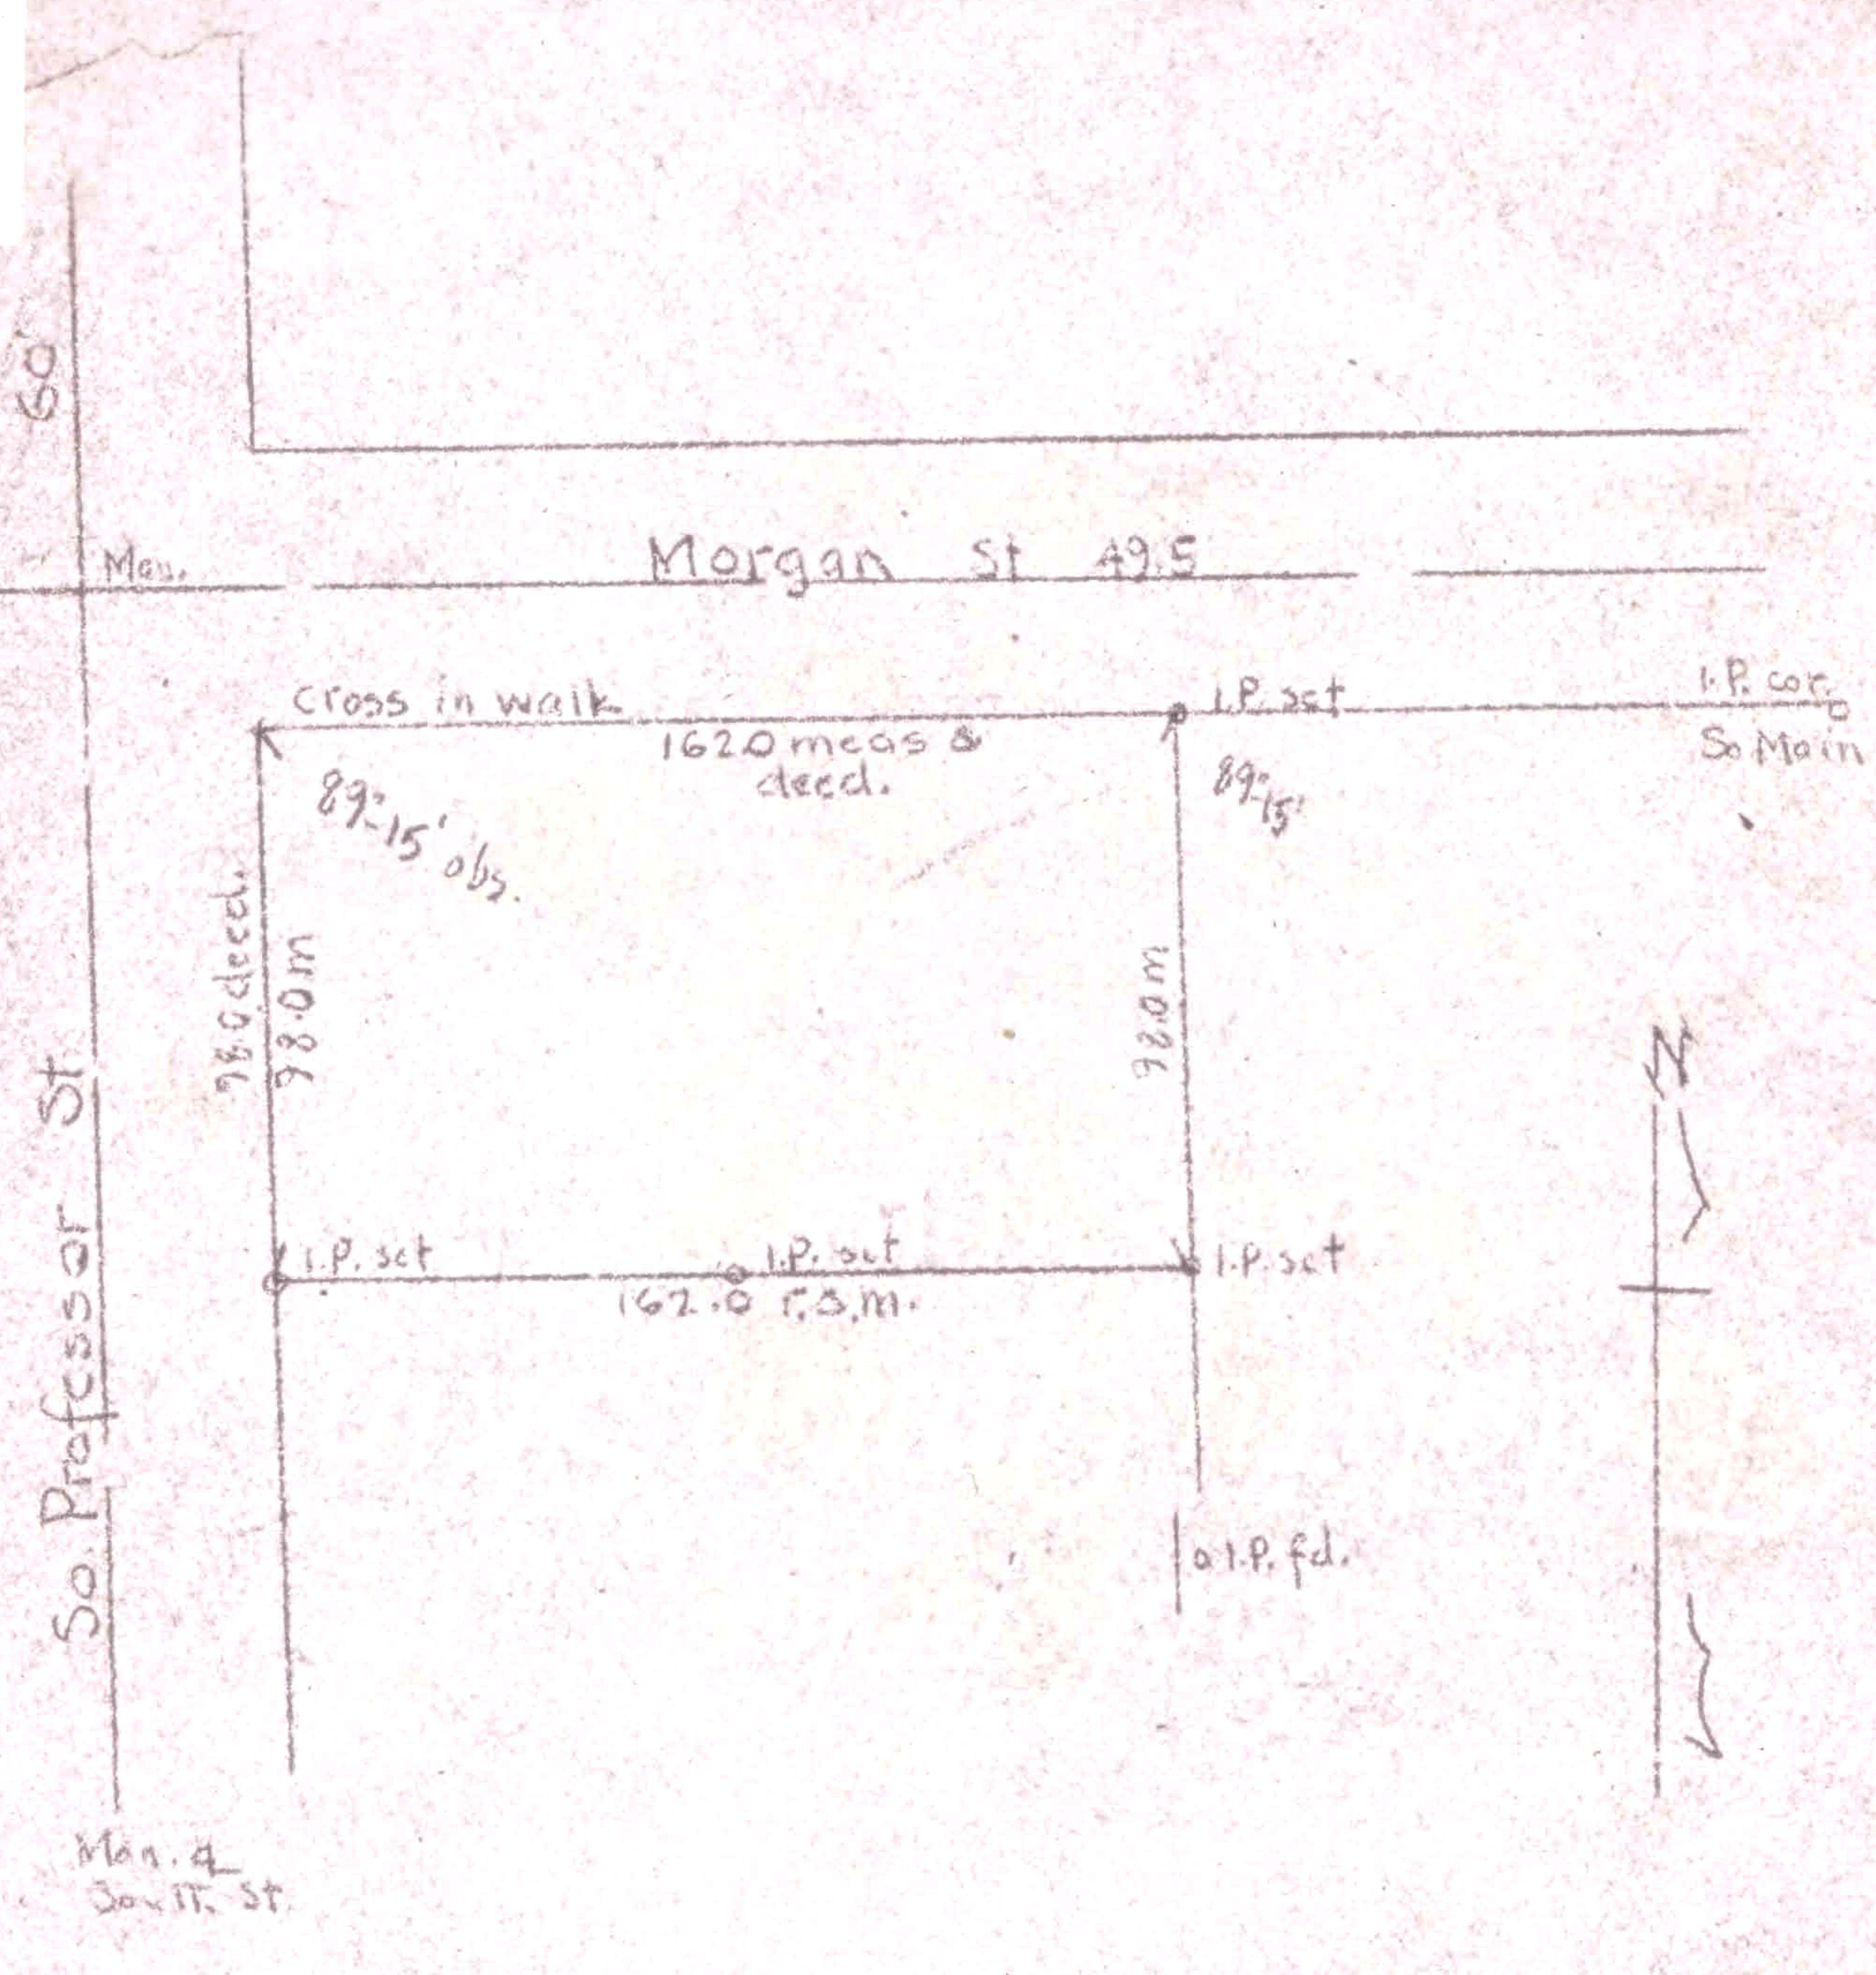

Survey for Mary I. Dick
Lot 9 Bk 2 O.V.P.
Oberlin Village, Lorain Co. Ohio.
Scale 1"=50' 10/8/44
T.W. Laundon Registered Surveyor