


9-00-096-103-025
 9-00-096-103-031
 9-00-096-103-032
 9-00-096-A
 SCAM. #46642

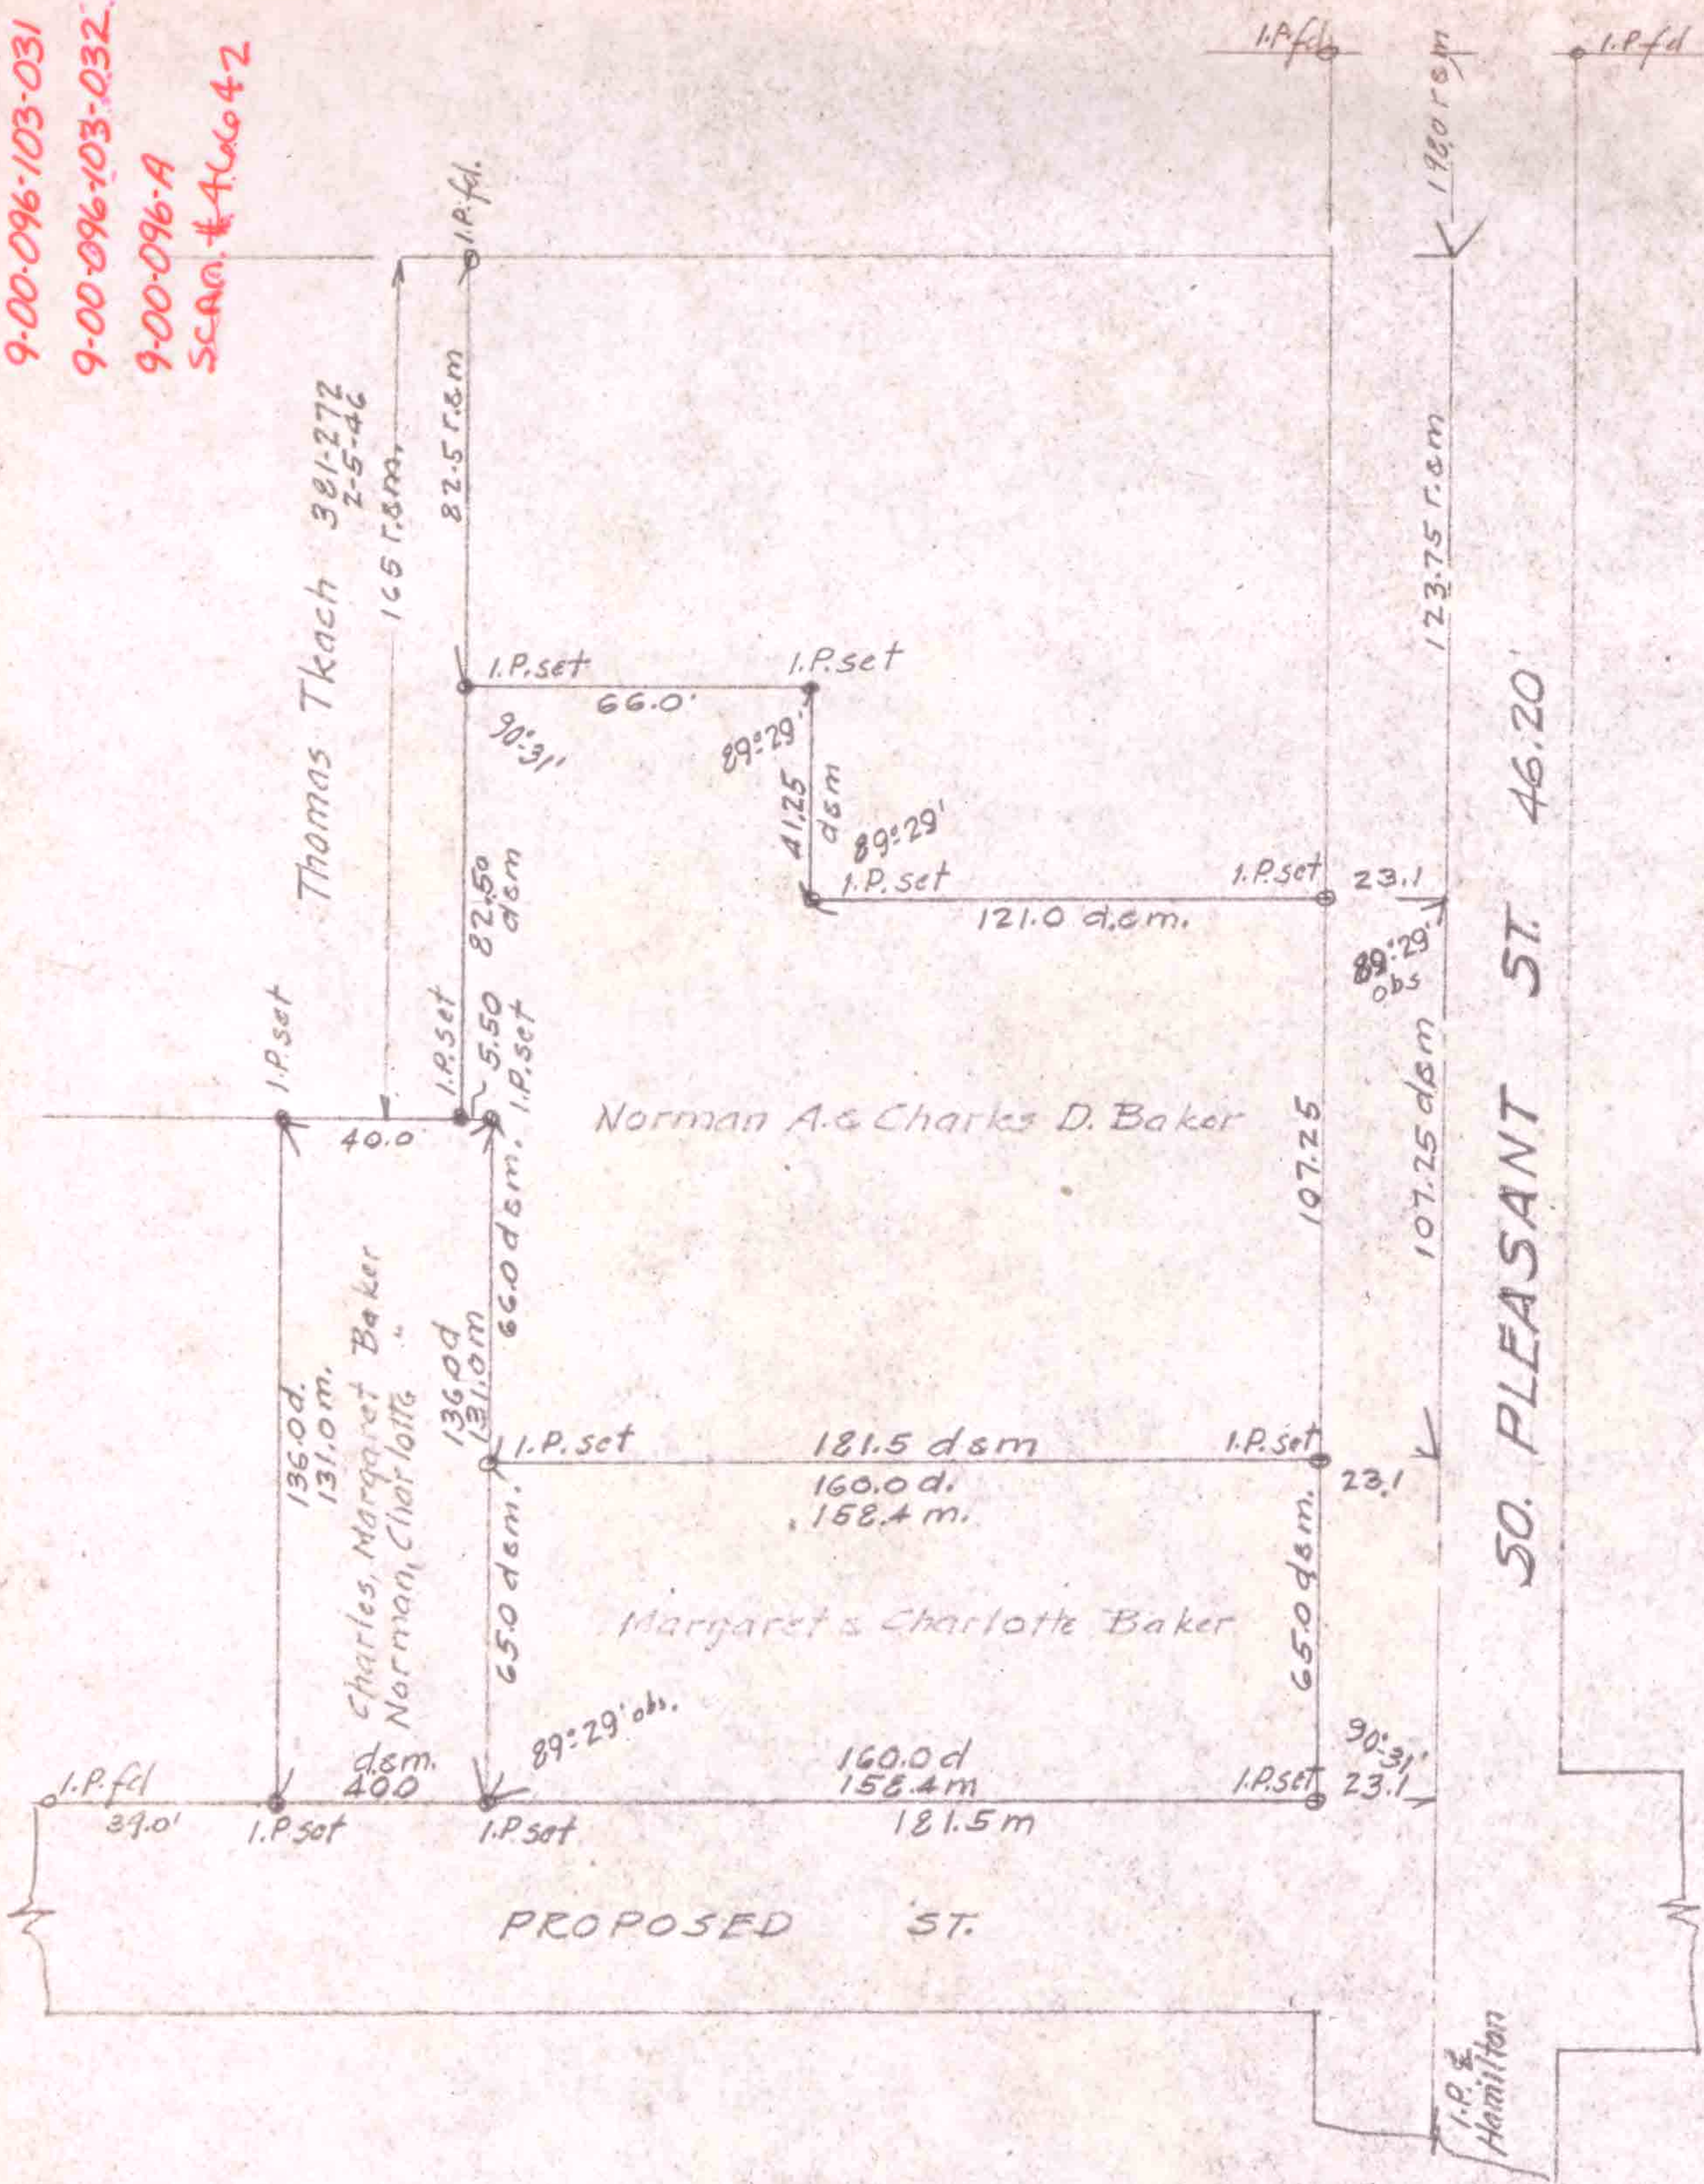

SURVEY FOR
 CHARLES, NORMAN, MARGARET, CHARLOTTE, BAKER
 PART OF ORIGINAL TP LOT 96 RUSSIA TWP
 OBERLIN VILLAGE LORAIN CO. OHIO
 SCALE 1"=50' MAY 6 1950. T.W. LAUNDON REG. SURVEYOR.