


9-00-096-113
9-00-096-A
SCAN # 46654

MARY EDITH MUNSON 4-6-29 D.V. 260-100

ADDIE STOKES 10-10-26 D.V. 222-640

OHIO FUEL 12-31-29 D.V. 252-277
GAS CO.

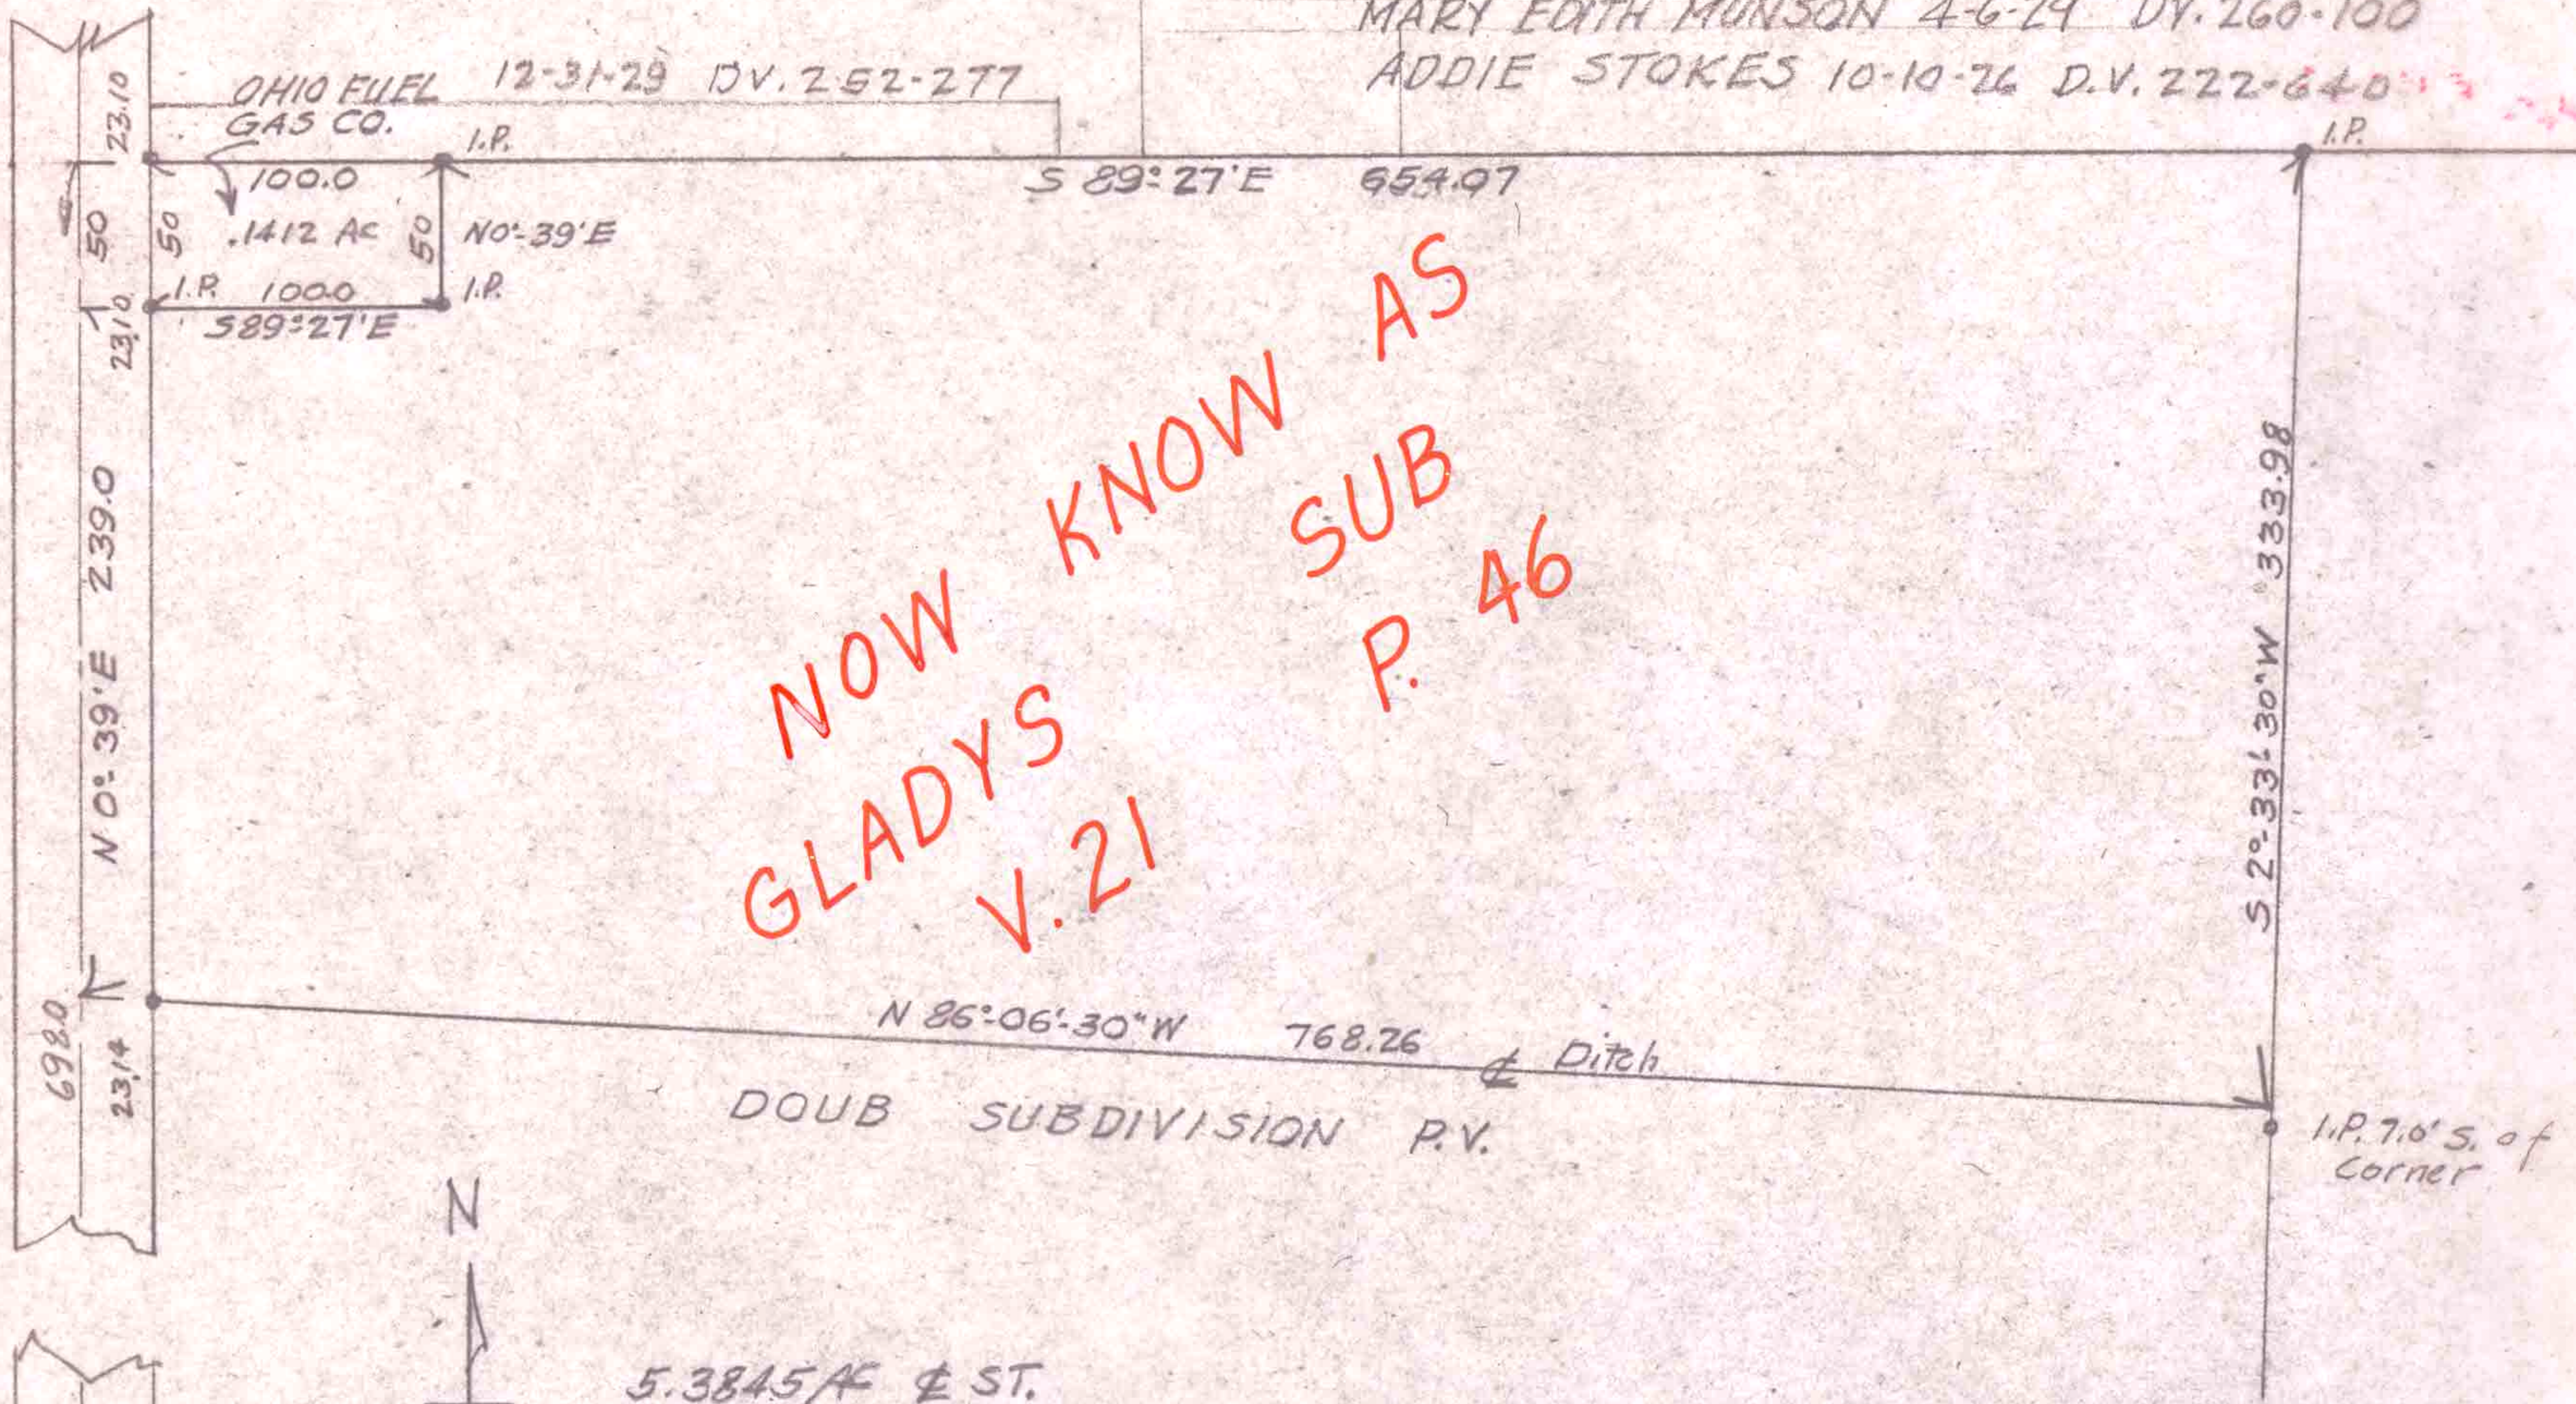

NOW KNOW AS
GLADYS SUB
V. 21 P. 46

DOUB SUBDIVISION P.V.

5.3845 AC ± ST.

50. PLEASANT ST. 46.20

N 0° 39' E 239.0

S 89° 27' E 654.97

S 89° 27' E 100.0

N 0° 39' E 50

N 86° 06' 30" W 768.26

S 2° 33' 30" W 333.98

698.0

231.4

HAMILTON ST.

SURVEY FOR ANTHONY A. & LANA T. LINDEN
PART OF TWP LOT 96 RUSSIA TWP. R.
CITY OF OBERLIN. LORAIN CO. OHIO.

SCALE 1" = 100'
T.W. LAUNDON REG. SURVEYOR No 689

JUNE 16, 1952