


9-00-099-B
SCAN# 46059

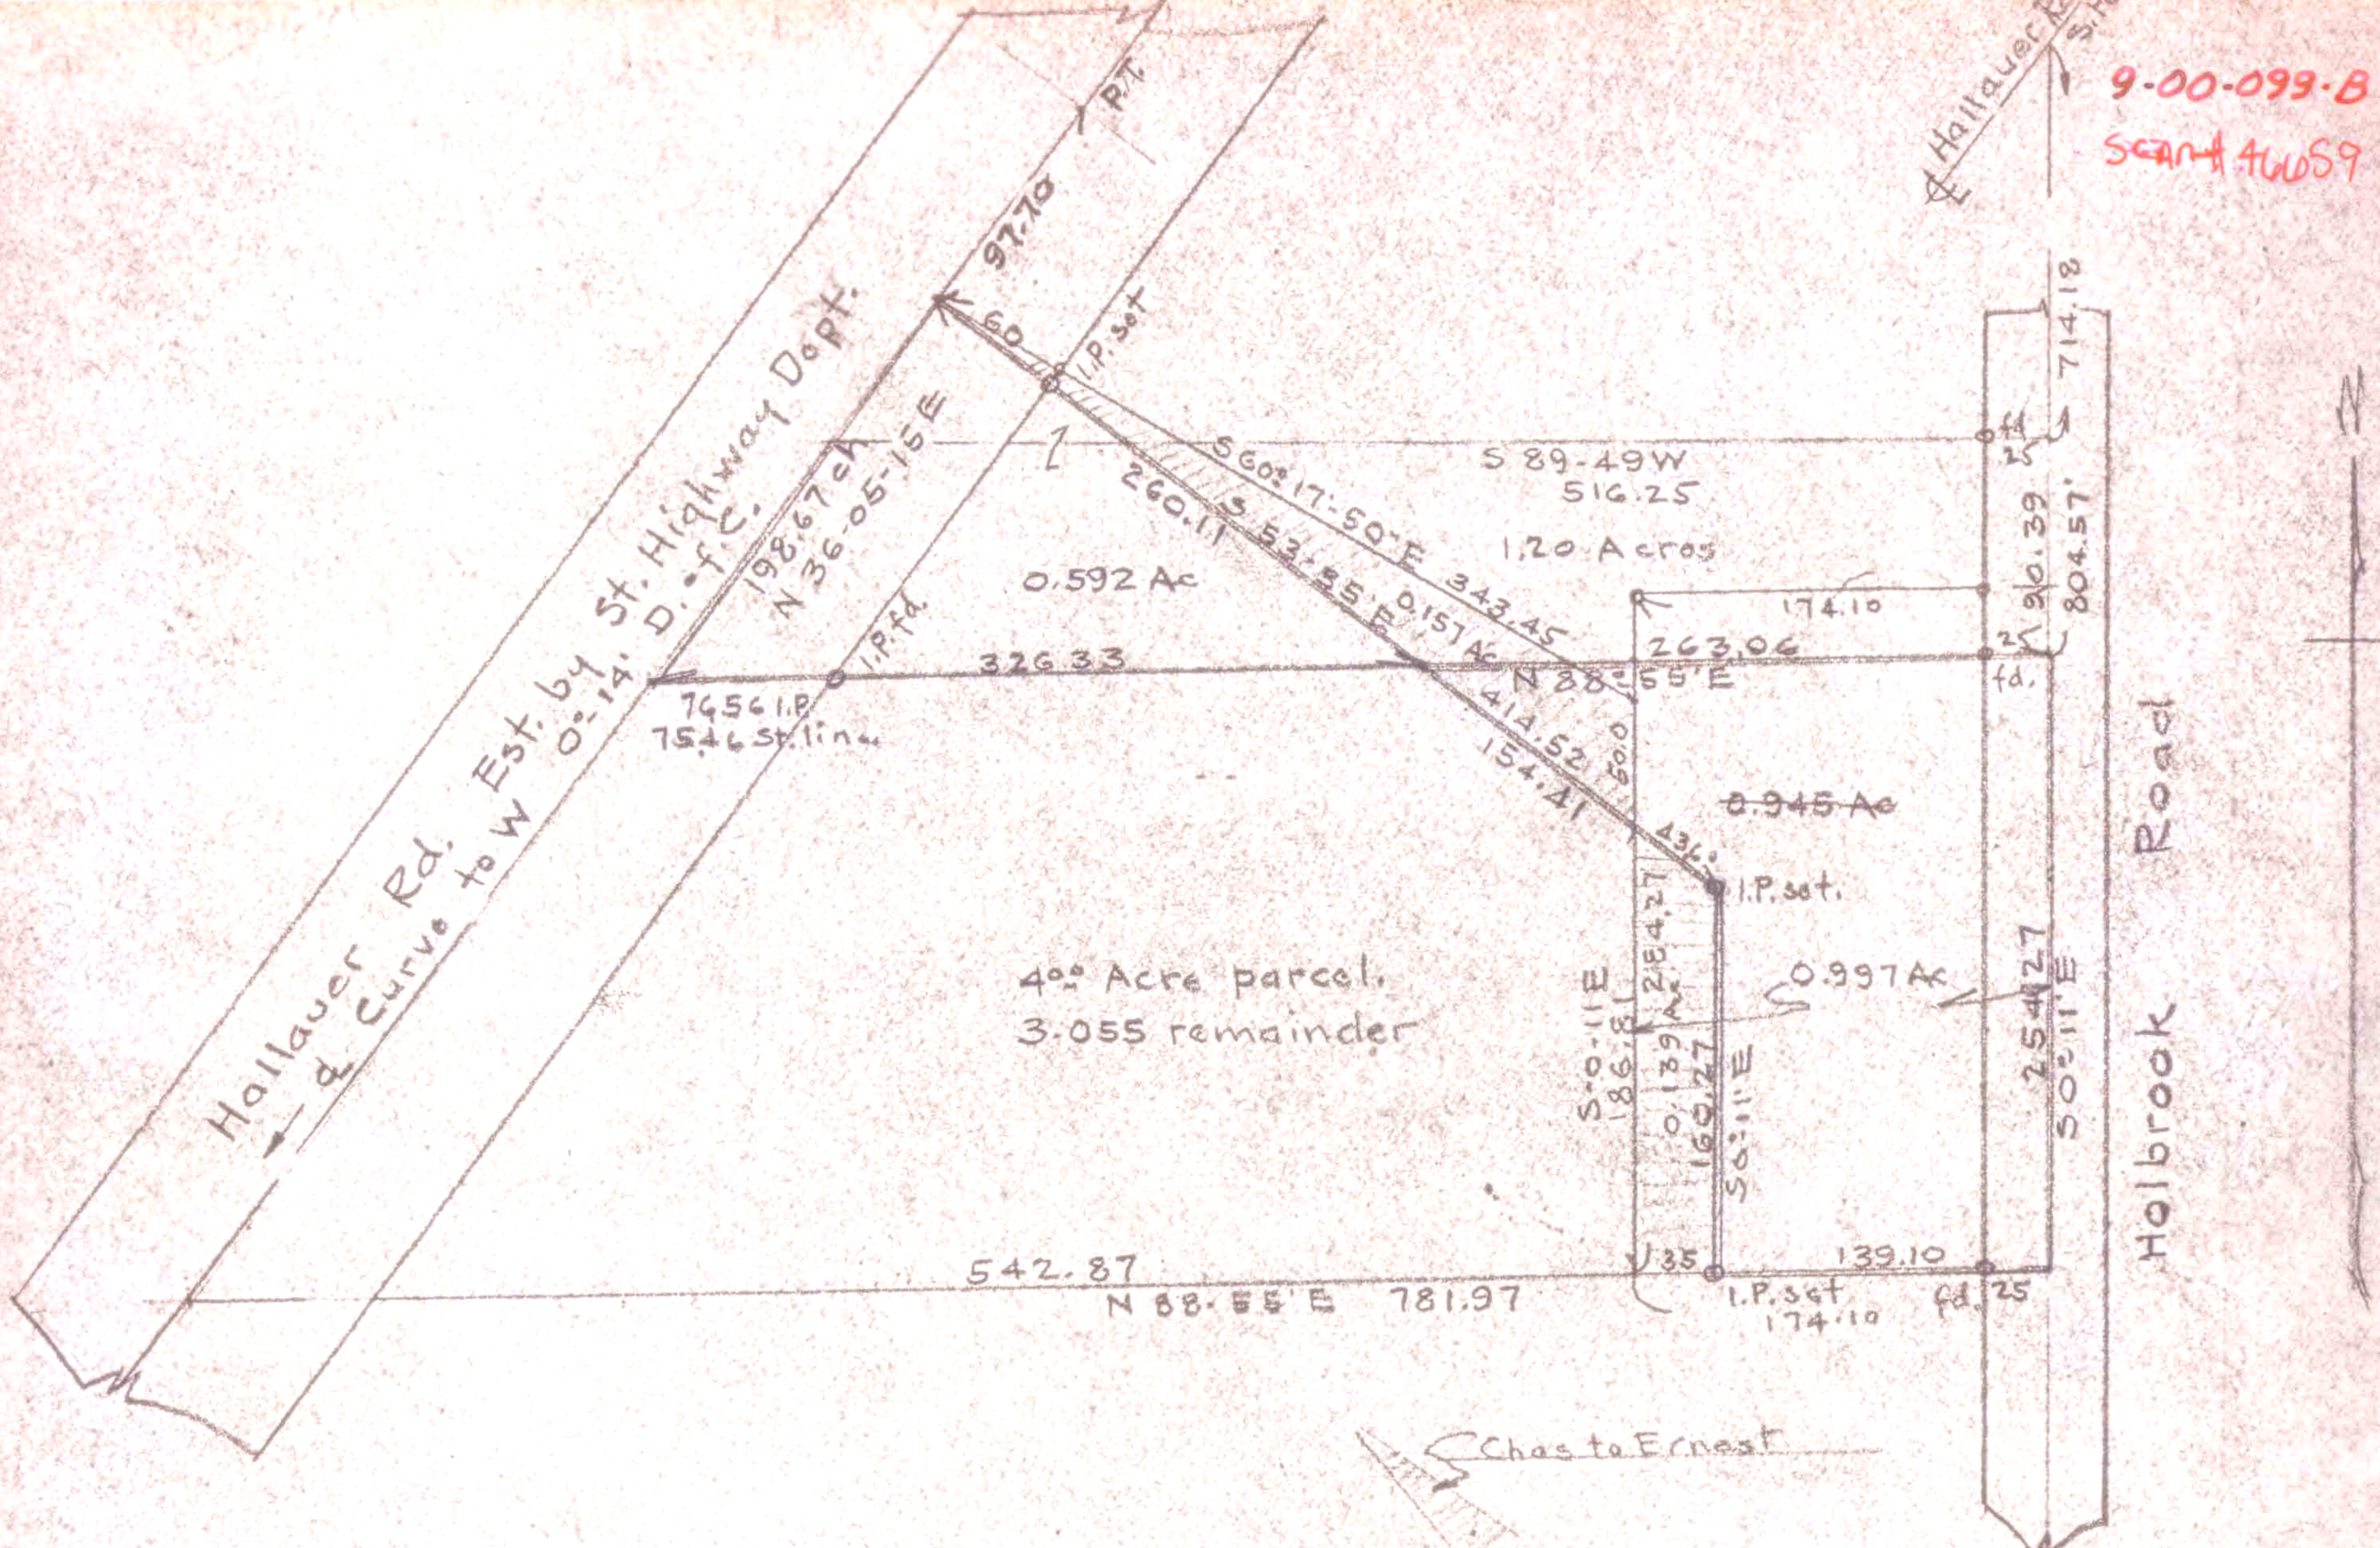

0.592 Ac. C.H. to E.I.B.
 0.945 " E.I.B. to C.H.



Survey for Chas. H. & Ernest I Brooks.
 Part of Orig Twp Lot 99 Russia Twp.
 Lorain Co. Ohio

Scale 1" = 100'

June 10, 1949 T.W. Laundon Registered Surveyor

Revised Apr. 29, 1955