9-00-108-000-026
9-00-108-B
SCAN # 4 Adjacent
Parcel

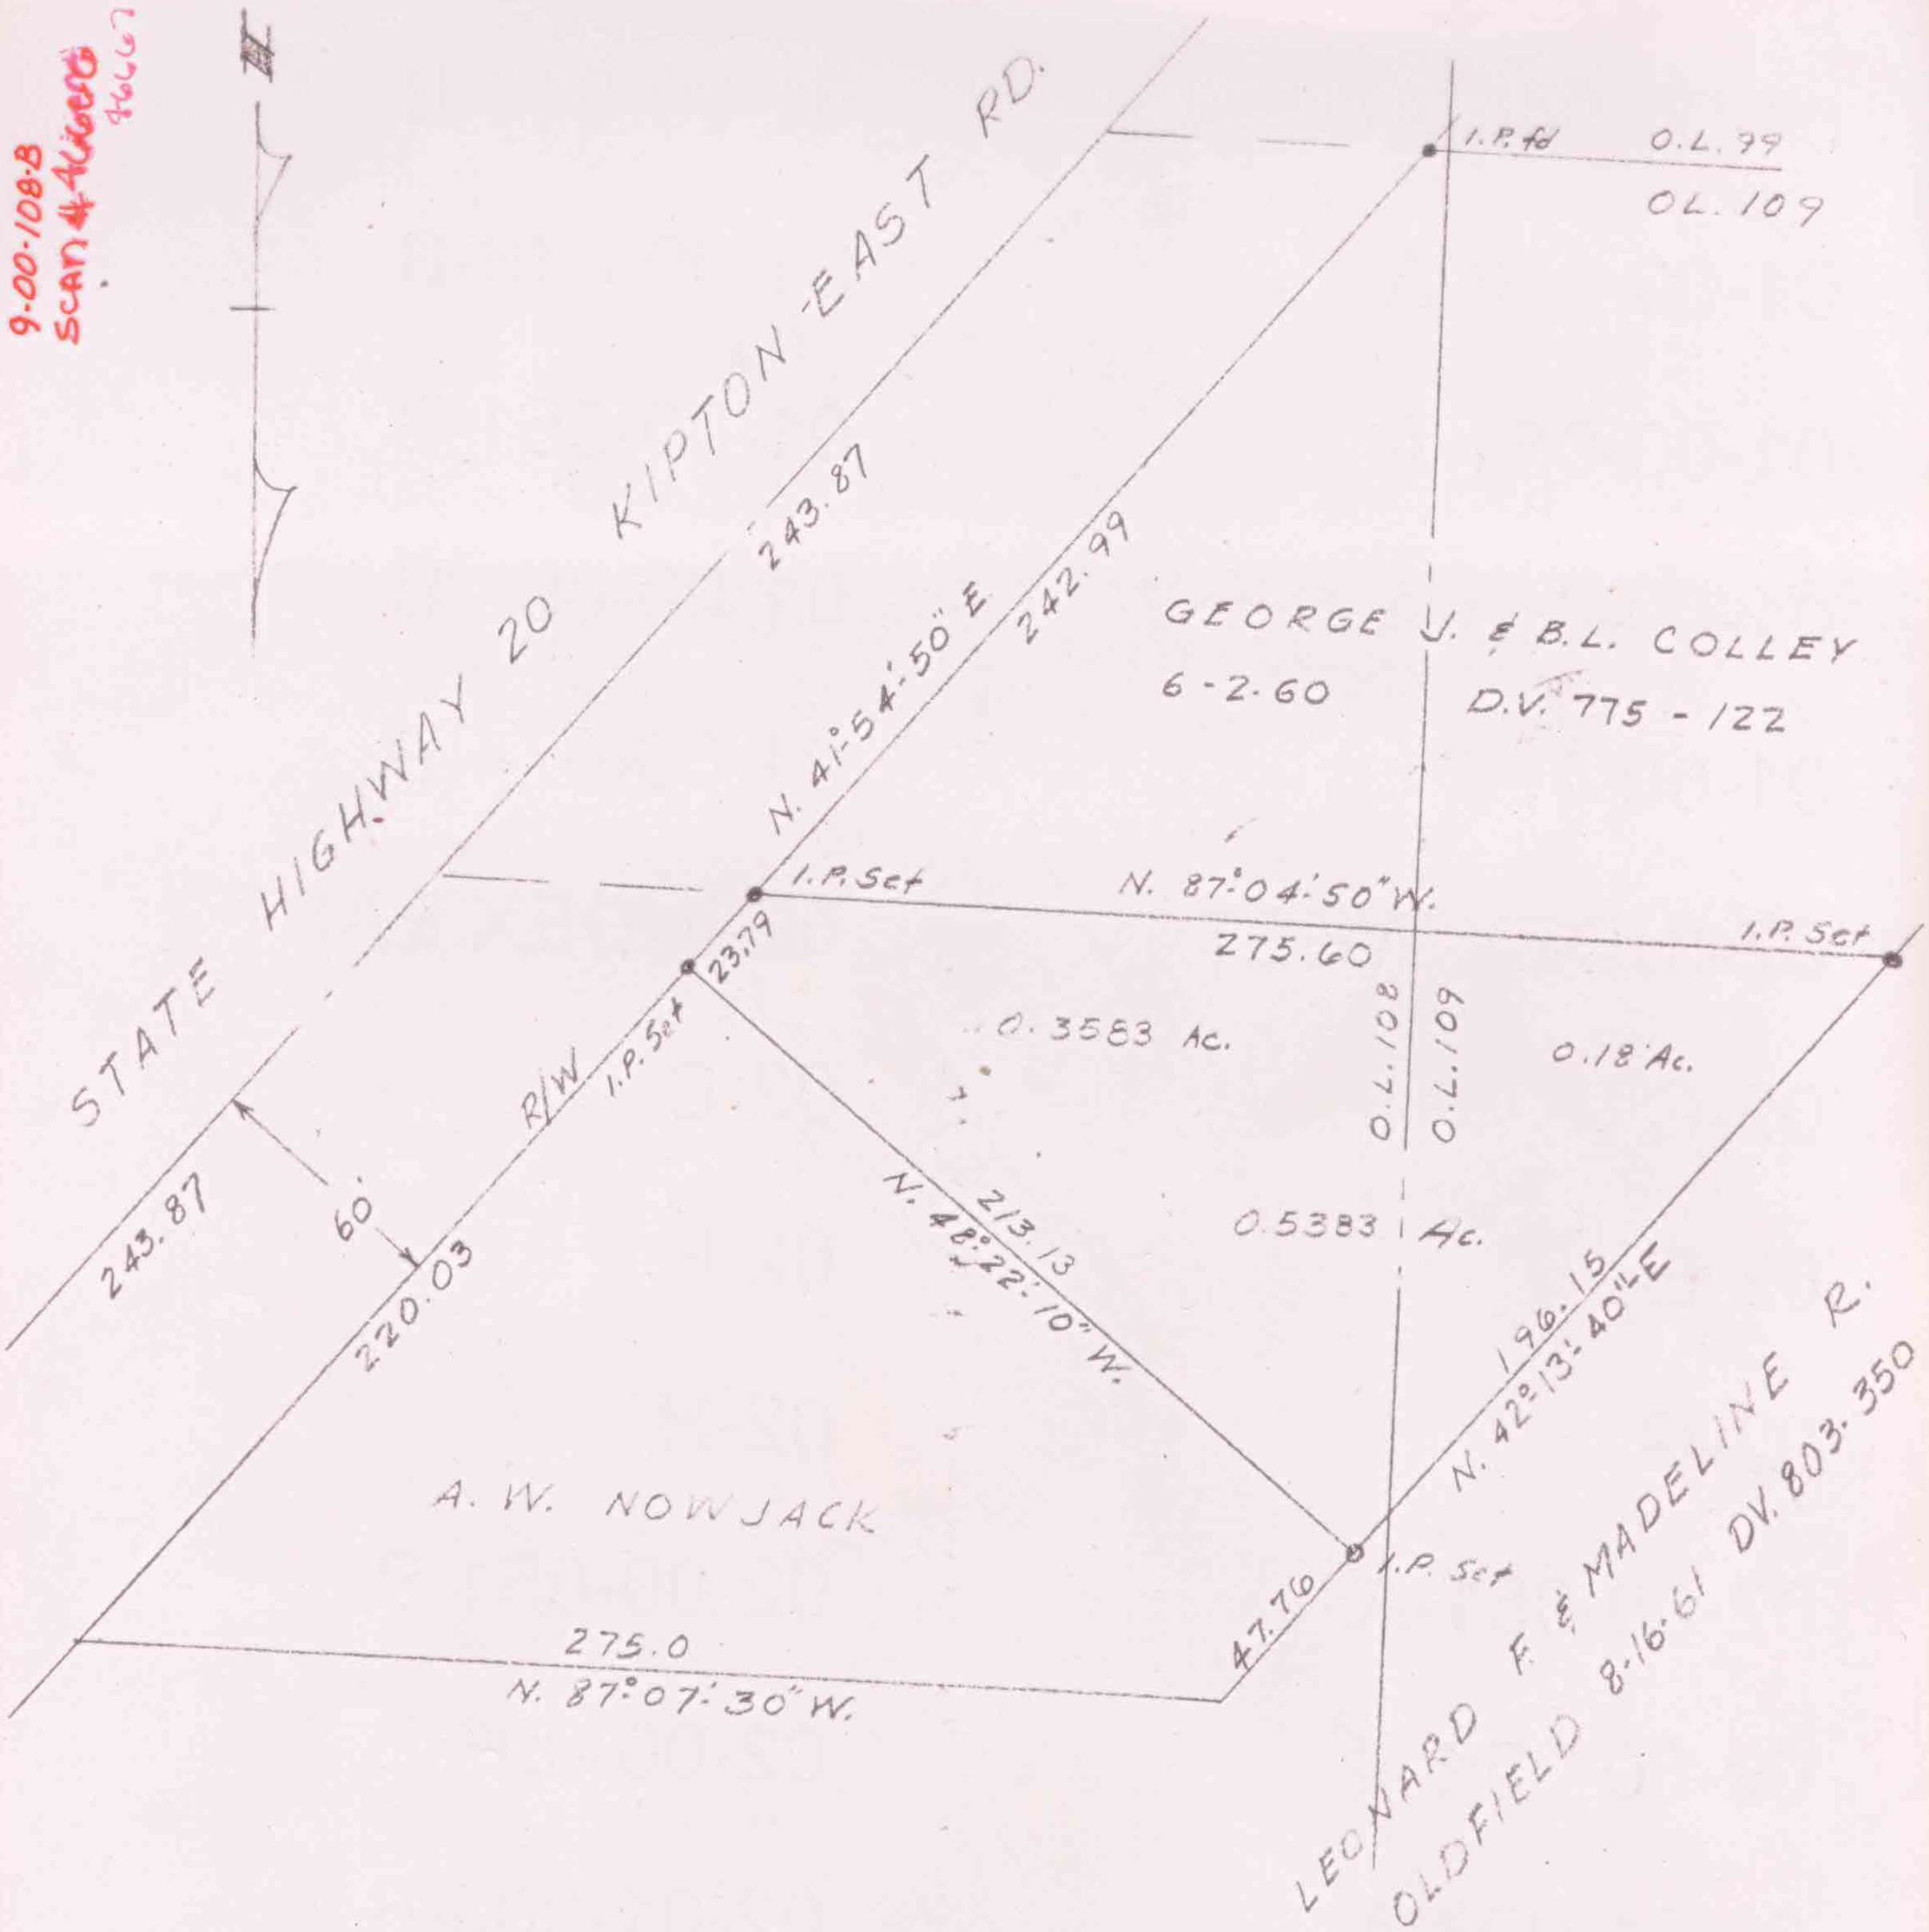

SURVEY FOR A. W. NOWJACK
PARTS OF O.L.'s 108 & 109 RUSSIA TWP.
LORAIN CO. OHIO SCALE 1"=60 10-31-62
LAUNDON & HUFFMAN - REG. SURVEYORS