


10-00-001-102-018
10-00-001-H
Scan #46669

Municipal Engineering
Surveys - City, Farm,
Sub-divisions

THOMAS W. LAUNDON
CIVIL ENGINEER AND SURVEYOR
405 Elyria Building
ELYRIA - OHIO

State of Ohio
Registered Professional
Engineer and Surveyor
Phone Home 2094
Office 3211

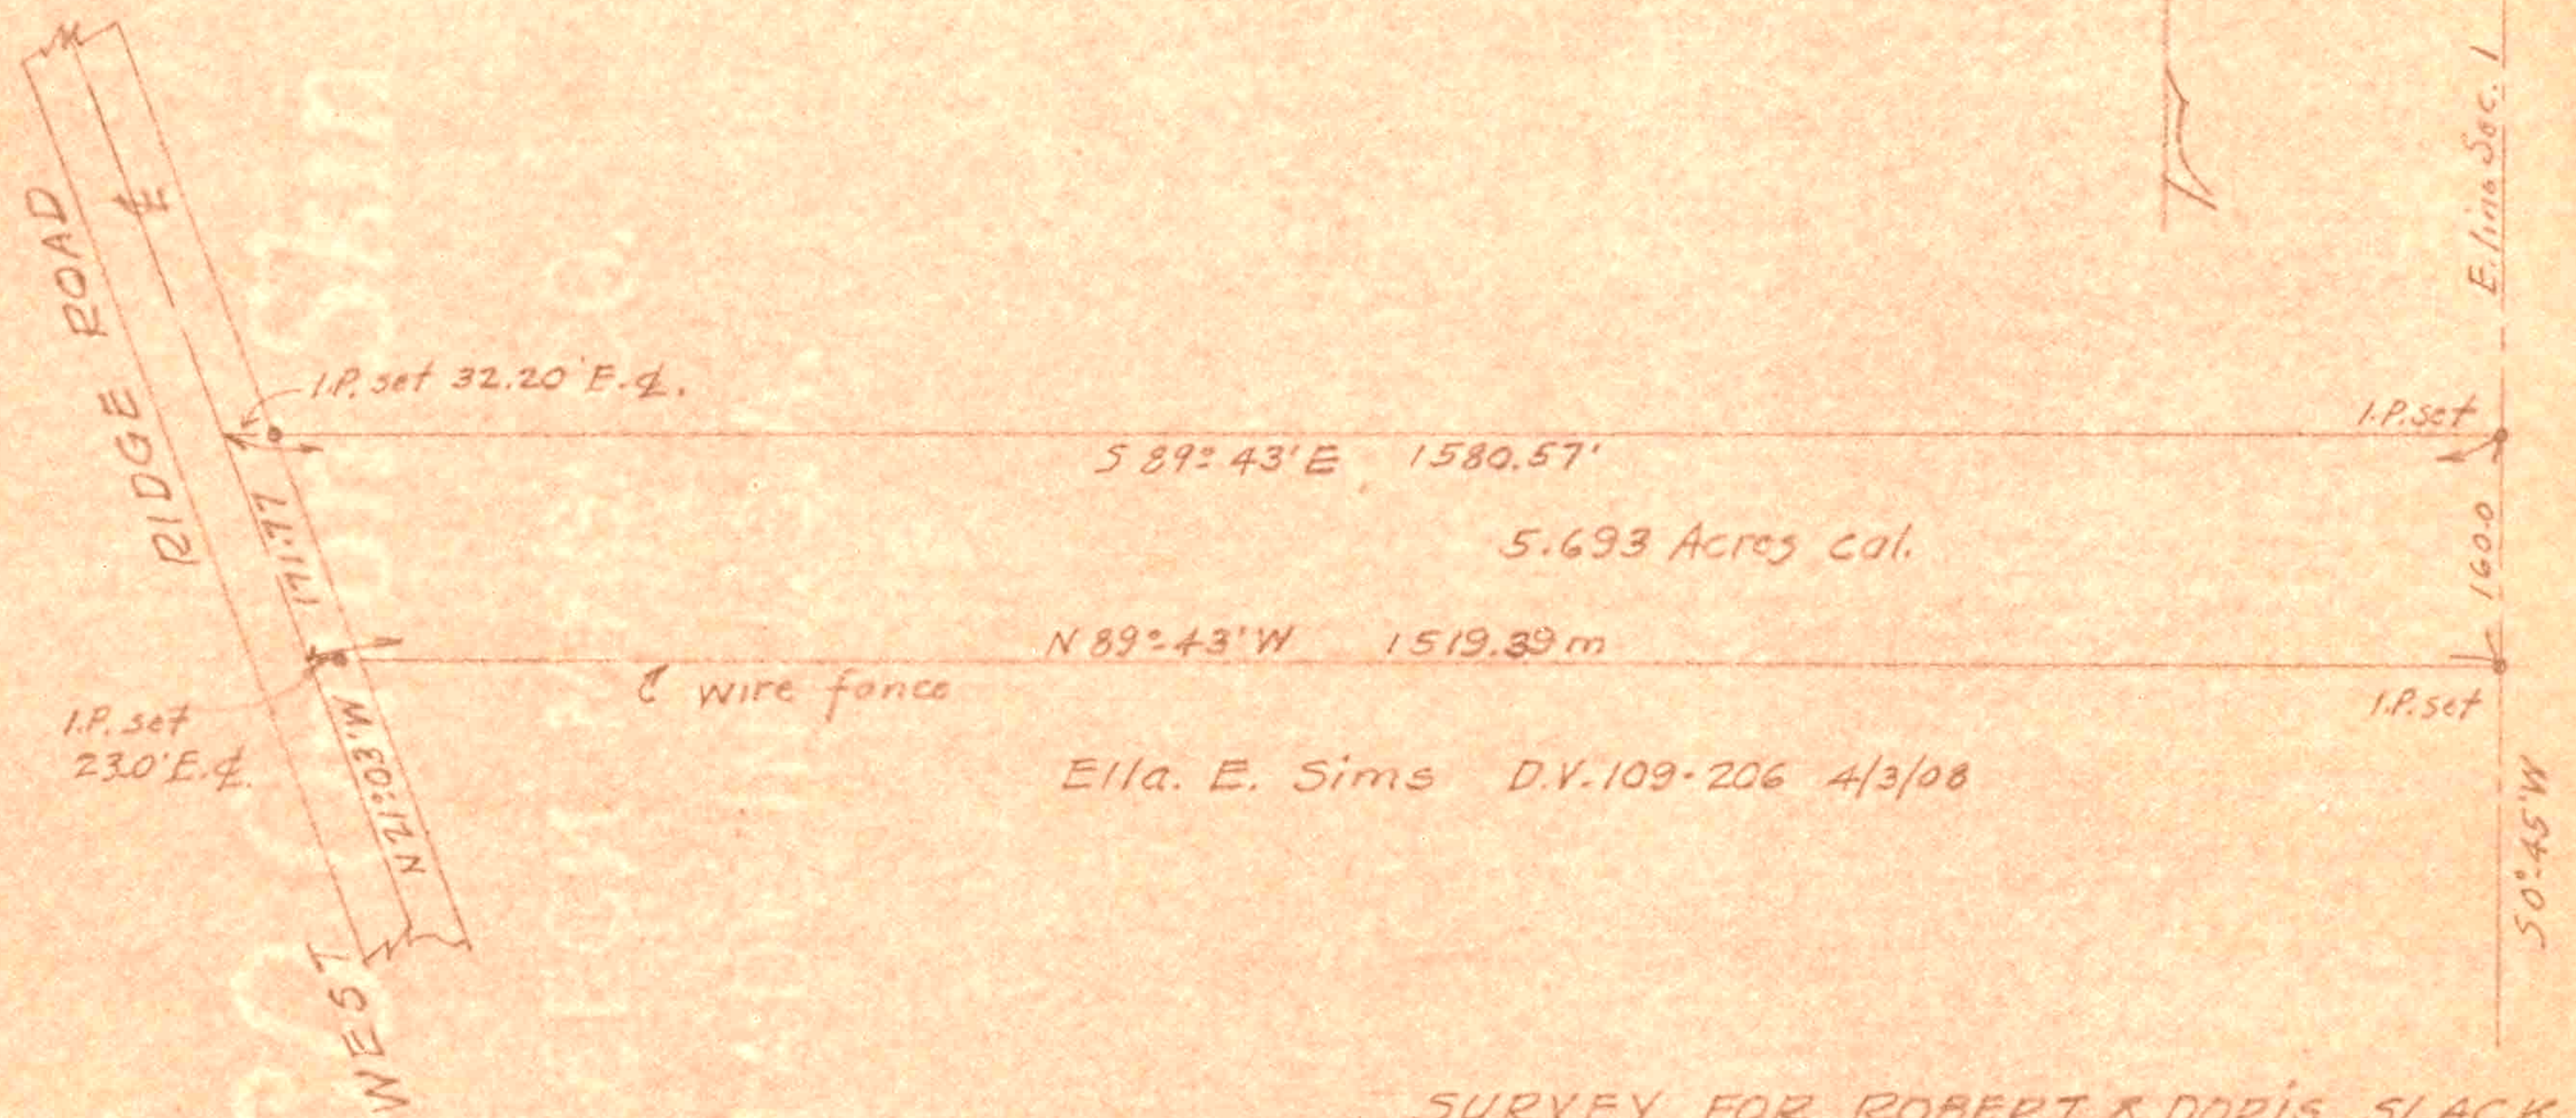

SURVEY FOR ROBERT & DORIS, SLACK
PART OF ORIG. SEC. 1. CARLISLE TWP.
LORAIN CO. OHIO. SCALE 1" = 200'
FEBY, 18, 1947 T.W. LAUNDON, REG. SURVEYOR.