Scan # 4ue74 10-00-003-131 10-00-003-G

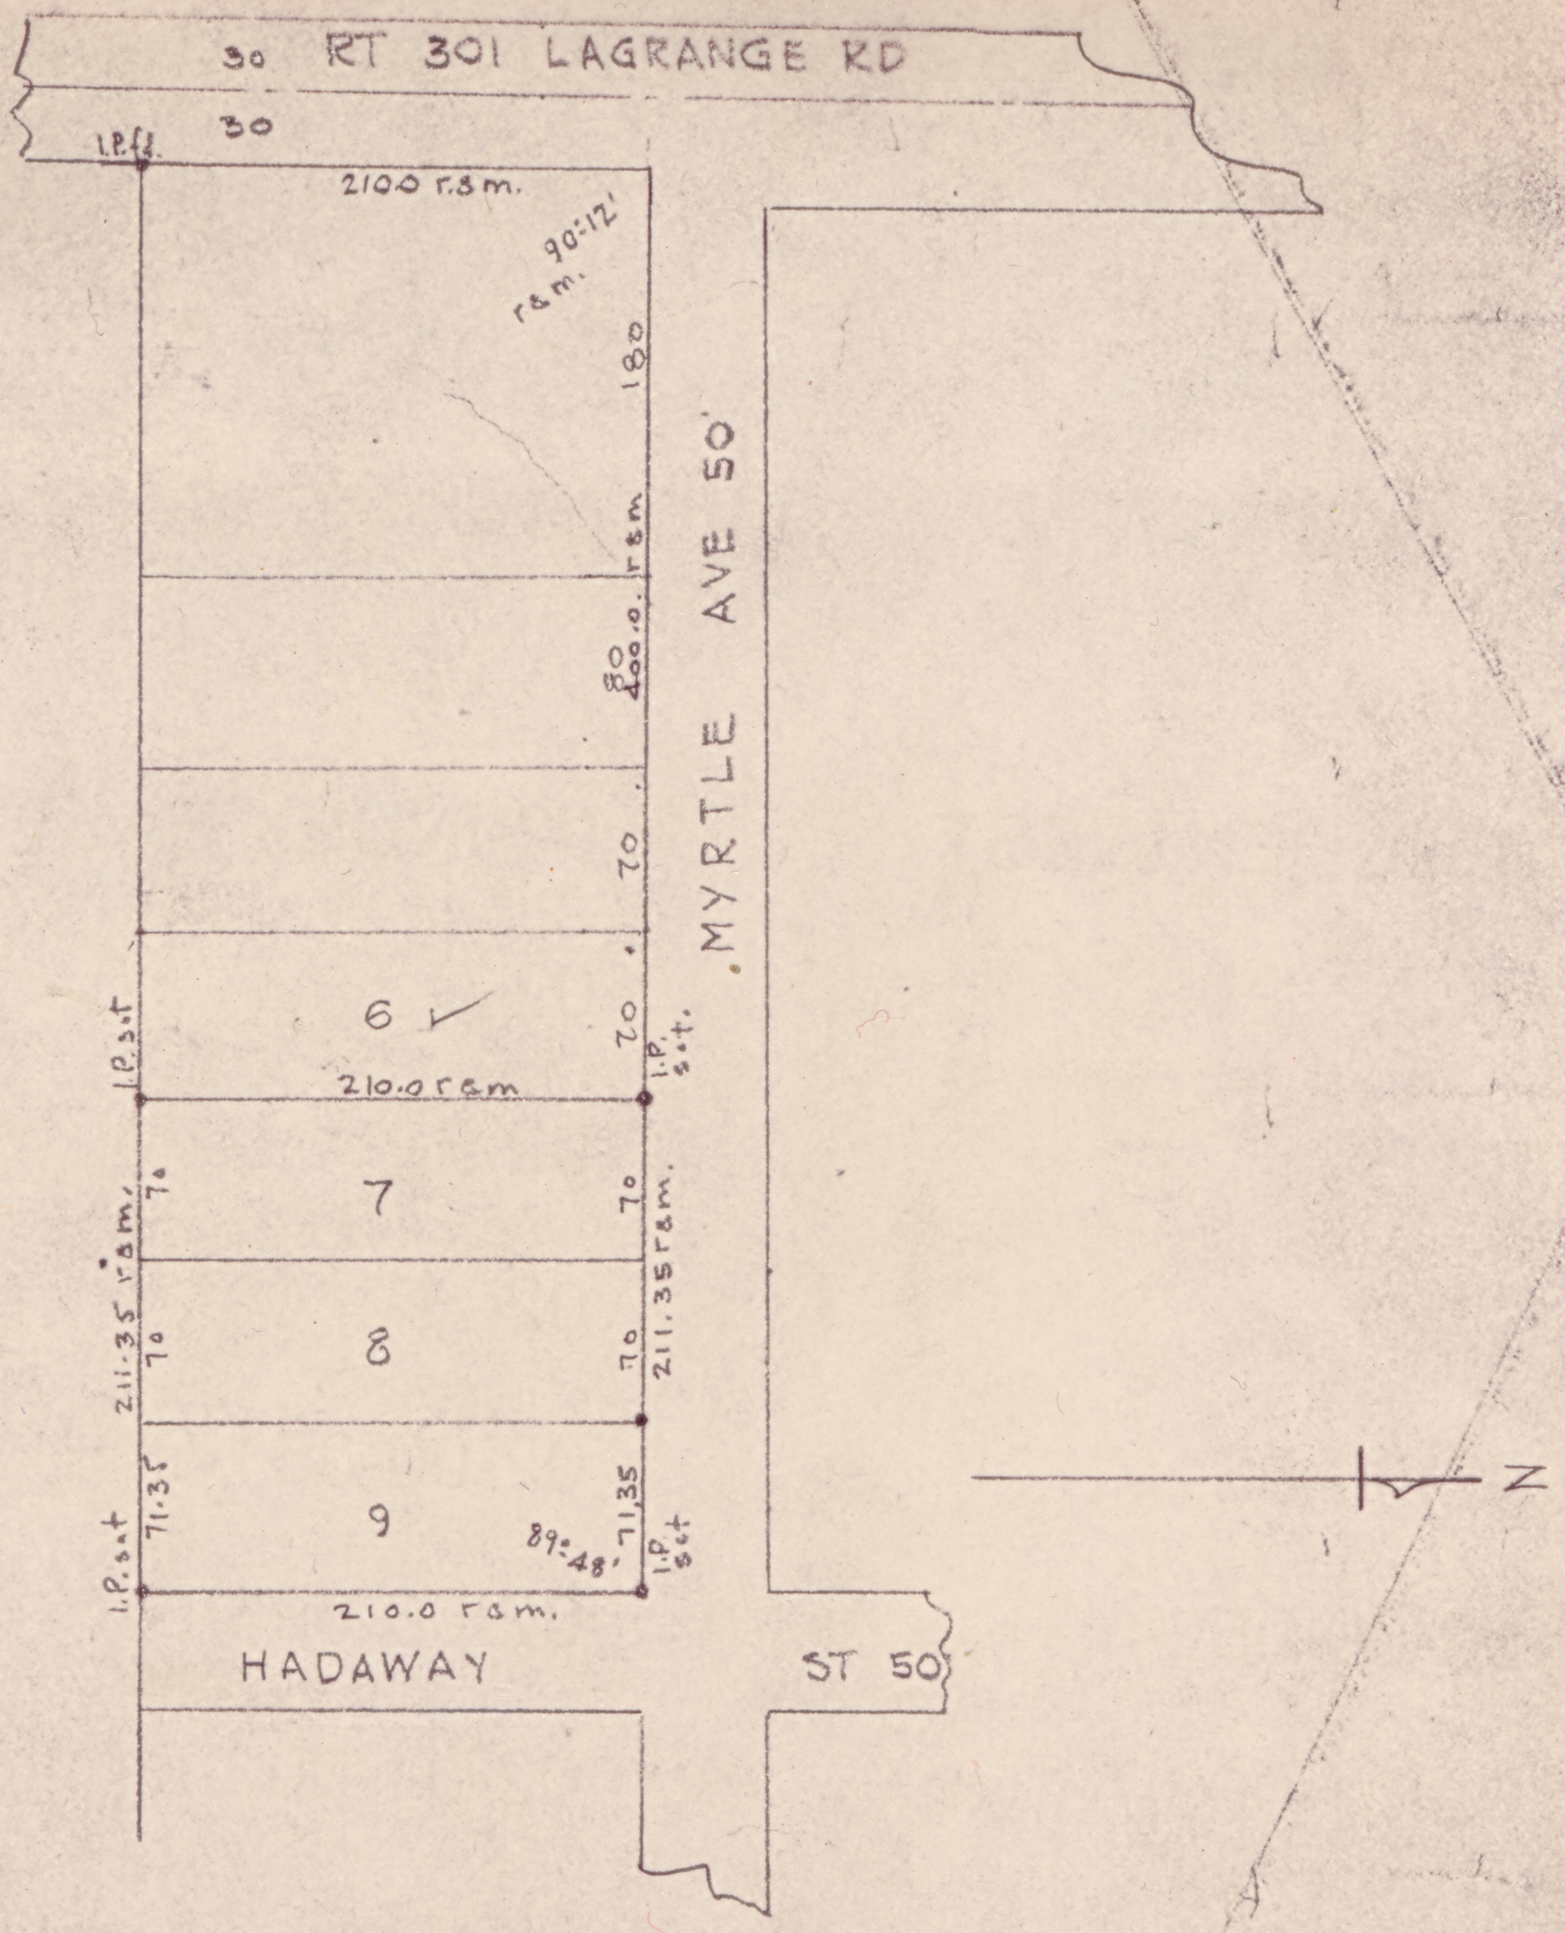

NO ENCROACHMENTS FOUND

SURVEY FOR ELYRIA SAVINGS & TRUST CO
LOTS 7-8-9 HADAWAY ALLOTMENT-PRO-
PT SEC-3- CARLISLE TP. LORAIN CO OHIO
SCALE 1"=100' OCT. 14-1957
T.W. LAUNDON REG. SURVEYOR