


10-00-005-102-  
10-00-005-6  
SCAN#46680

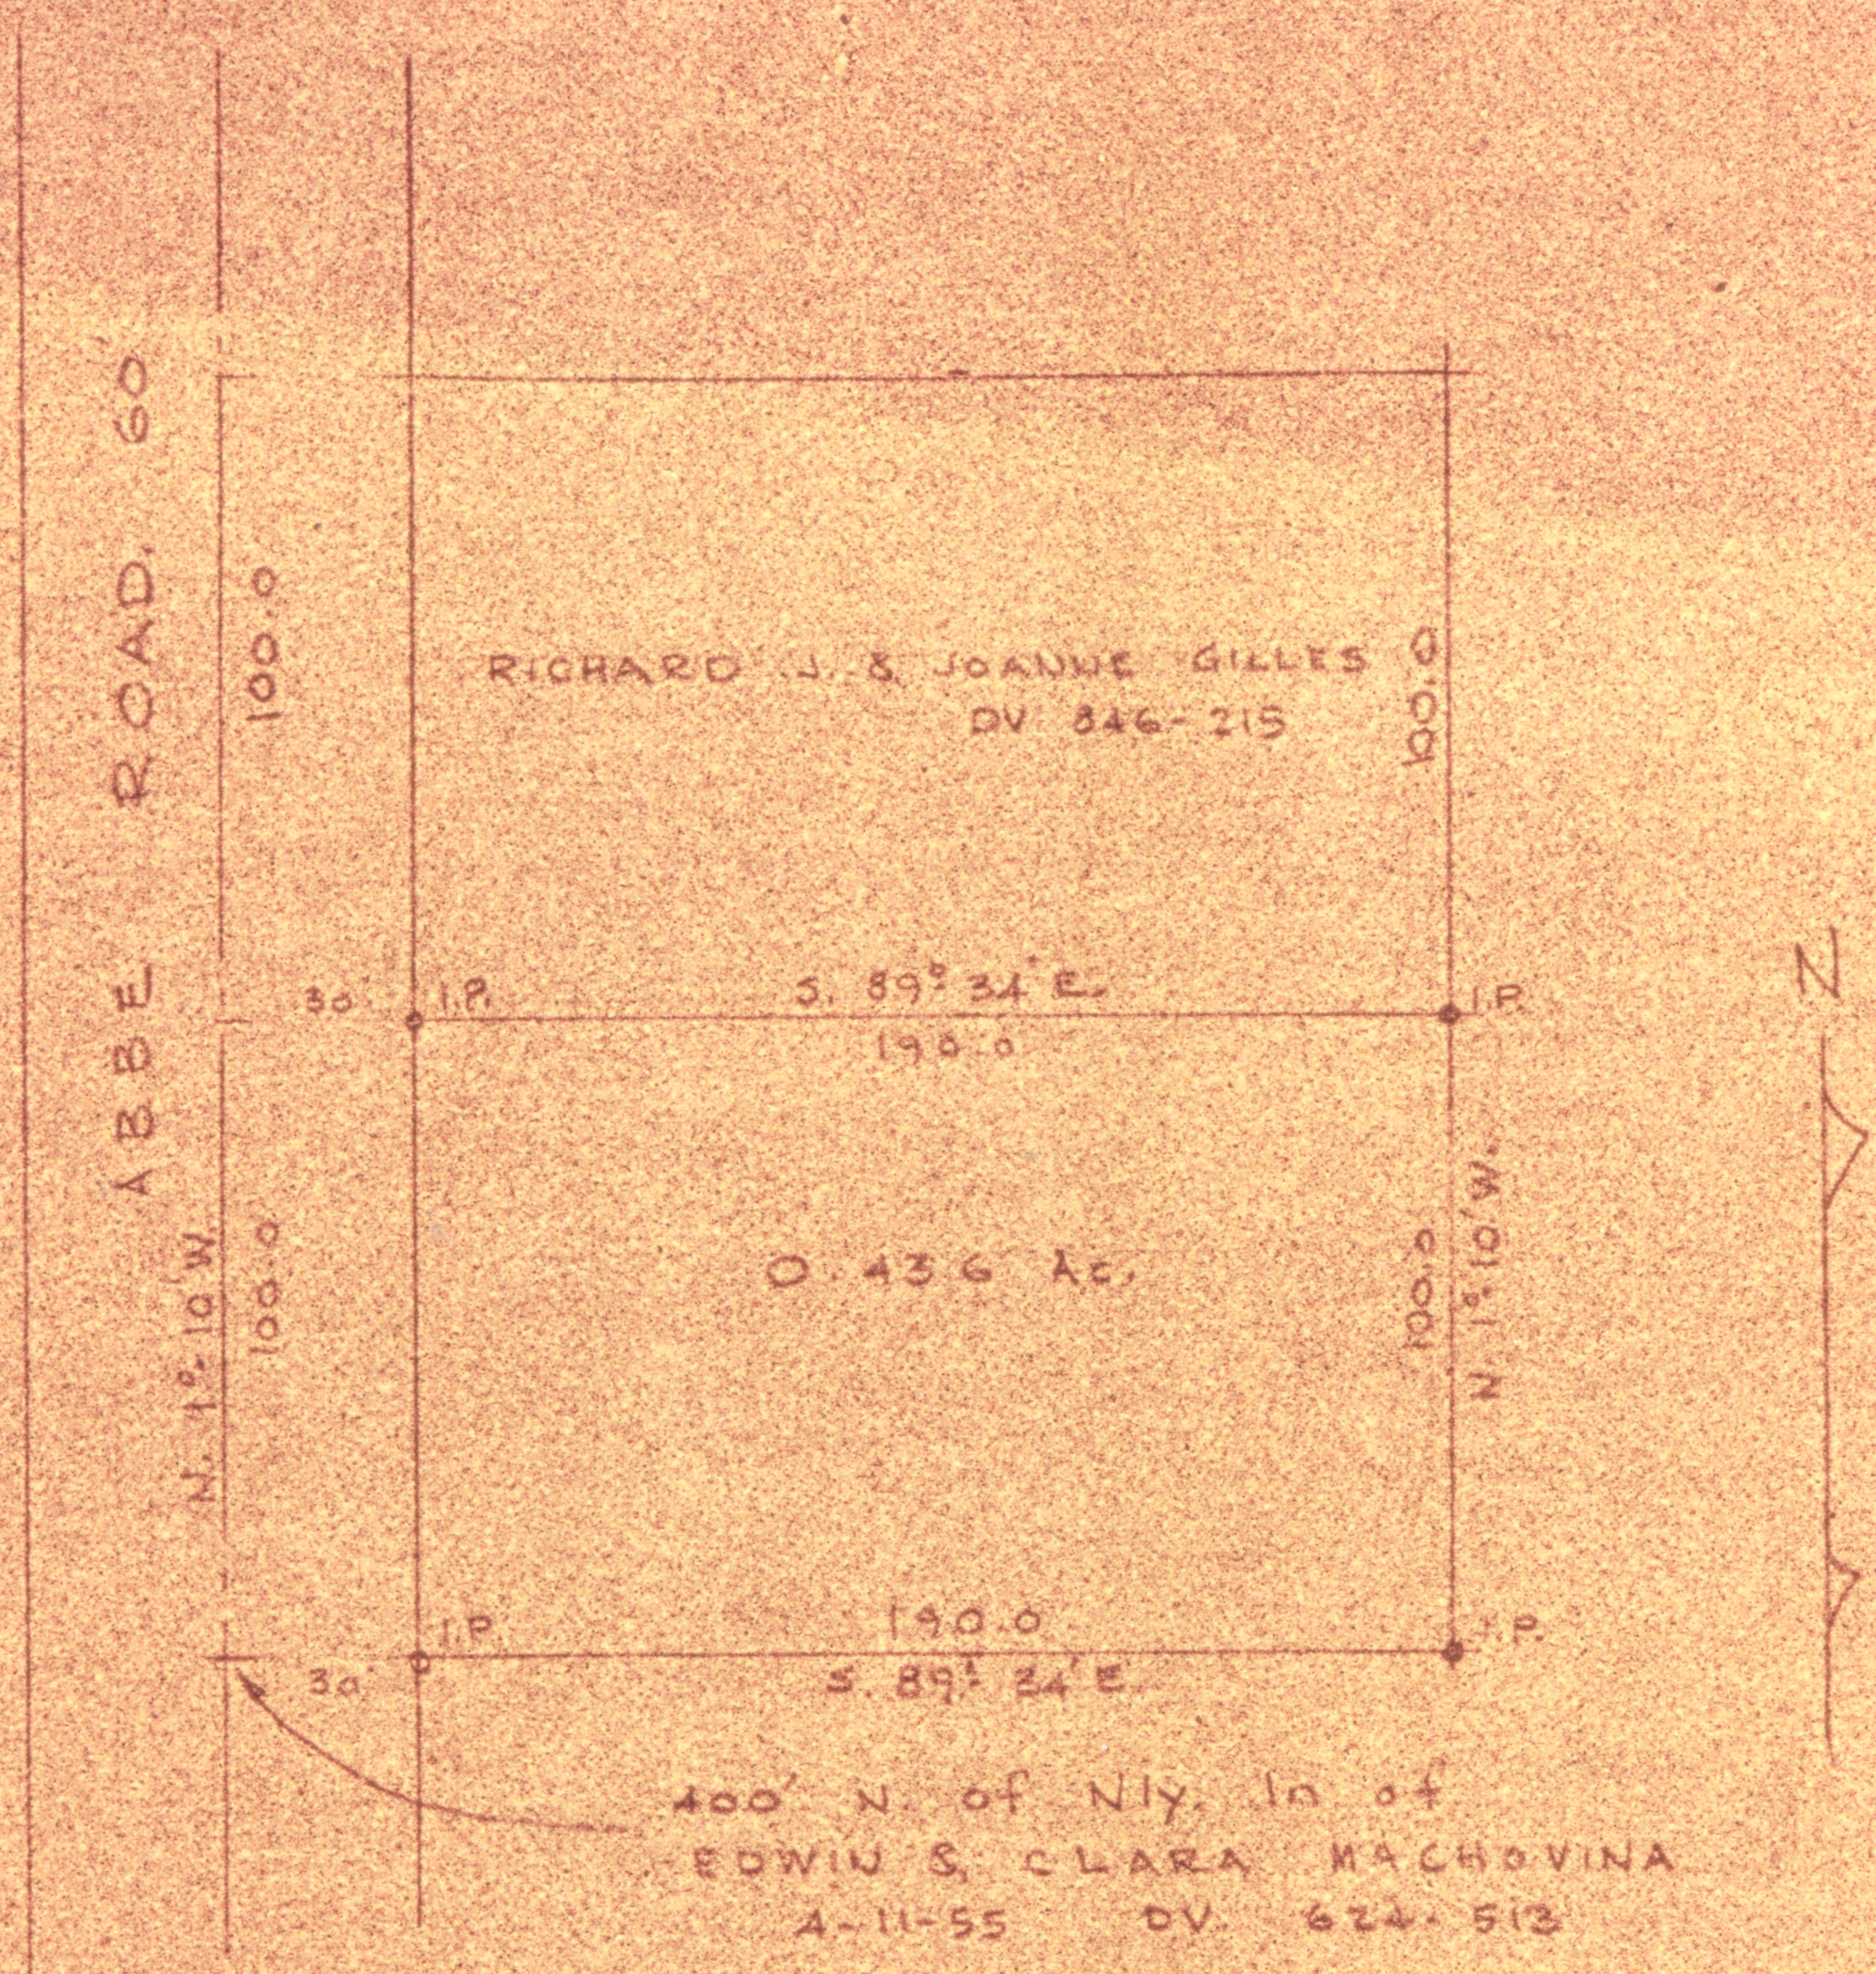

SURVEY FOR CHRIST LINDEN  
 SEC. 5 CARLISLE TWP, LOR. CO., O.  
 SCALE 1" = 50' JUNE 15, 1966  
 LAUNDON, HUFFMAN & SIMON SURVEYORS