


10-00-005-102-
10-00-005-0
SCAN # 46681

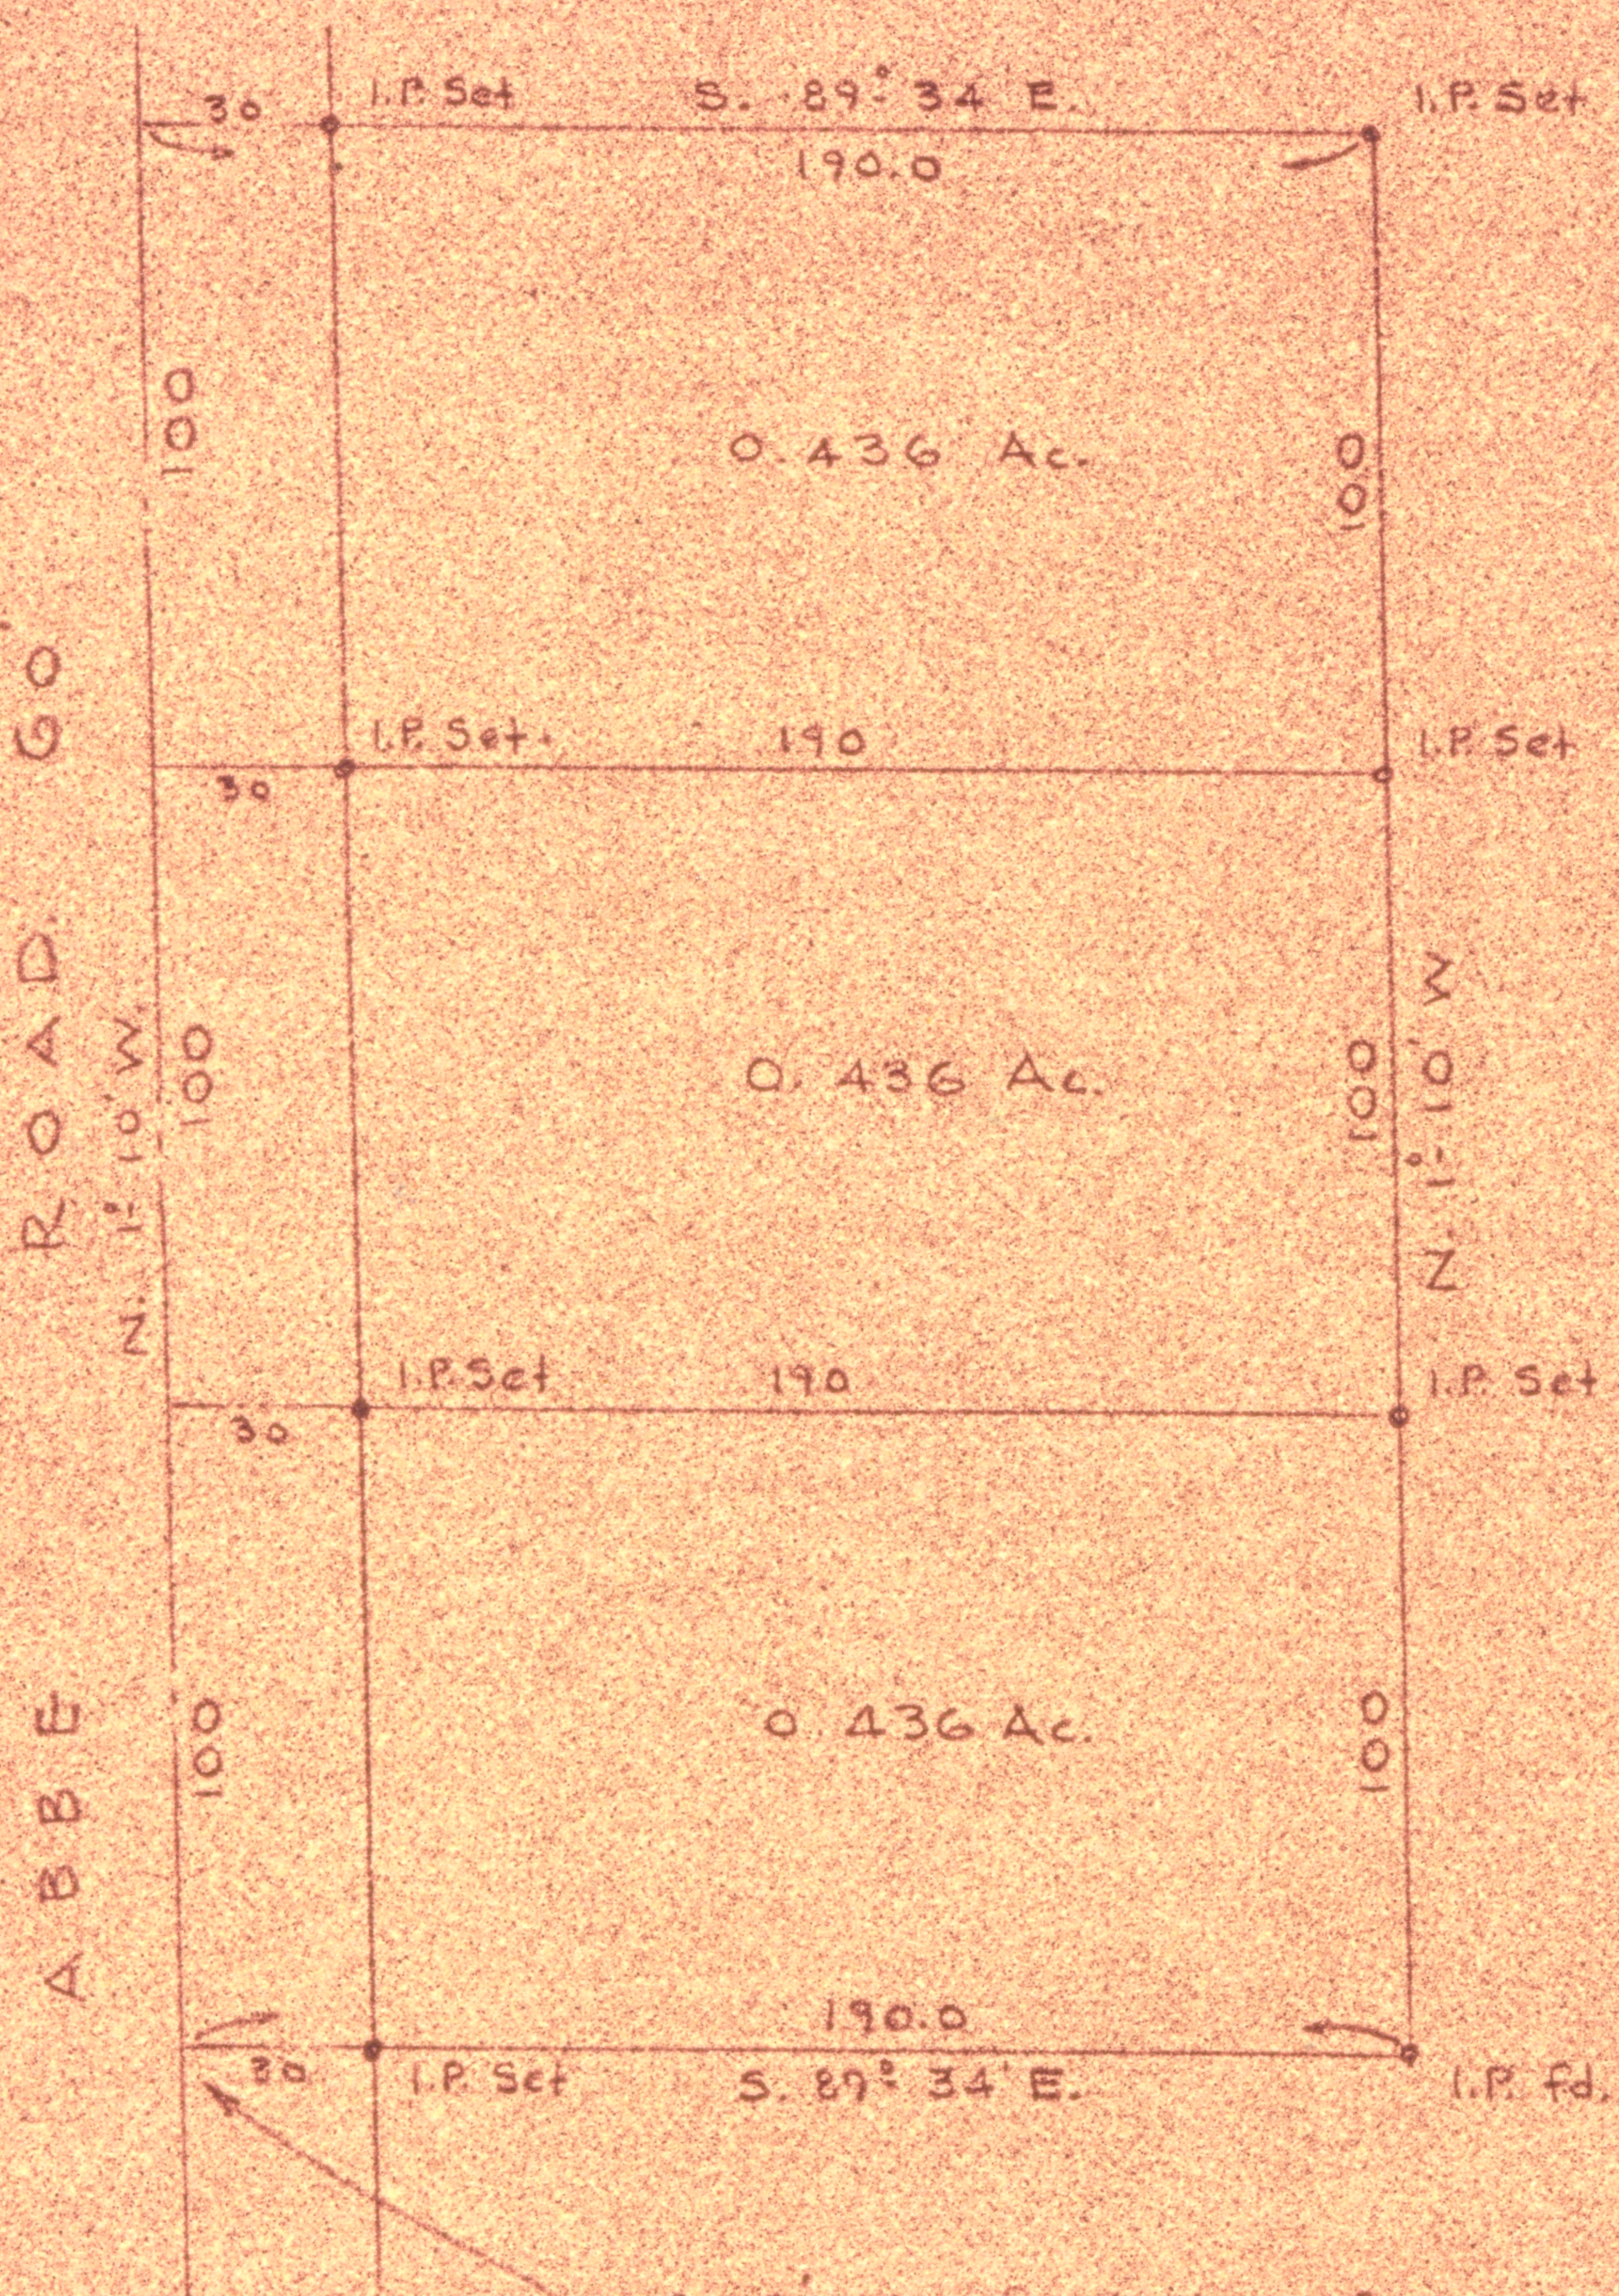

600' N. of Nly. ln of
EDWIN & CLARA MACHOVINA
D.V. 624-513 4-11-55

SURVEY FOR CHRIST LINDEN
SEC. 5 CARLISLE TWP., LORAIN CO., O.
SCALE 1" = 50' JAN 19, 1963
LAUNDON & HUFFMAN SURVEYORS