

SIDELINE DETERMINATION

MRS. HELEN REICHERT

SEC. 6 CARLISLE TWP. LORAIN CO. OHIO

SCALE 1" = 200'


JUNE, 1976

LAUNDON • SIMON • CAHL & ASSOC.

ENGINEERS

SURVEYORS

10-00-006-110-001  
10-00-006-110-031  
10-00-006-110-032  
10-00-006-C  
SCAN #46685

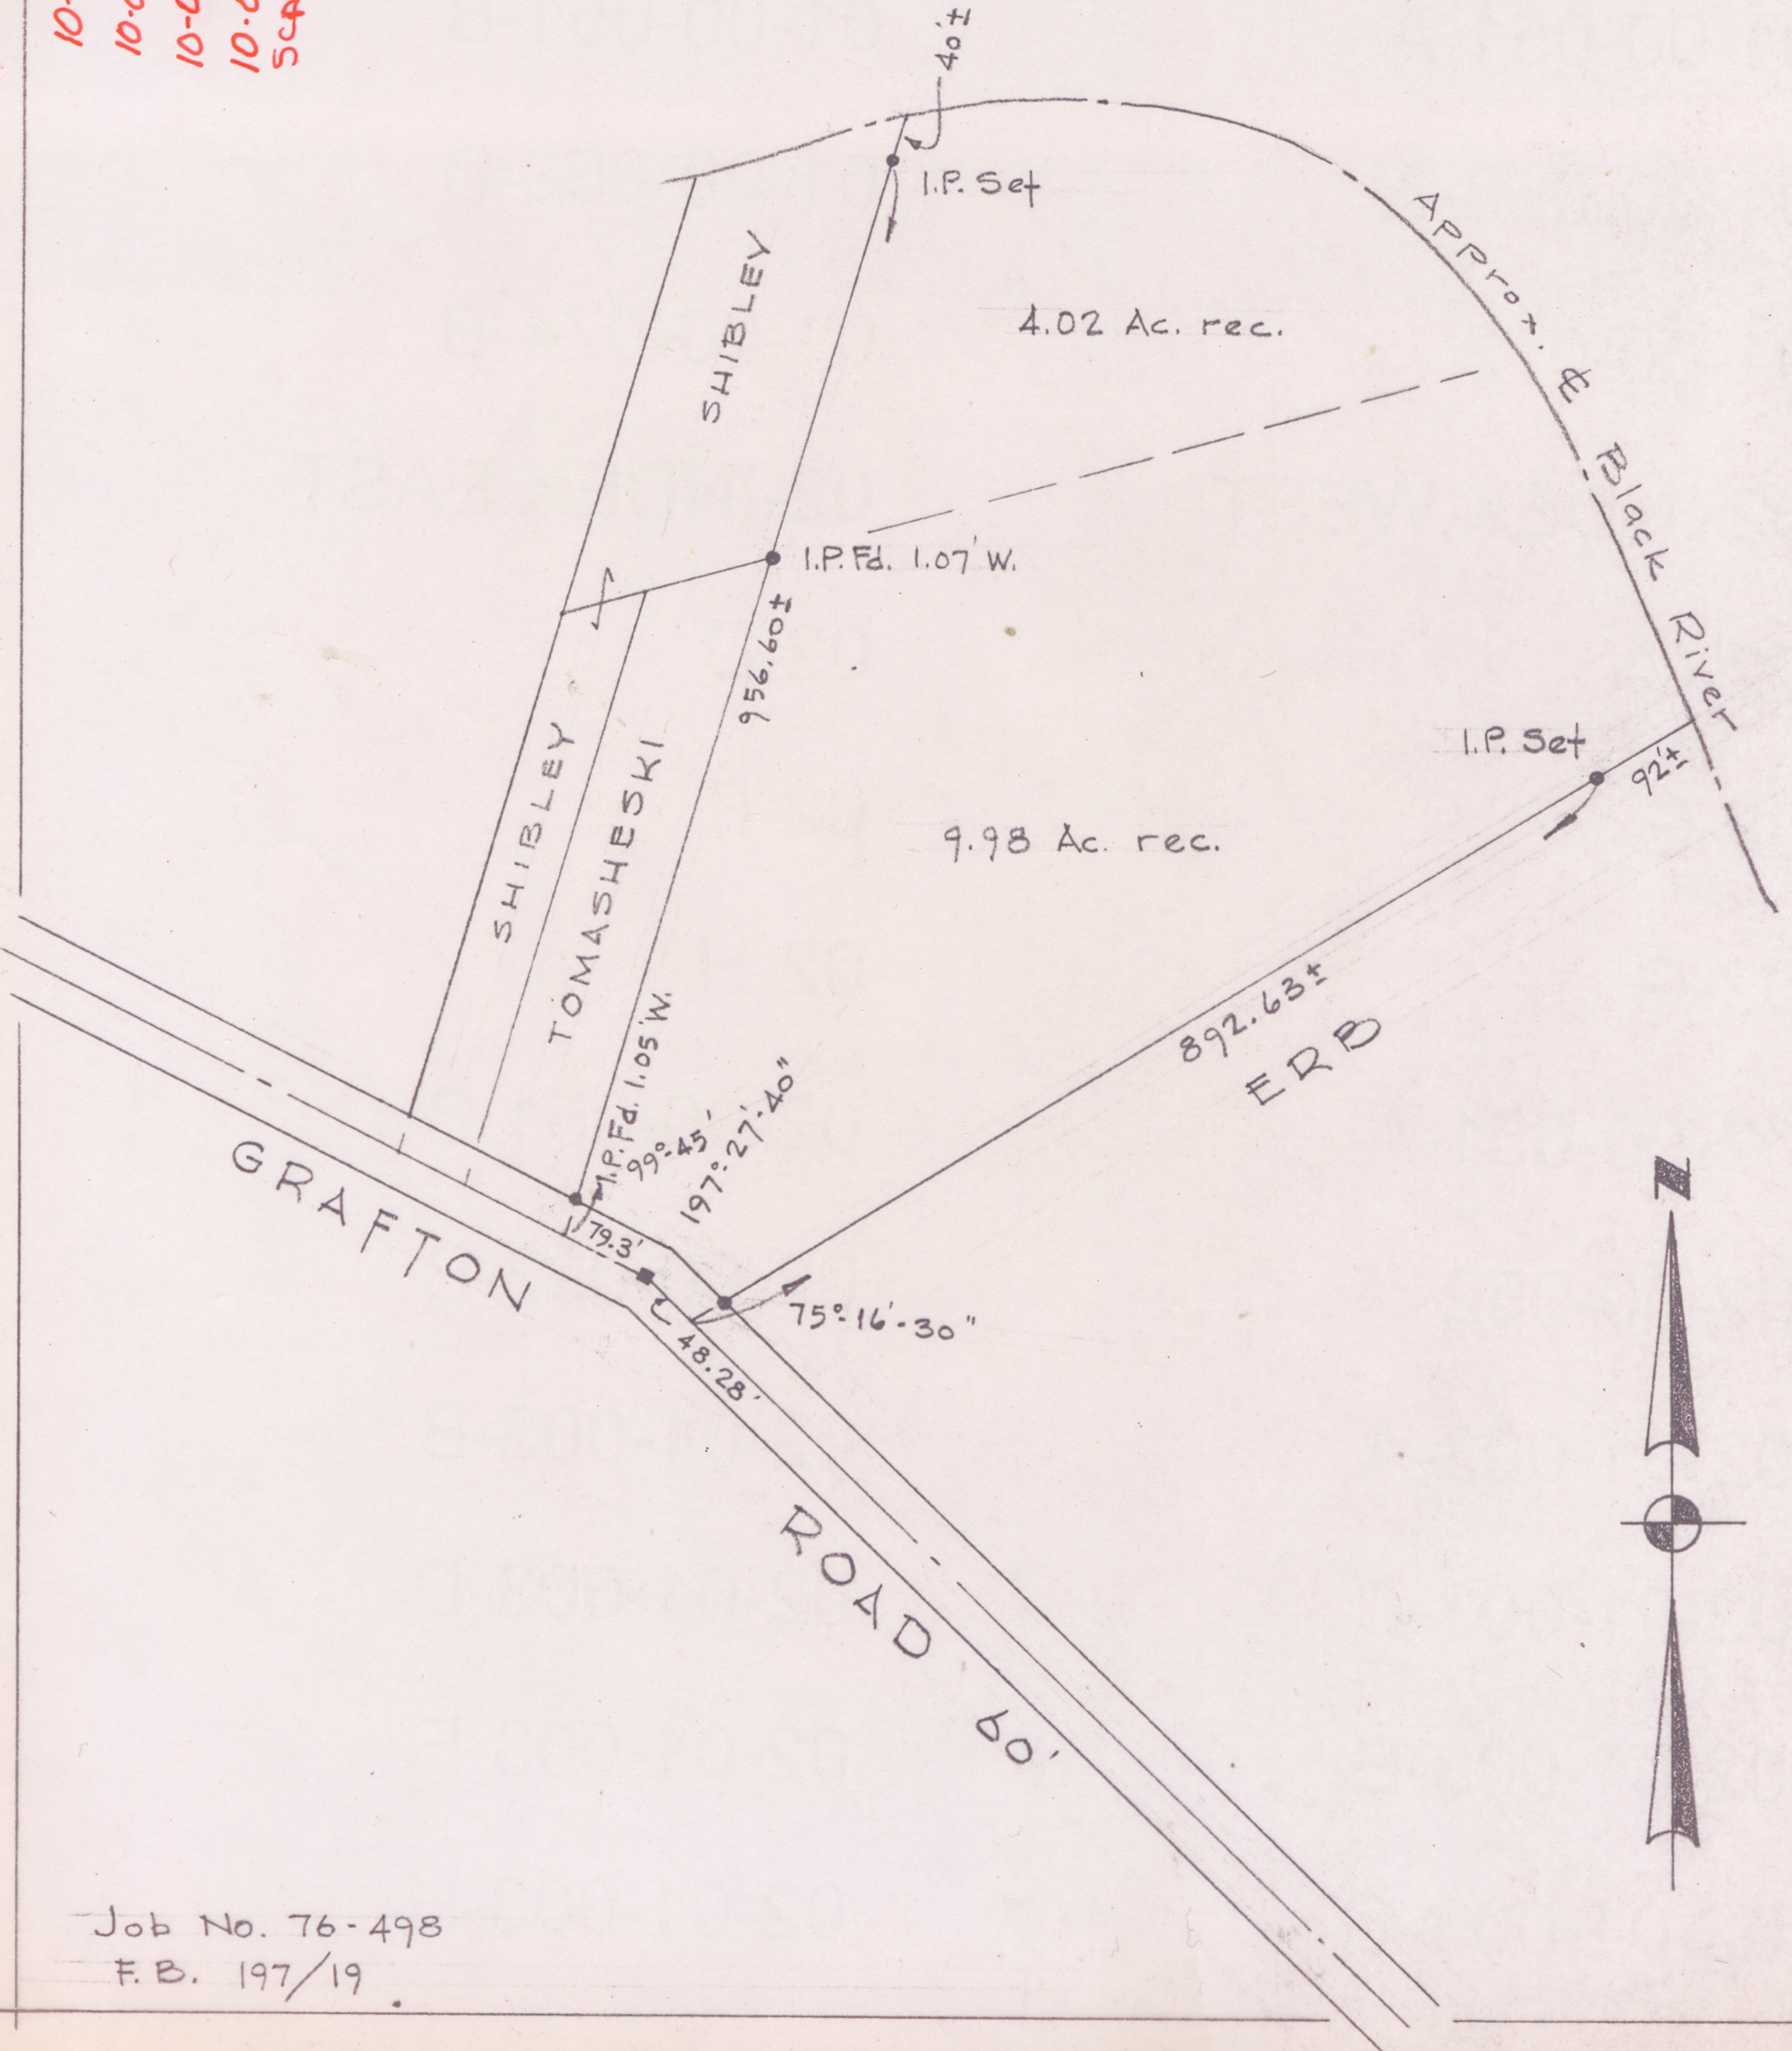

Job No. 76-498

F.B. 197/19