


10-00-016-000-067
 10-00-016-000-069
 10-00-016-F
 Scan #46697

SLIFE RD.

M.B. used

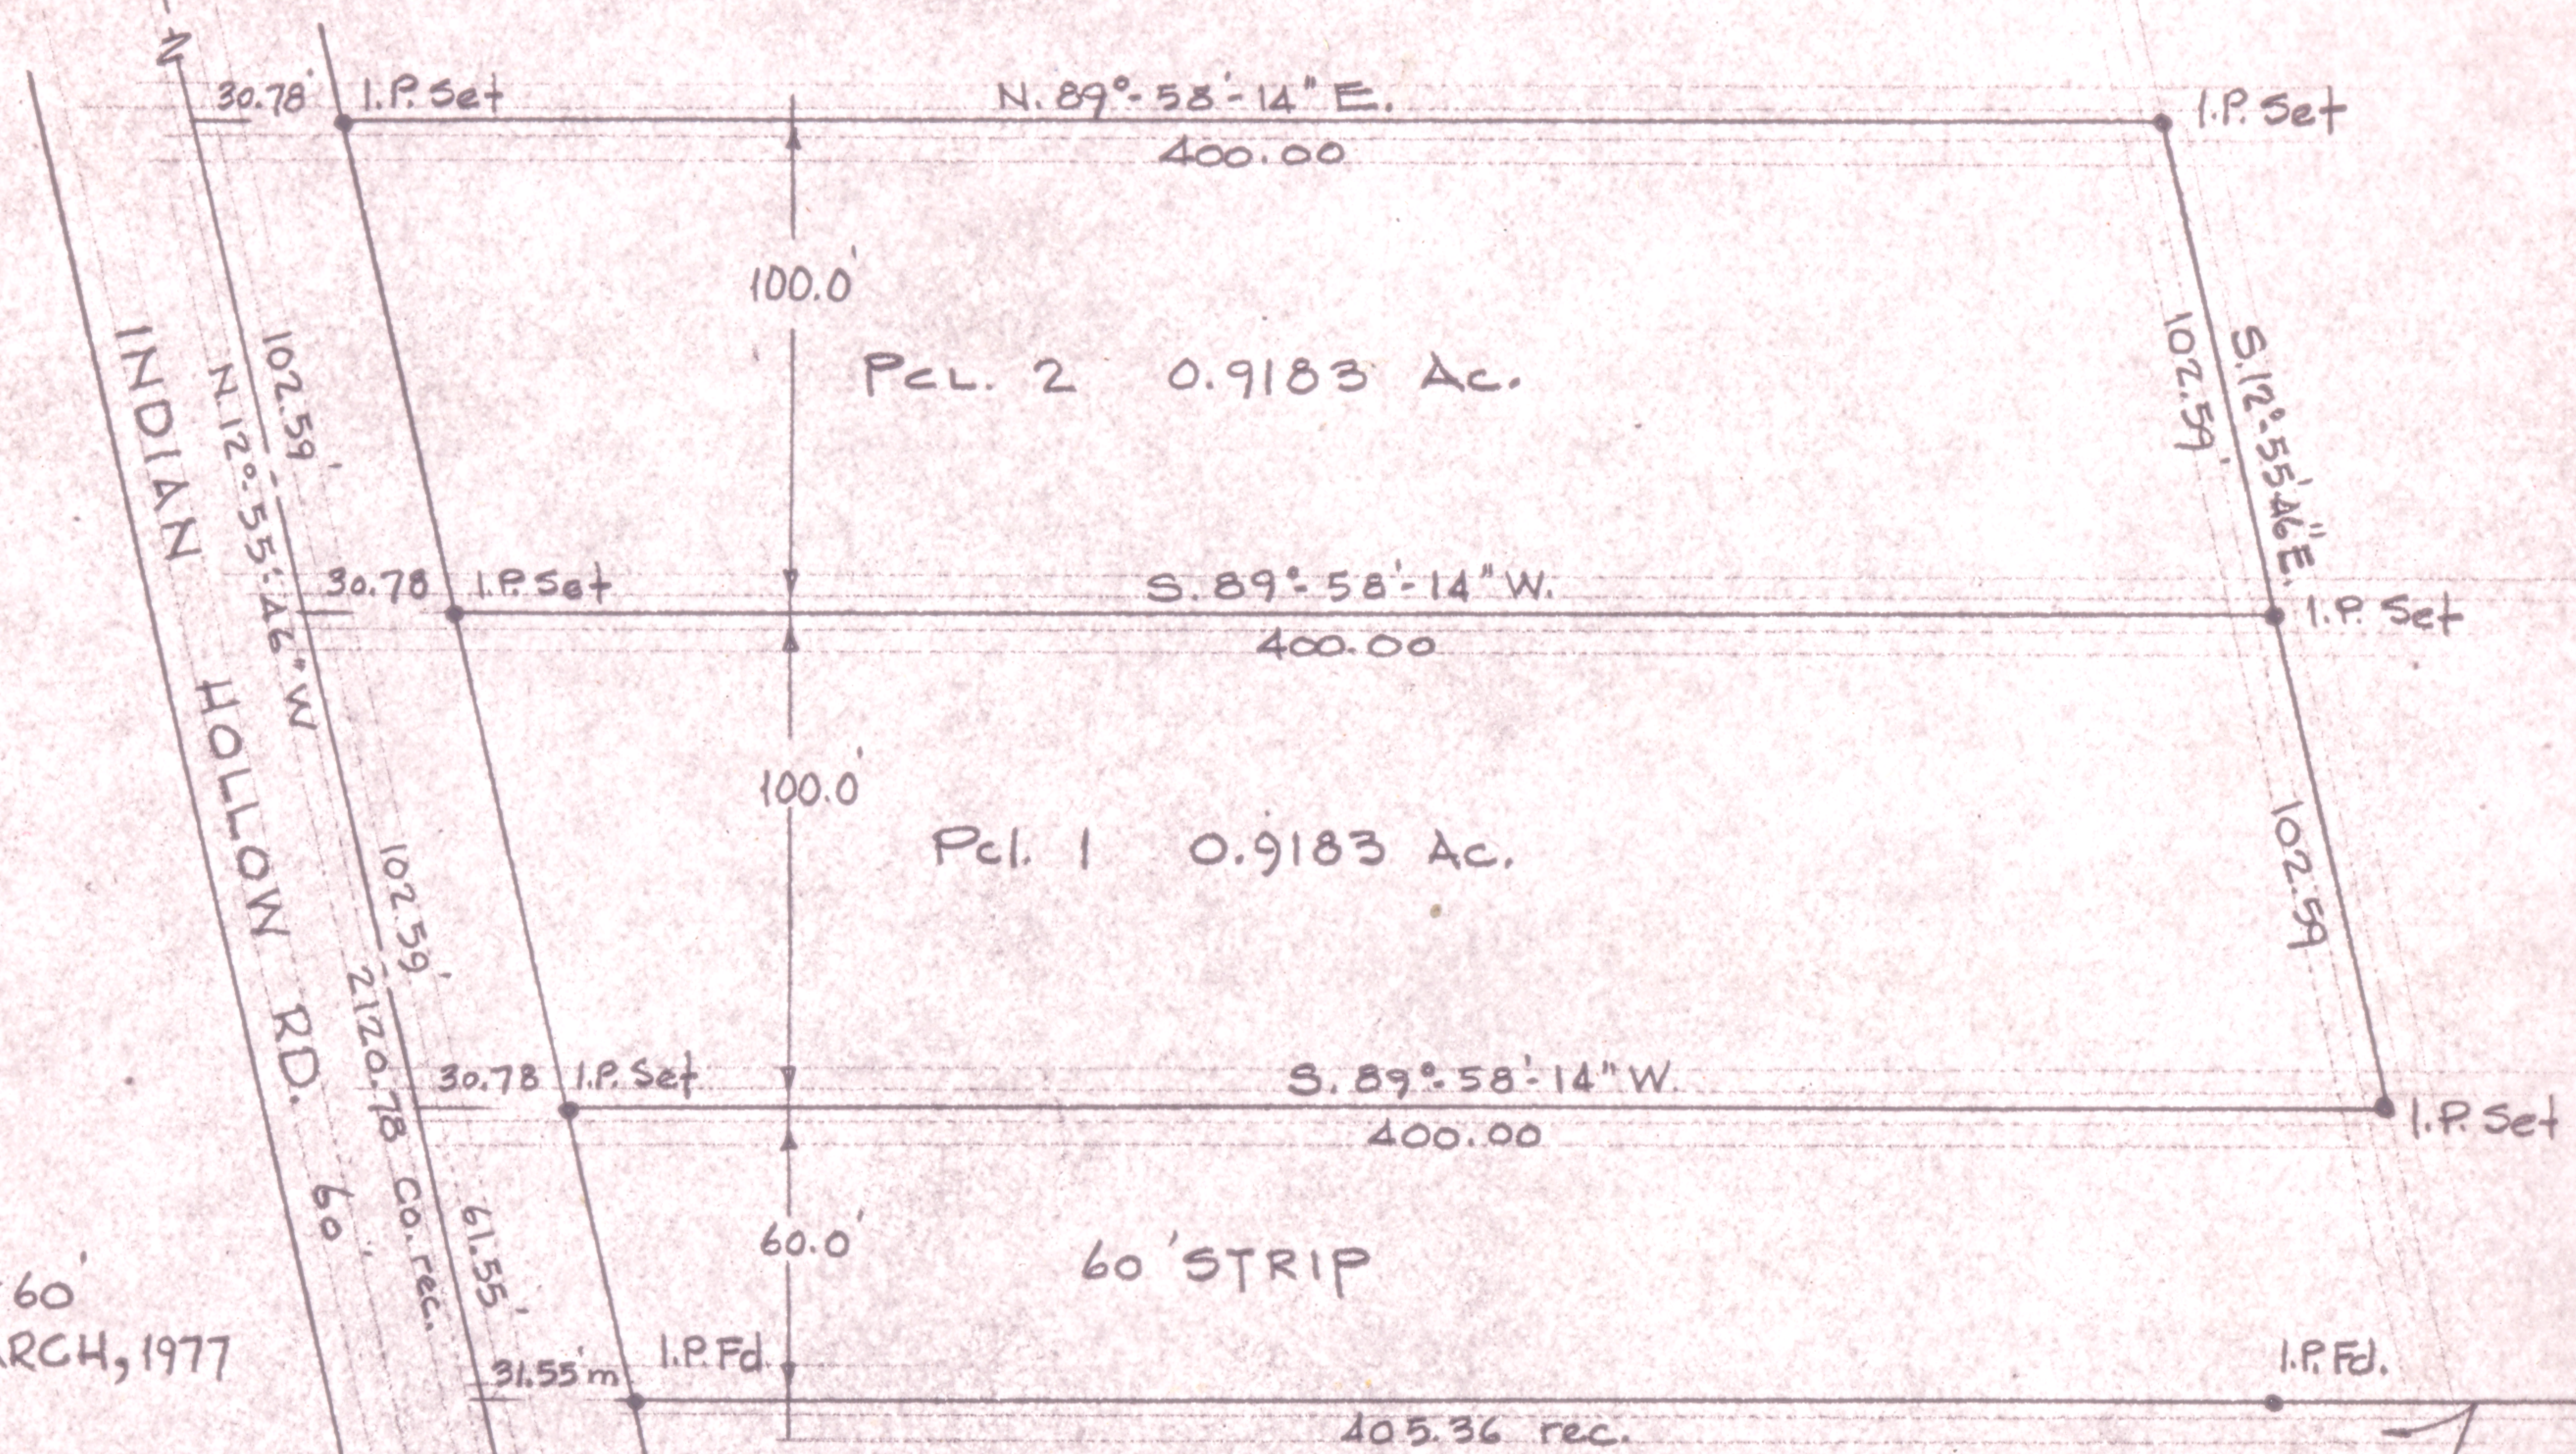

1" = 60'
 MARCH, 1977

GERALD G. & JANE A. HAUGHT
 8/24/60 D.V. 779 PG. 566

SURVEY FOR
CHARLES J. BORLING
 SEC. 16 CARLISLE TWP.
 LORAIN COUNTY OHIO
 LAUNDON • SIMON • CAHL & ASSOC.
 ENGINEERS & SURVEYORS

Job No. 77-580
 F.B. 156 Pg. 51

M.B. used