


10-00-016-000
10-00-016-A
SCAN # 46698

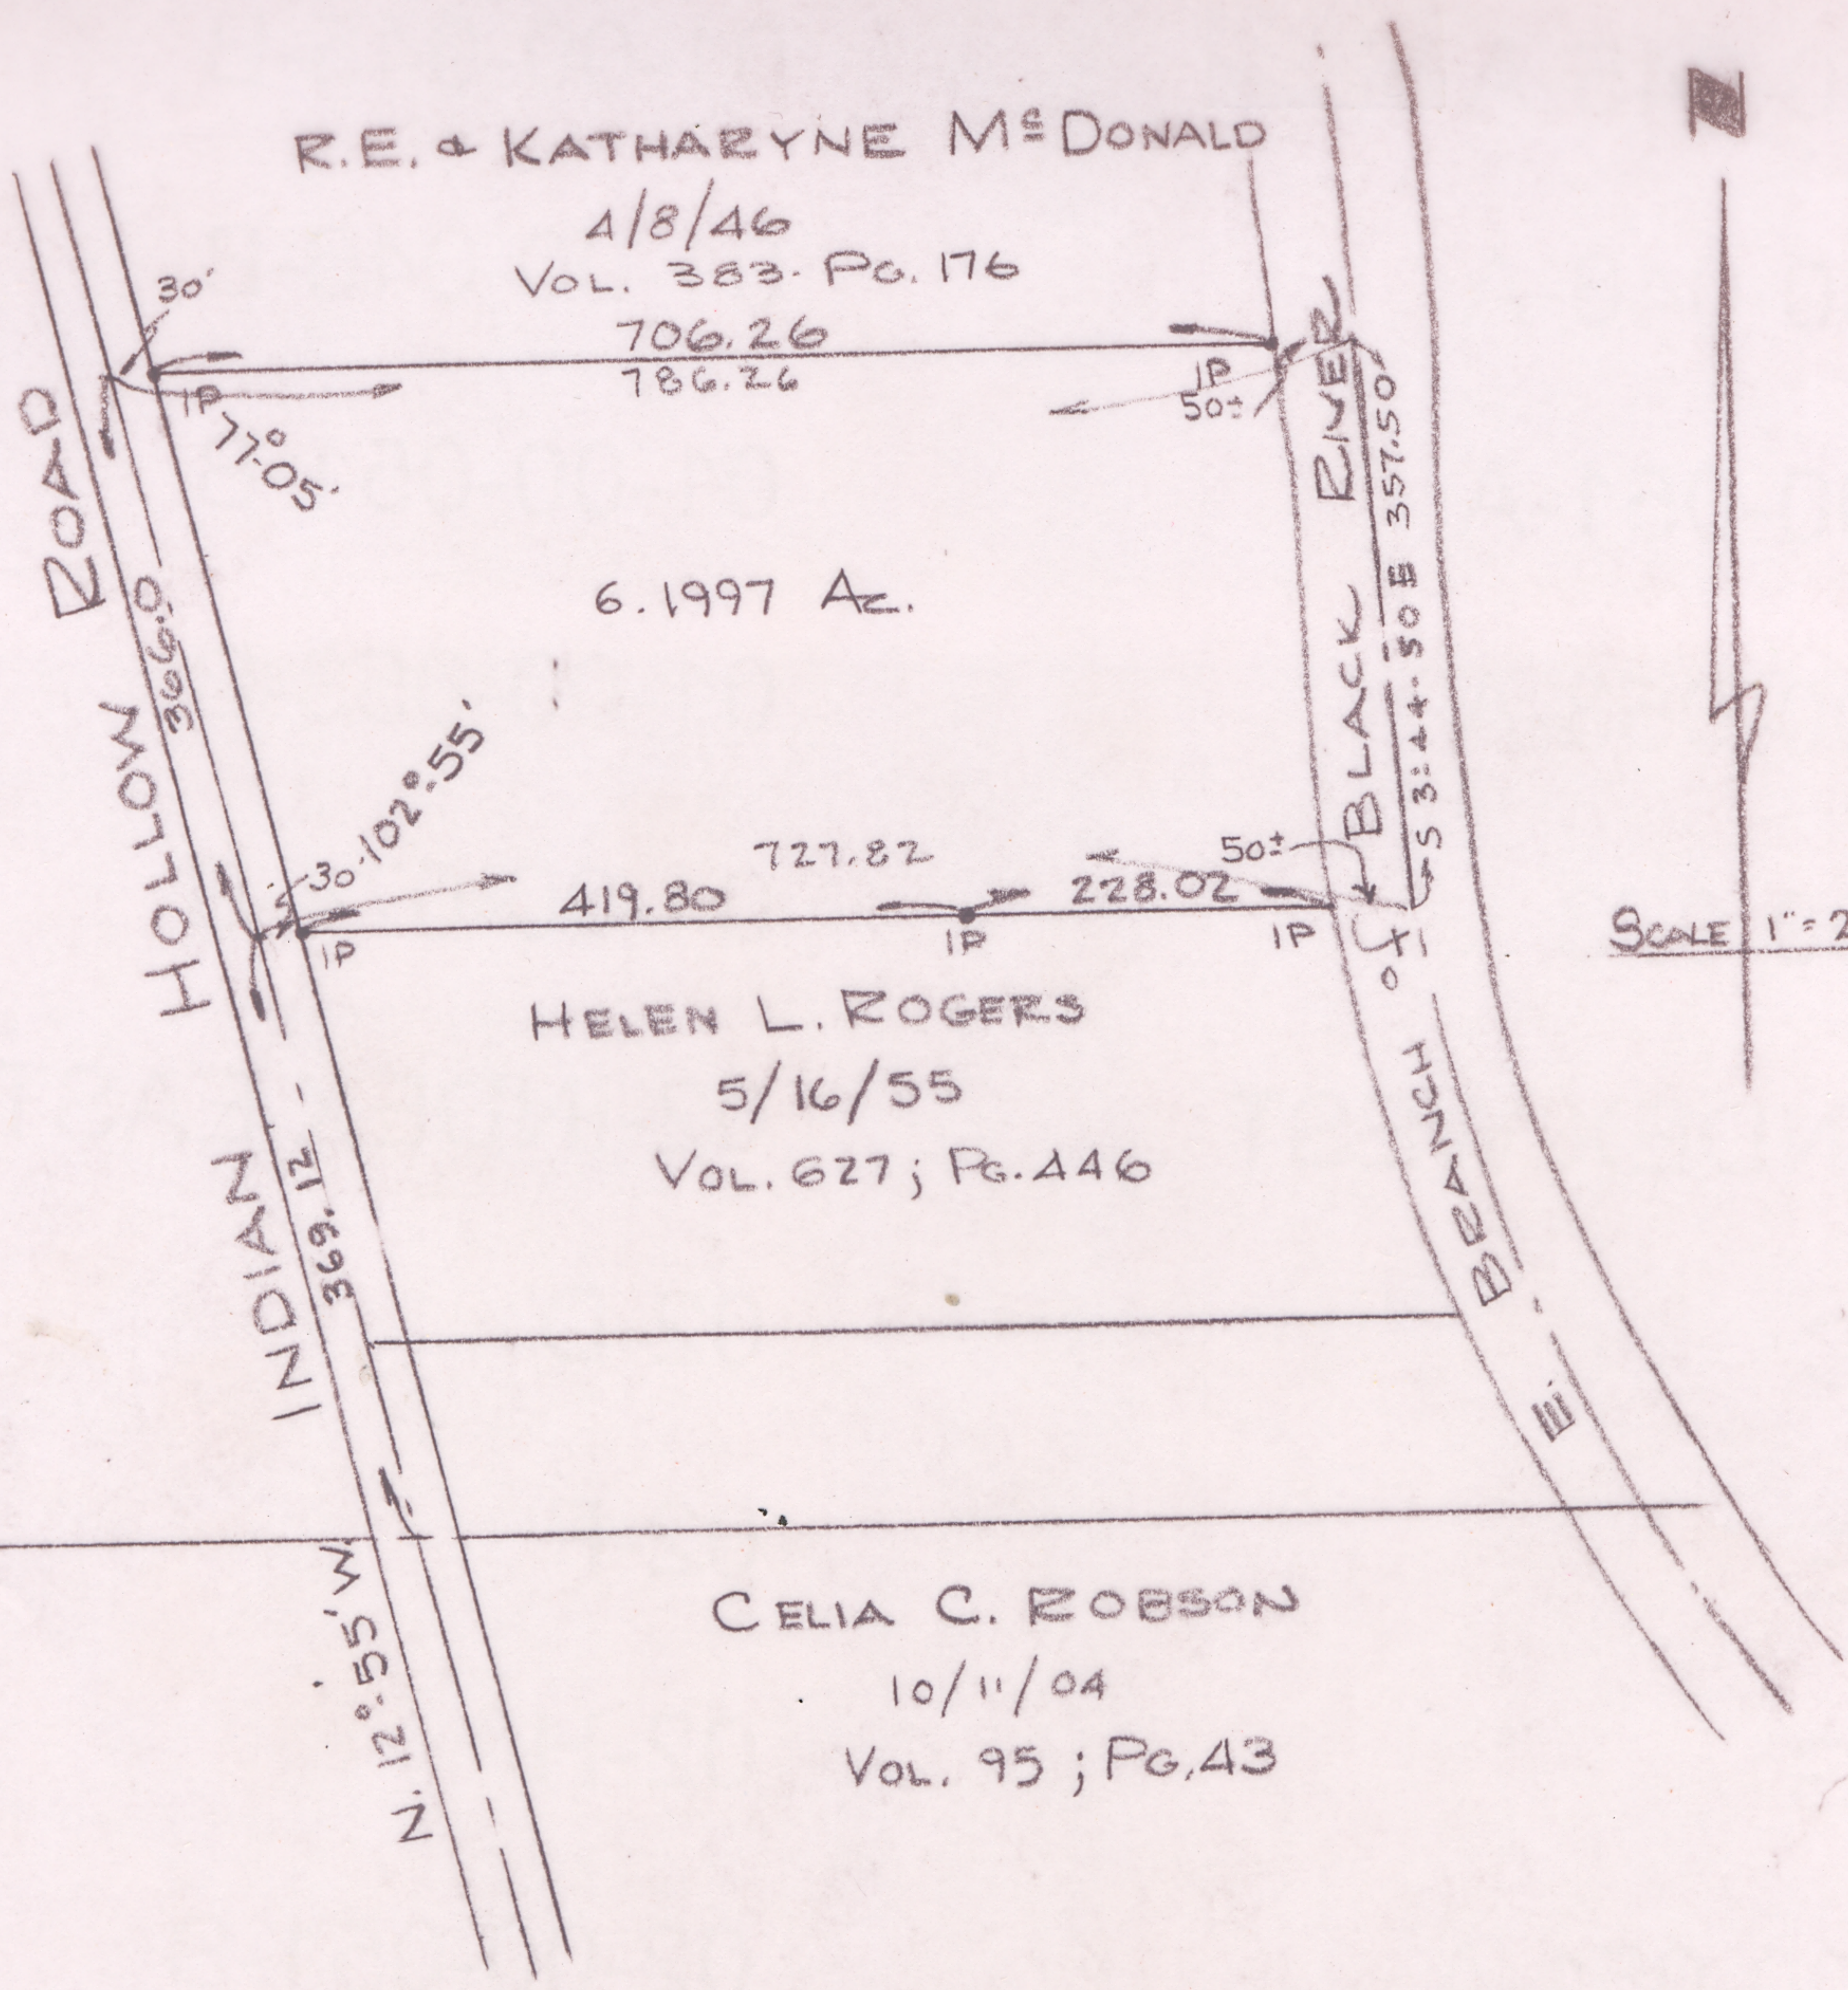

R.E. & KATHRYNE MCDONALD

4/8/46
VOL. 383-PG. 176

706.26
786.26

6.1997 Ac.

HELEN L. ROGERS

5/16/55

VOL. 627; PG. 446

CELIA C. ROBSON

10/11/04

VOL. 95; PG. 43

SCALE 1"=200'

SURVEY FOR
GEO. F. & GLADYS E. DECKERHOFF
PT. of O.L. 16 of CARLISLE TWP.
LORAIN CO. ; OHIO

BY
T. W. LAUNDON-REG. SURVEYOR