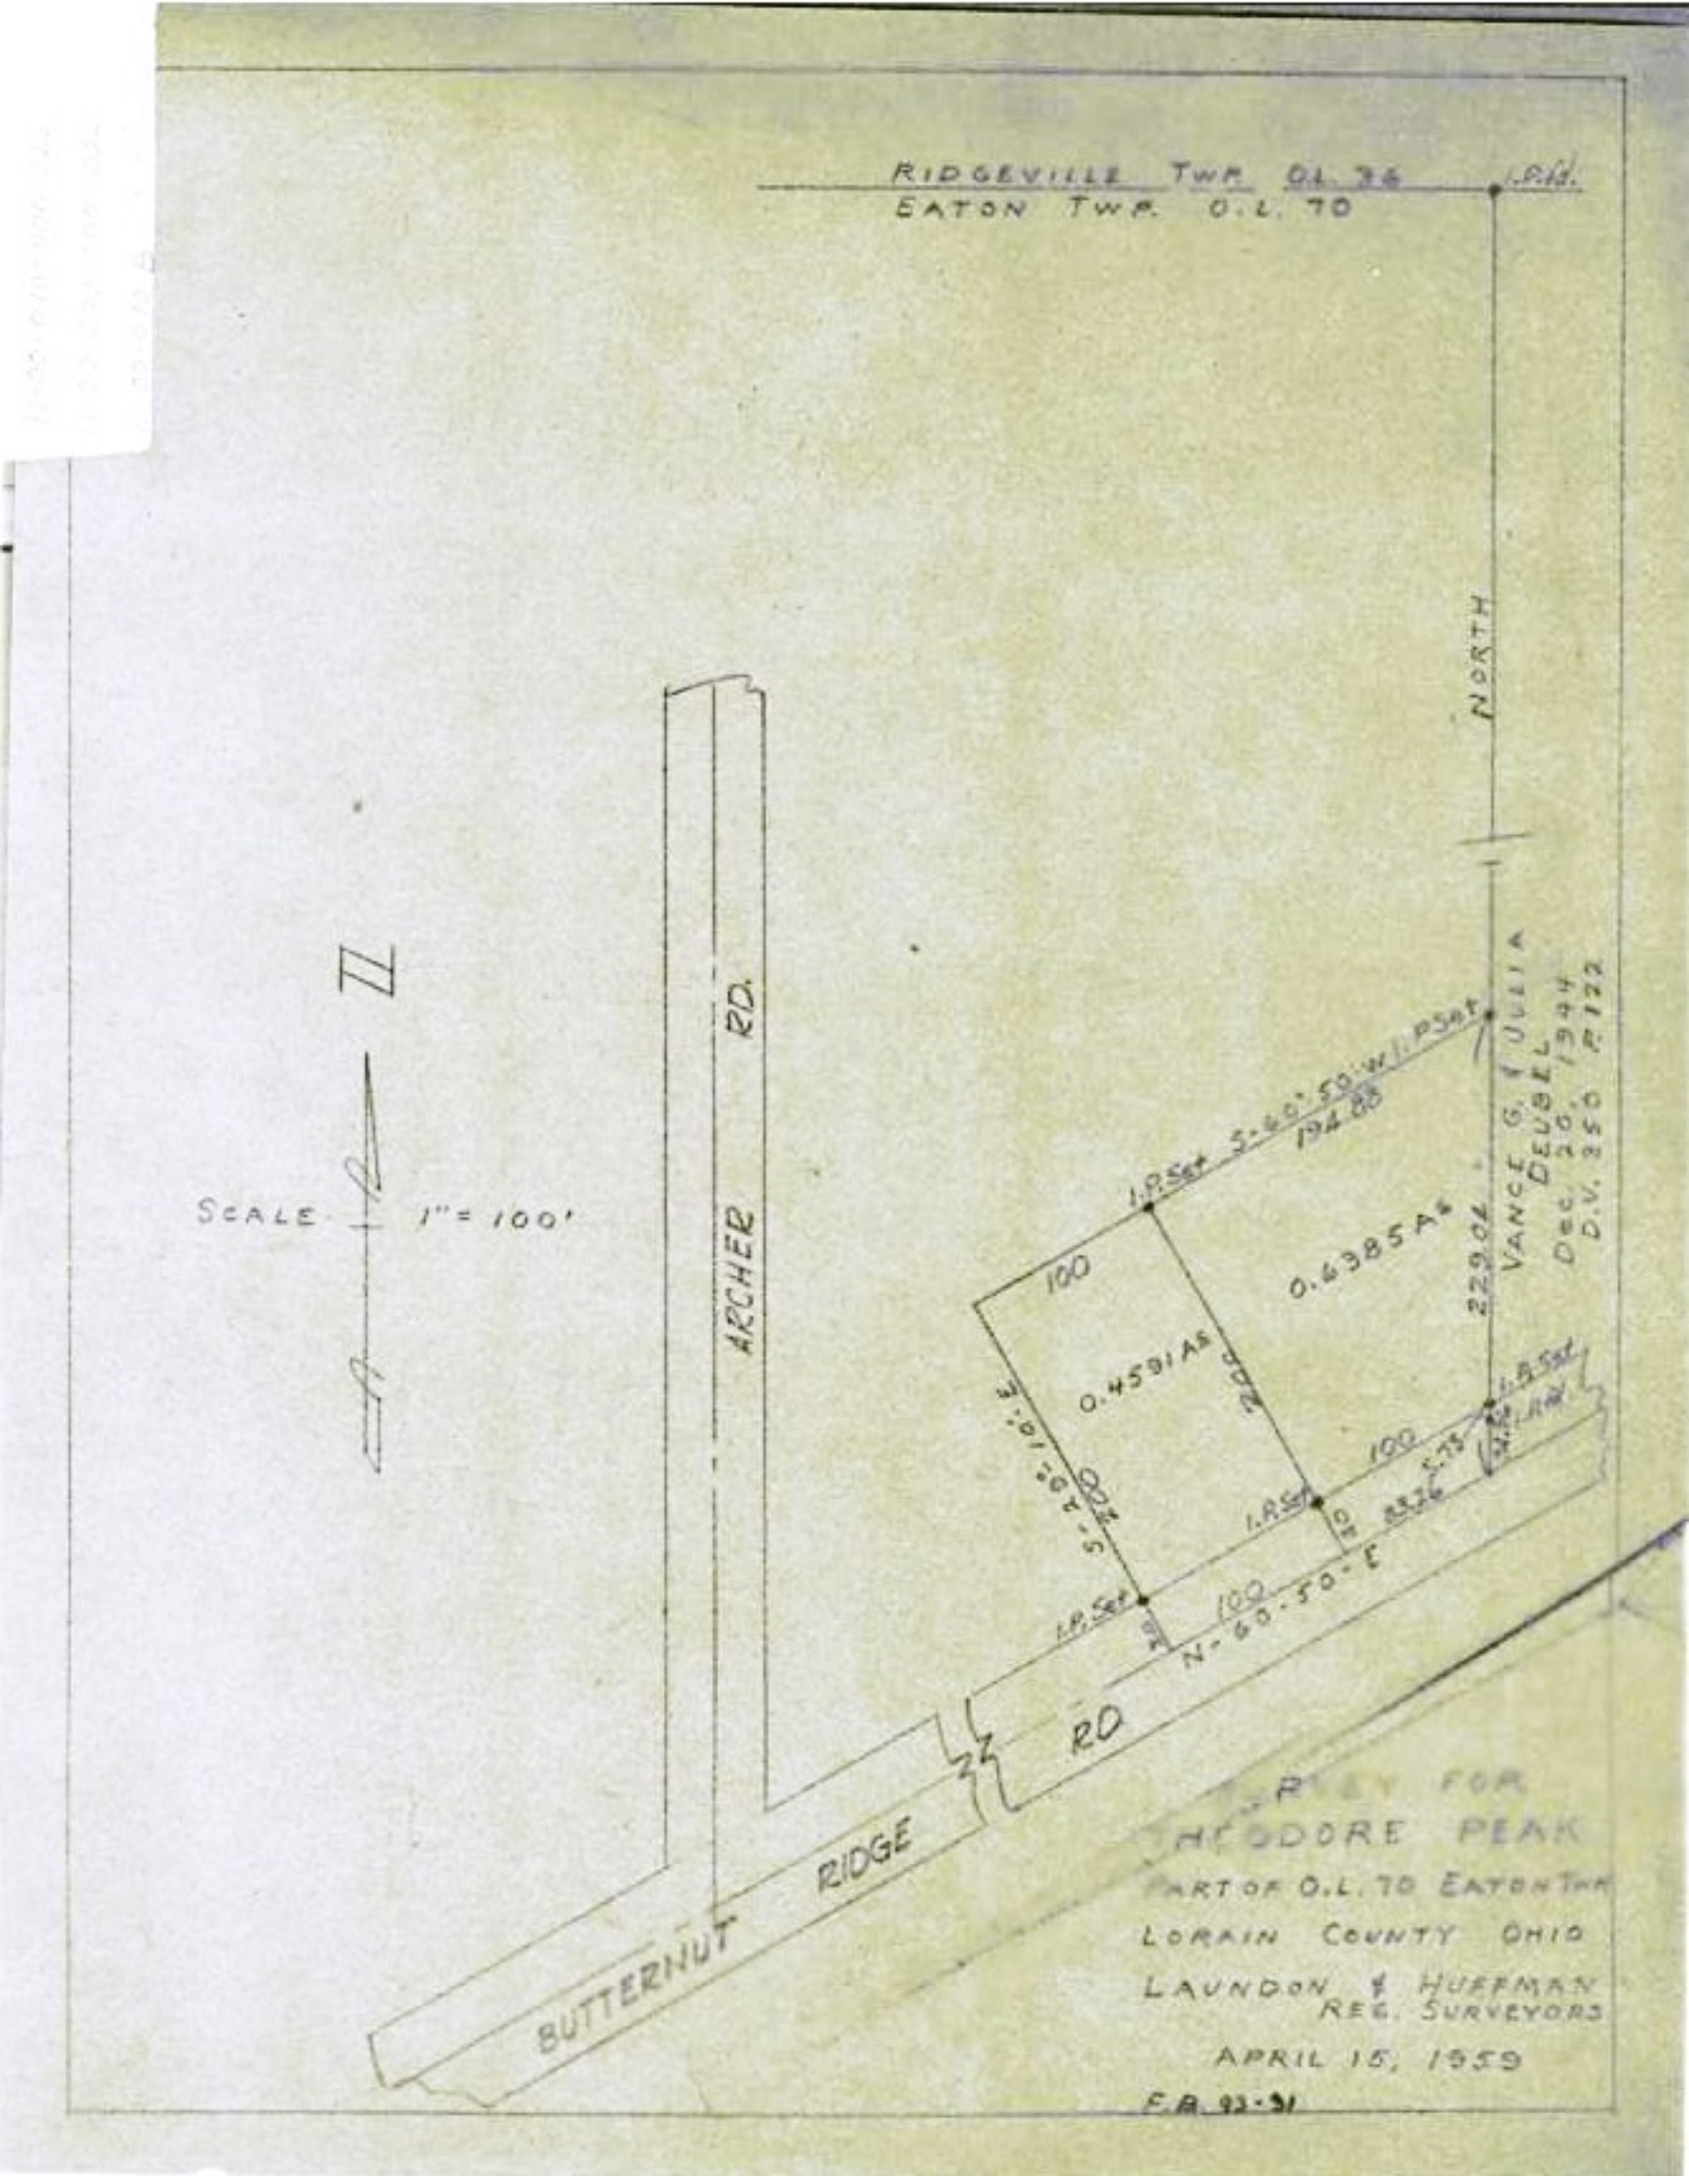
RIDGEVILLE TWP. O.L. 36
EATON TWP. O.L. 70
I.P.Fd.
NORTH
ARCHER RD.
SCALE 1" = 100'
VANCE G. & JULIA DEUBEL
Dec. 20, 1944
D.V. 350 P. 122
I.P.Set S. 60° 50' W.
194.88
I.P.Set
100
0.6385 AC
0.4591 AC
229.04
200
S. 29° 10' E.
200
I.P.Set
100
I.P.Set
I.P.Set
100
N. 60° 50' E.
RD
BUTTERNUT RIDGE
SURVEY FOR
THEODORE PEAK
PART OF O.L. 70 EATON TWP.
LORAIN COUNTY OHIO
LAUNDON & HUFFMAN
REG. SURVEYORS
APRIL 15, 1959
E.B. 93-31