


11-00-070-000-035
 11-00-070-000-057
 11-00-070-000-058
 11-00-070-A

SCAN # 46726

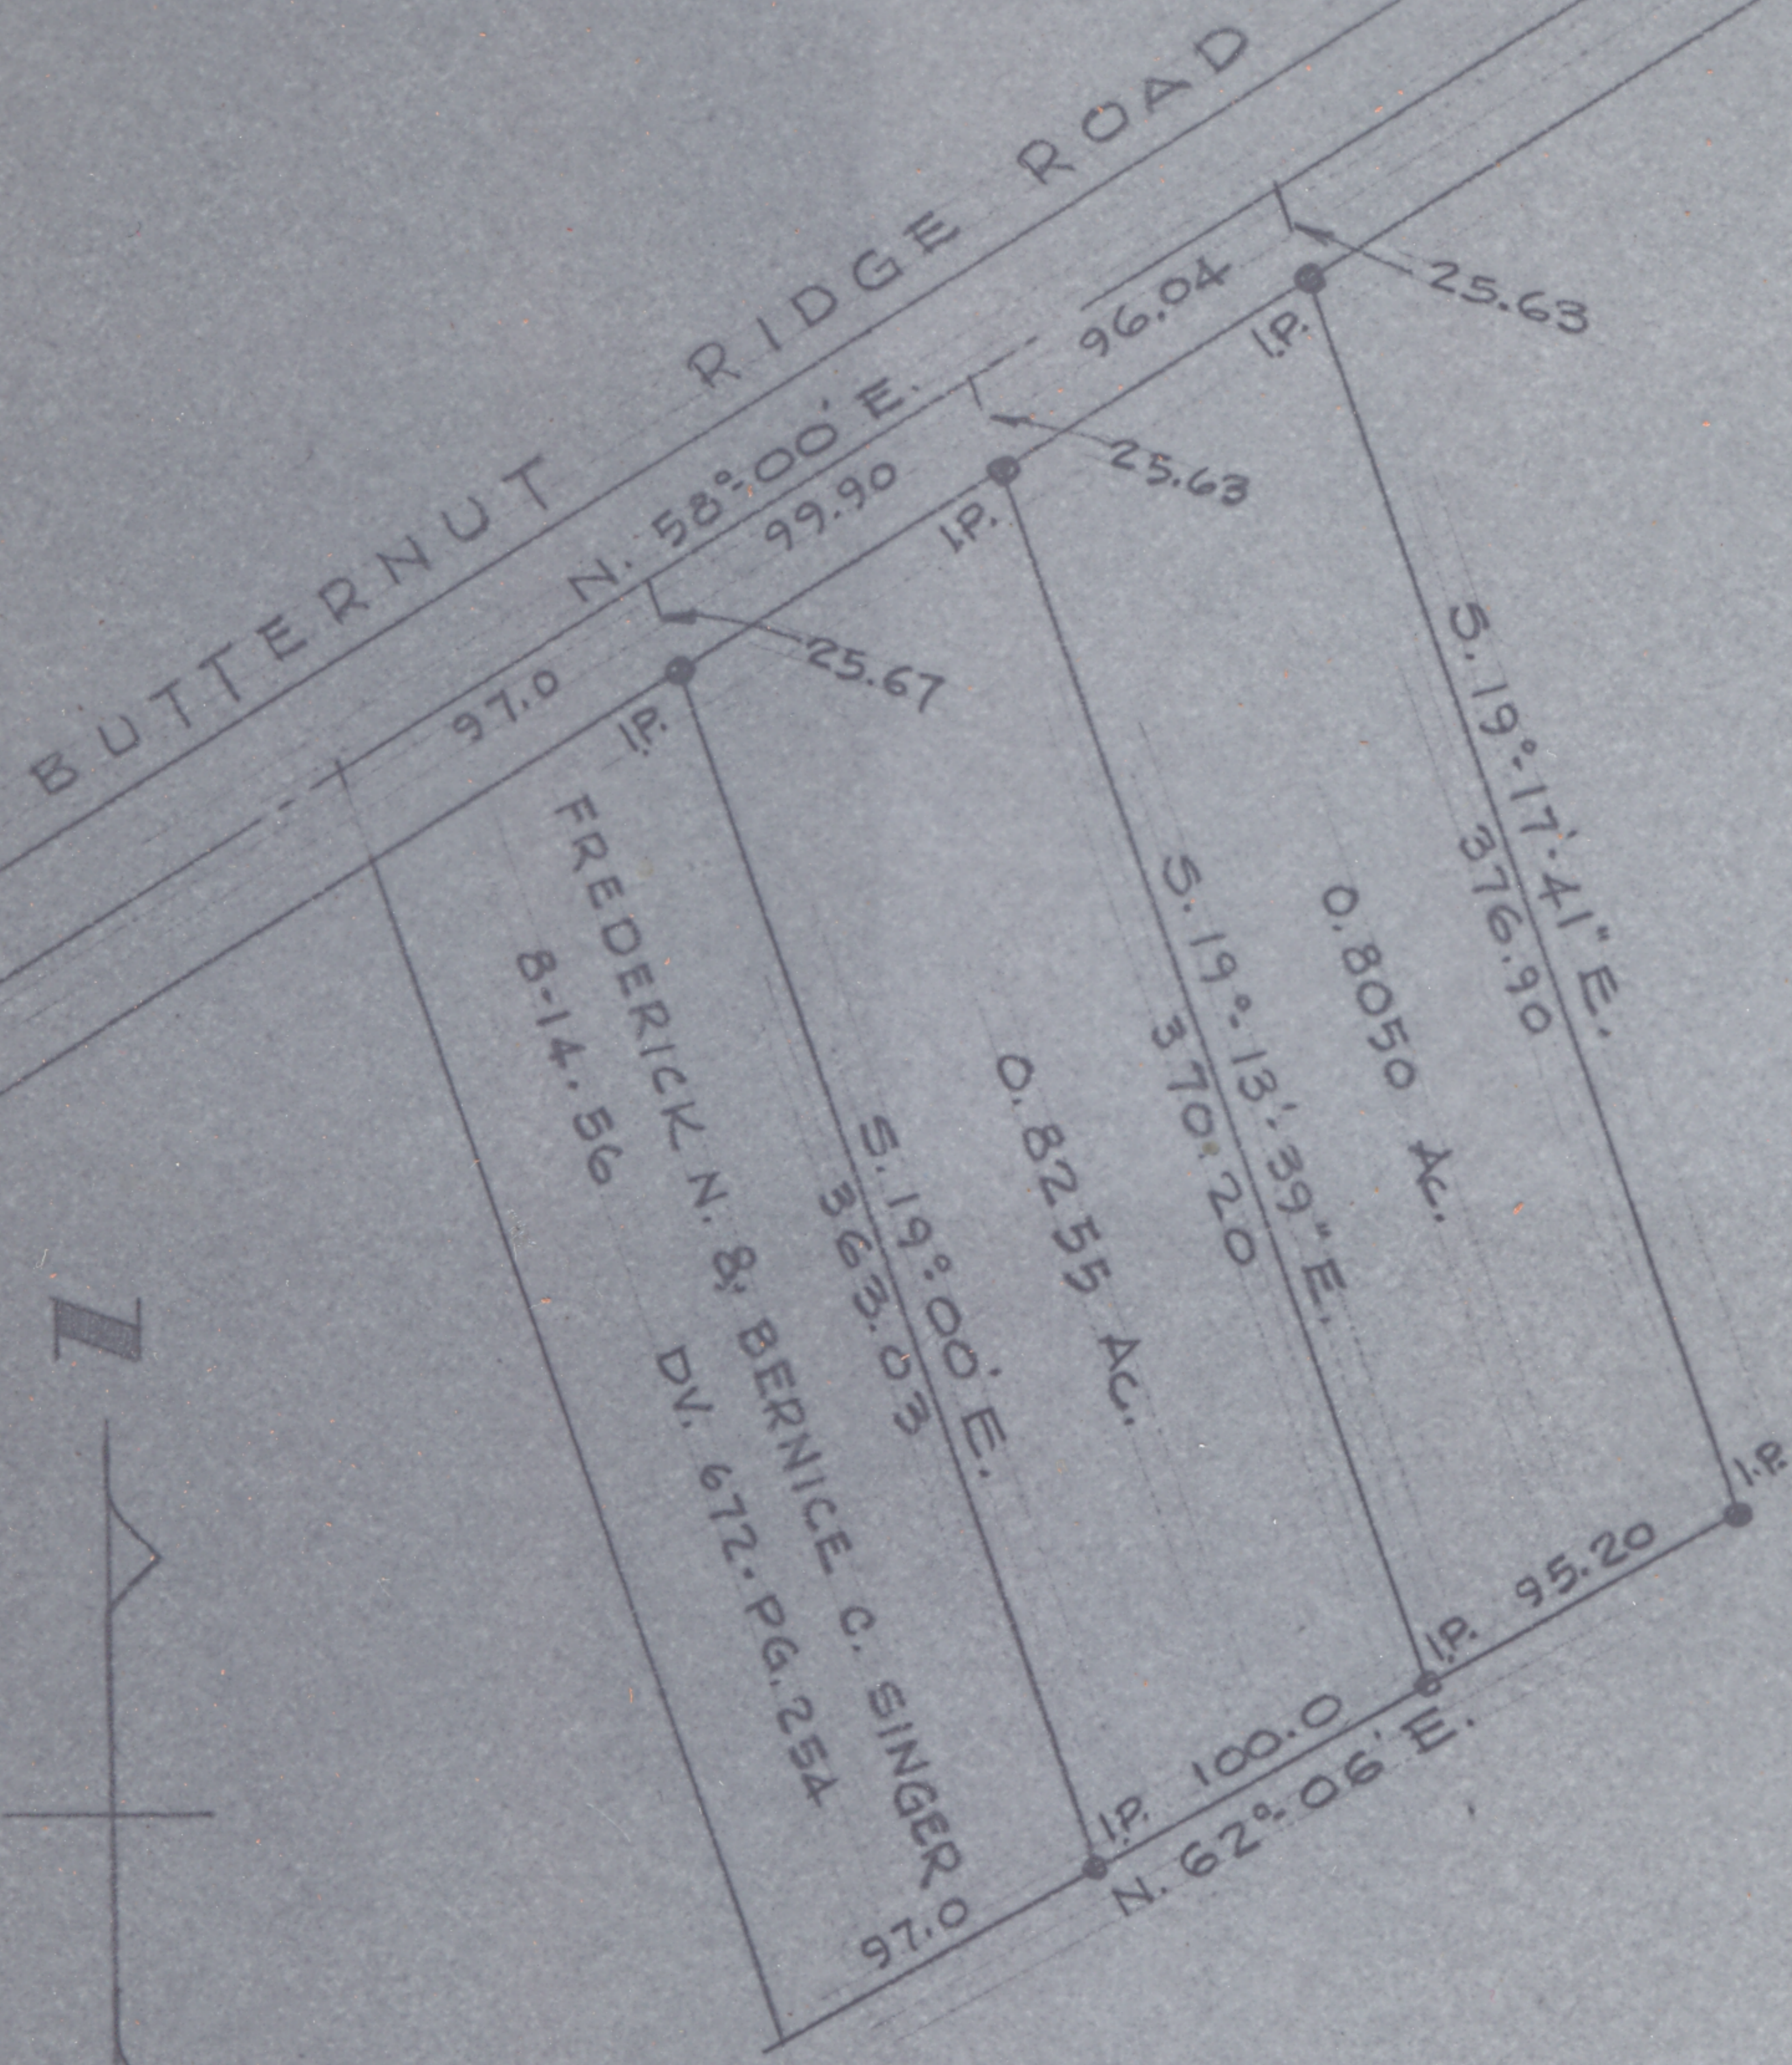

LLOYD G. & THEODORE PEAK
 11-4-44
 DV. 338 - PG. 140

SURVEY FOR
 FREDERICK N. & BERNICE C. SINGER
 O.L. TO EATON TOWNSHIP
 LORAIN COUNTY OHIO
 SCALE 1"=100' JULY, 1971
 LAUNDON, HUFFMAN & SIMON - SURVEYORS