11-00-070-000-
11-00-070-A
SCAN #46727

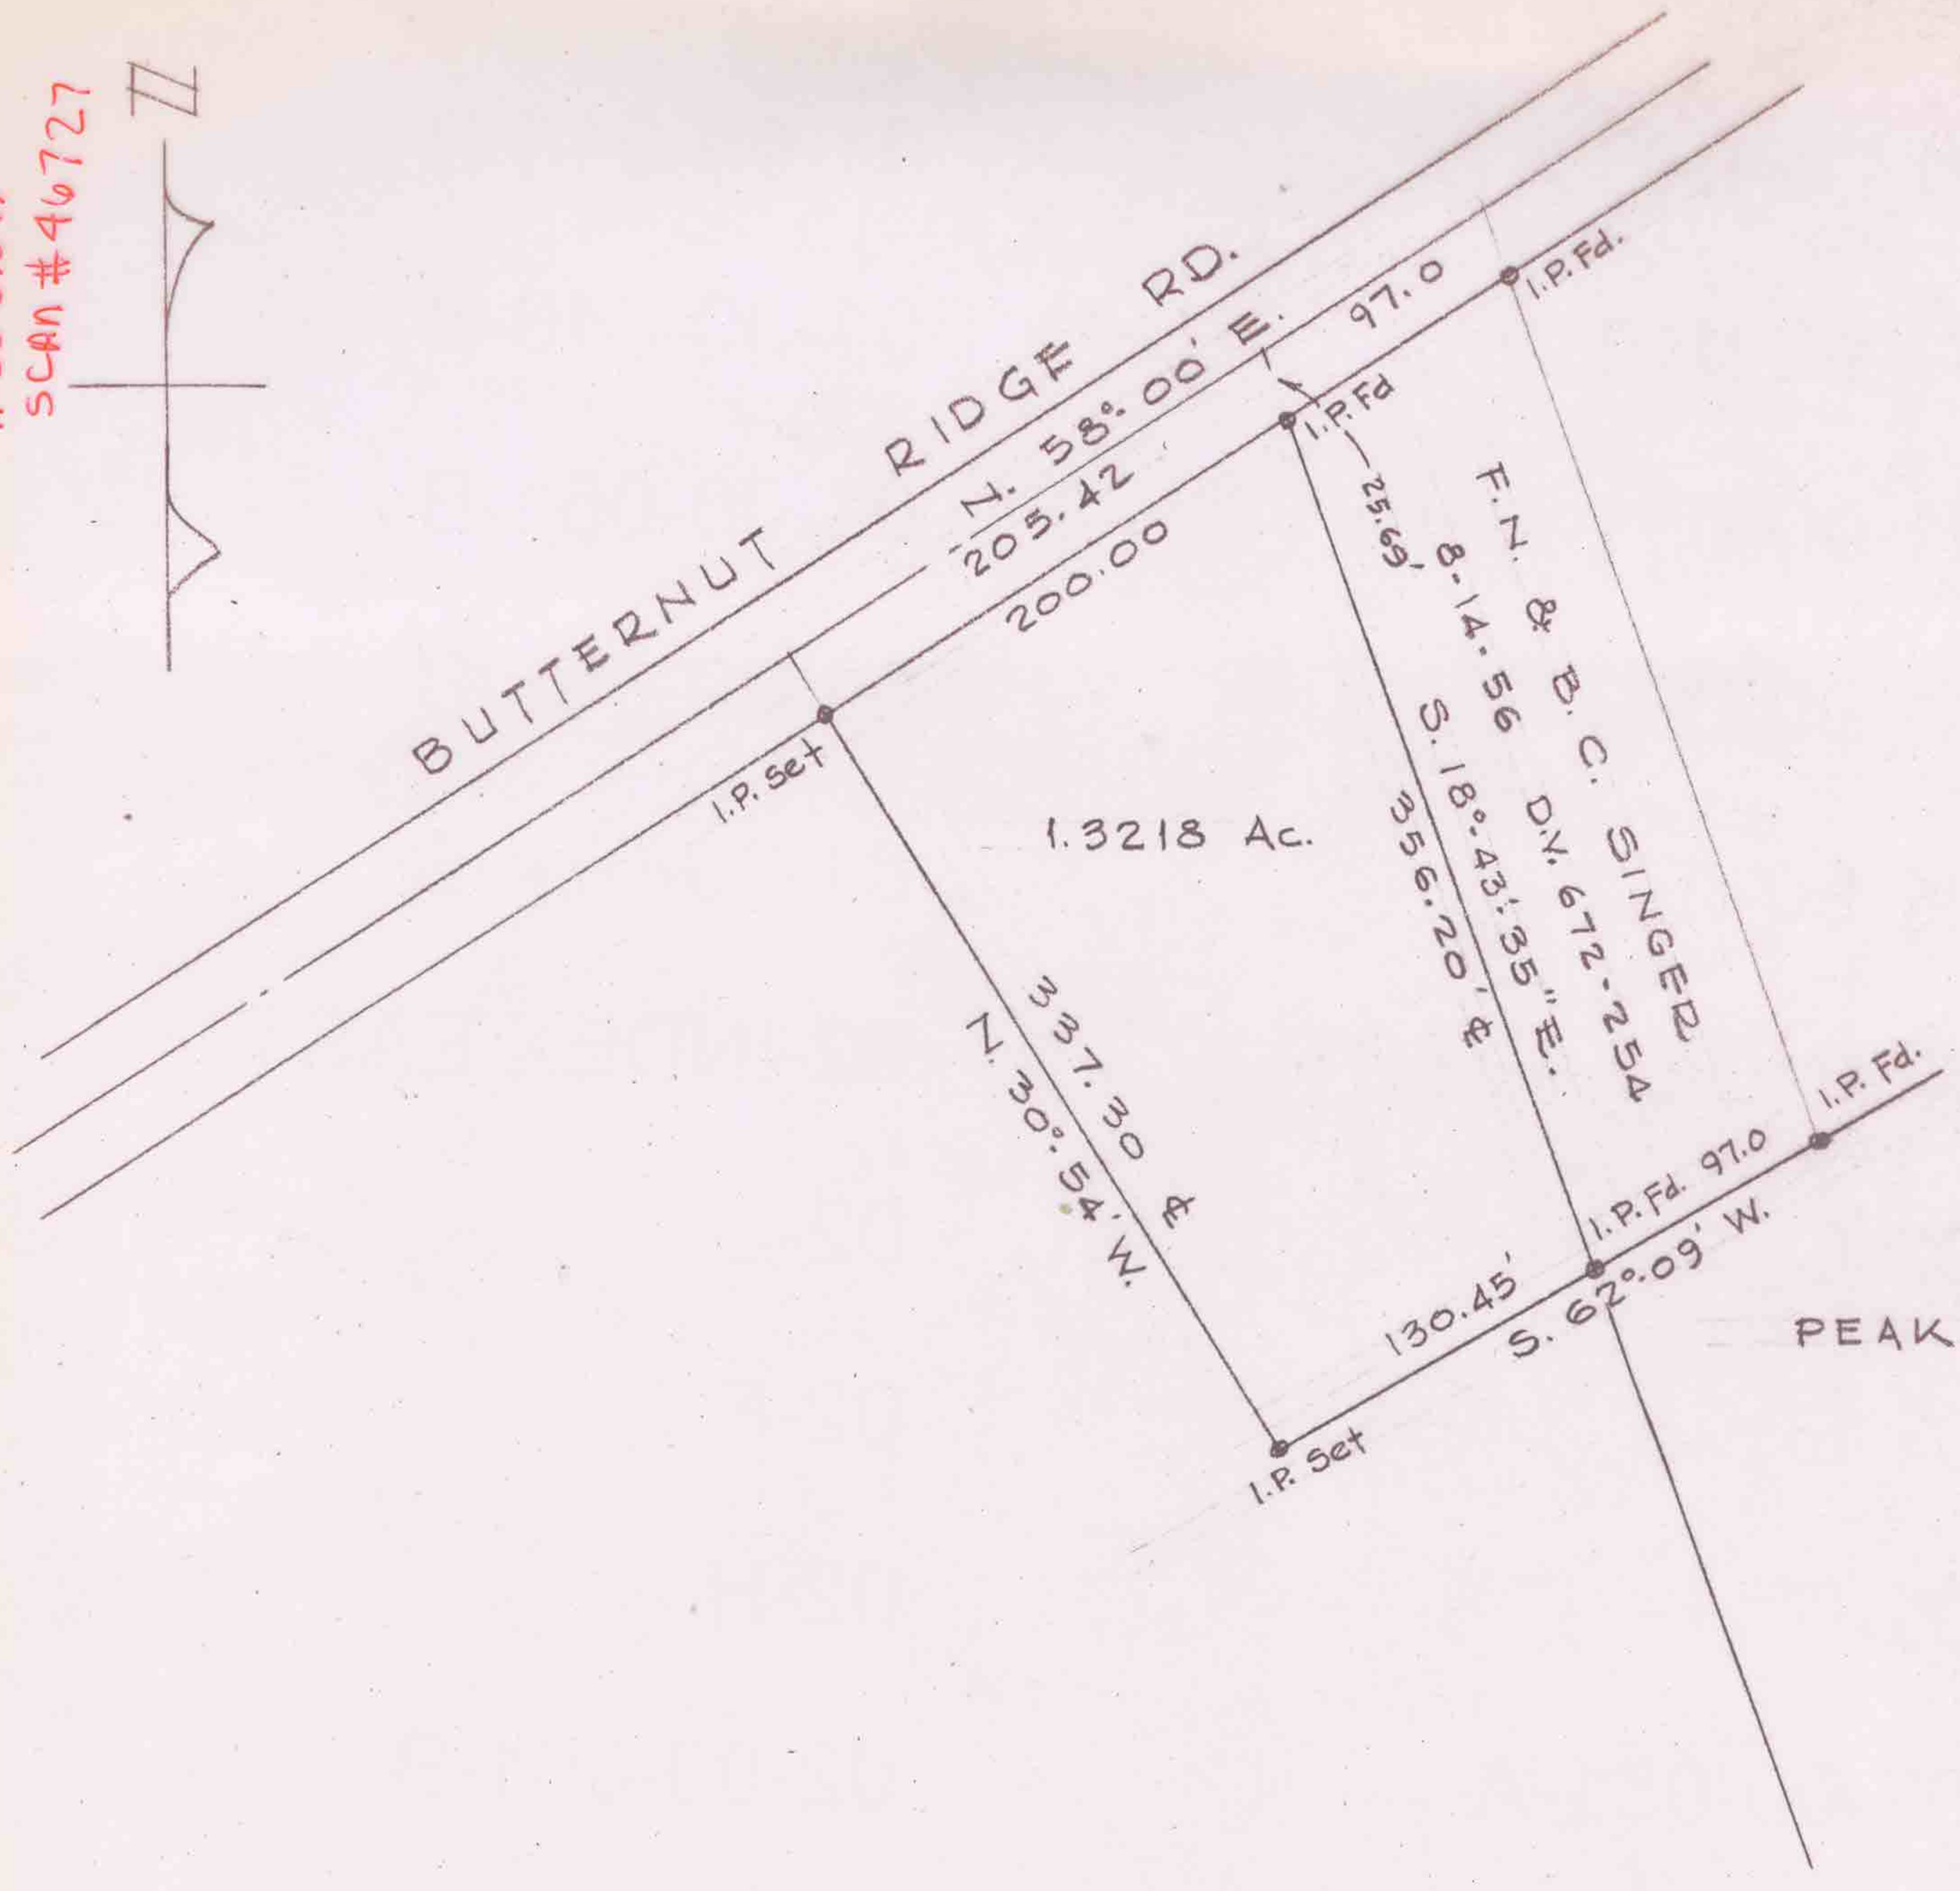

SURVEY FOR HELEN THOMAS

O.L. 70 EATON TWP.

LORAIN COUNTY OHIO

SCALE 1" = 100' MARCH, 1973

LAUNDON · SIMON · CAHL & ASSOC.

ENGINEERS - SURVEYORS

J.N. 73-90
F.B. 181-4