


11-00-084-000
11-00-084.
SCAN# 46737

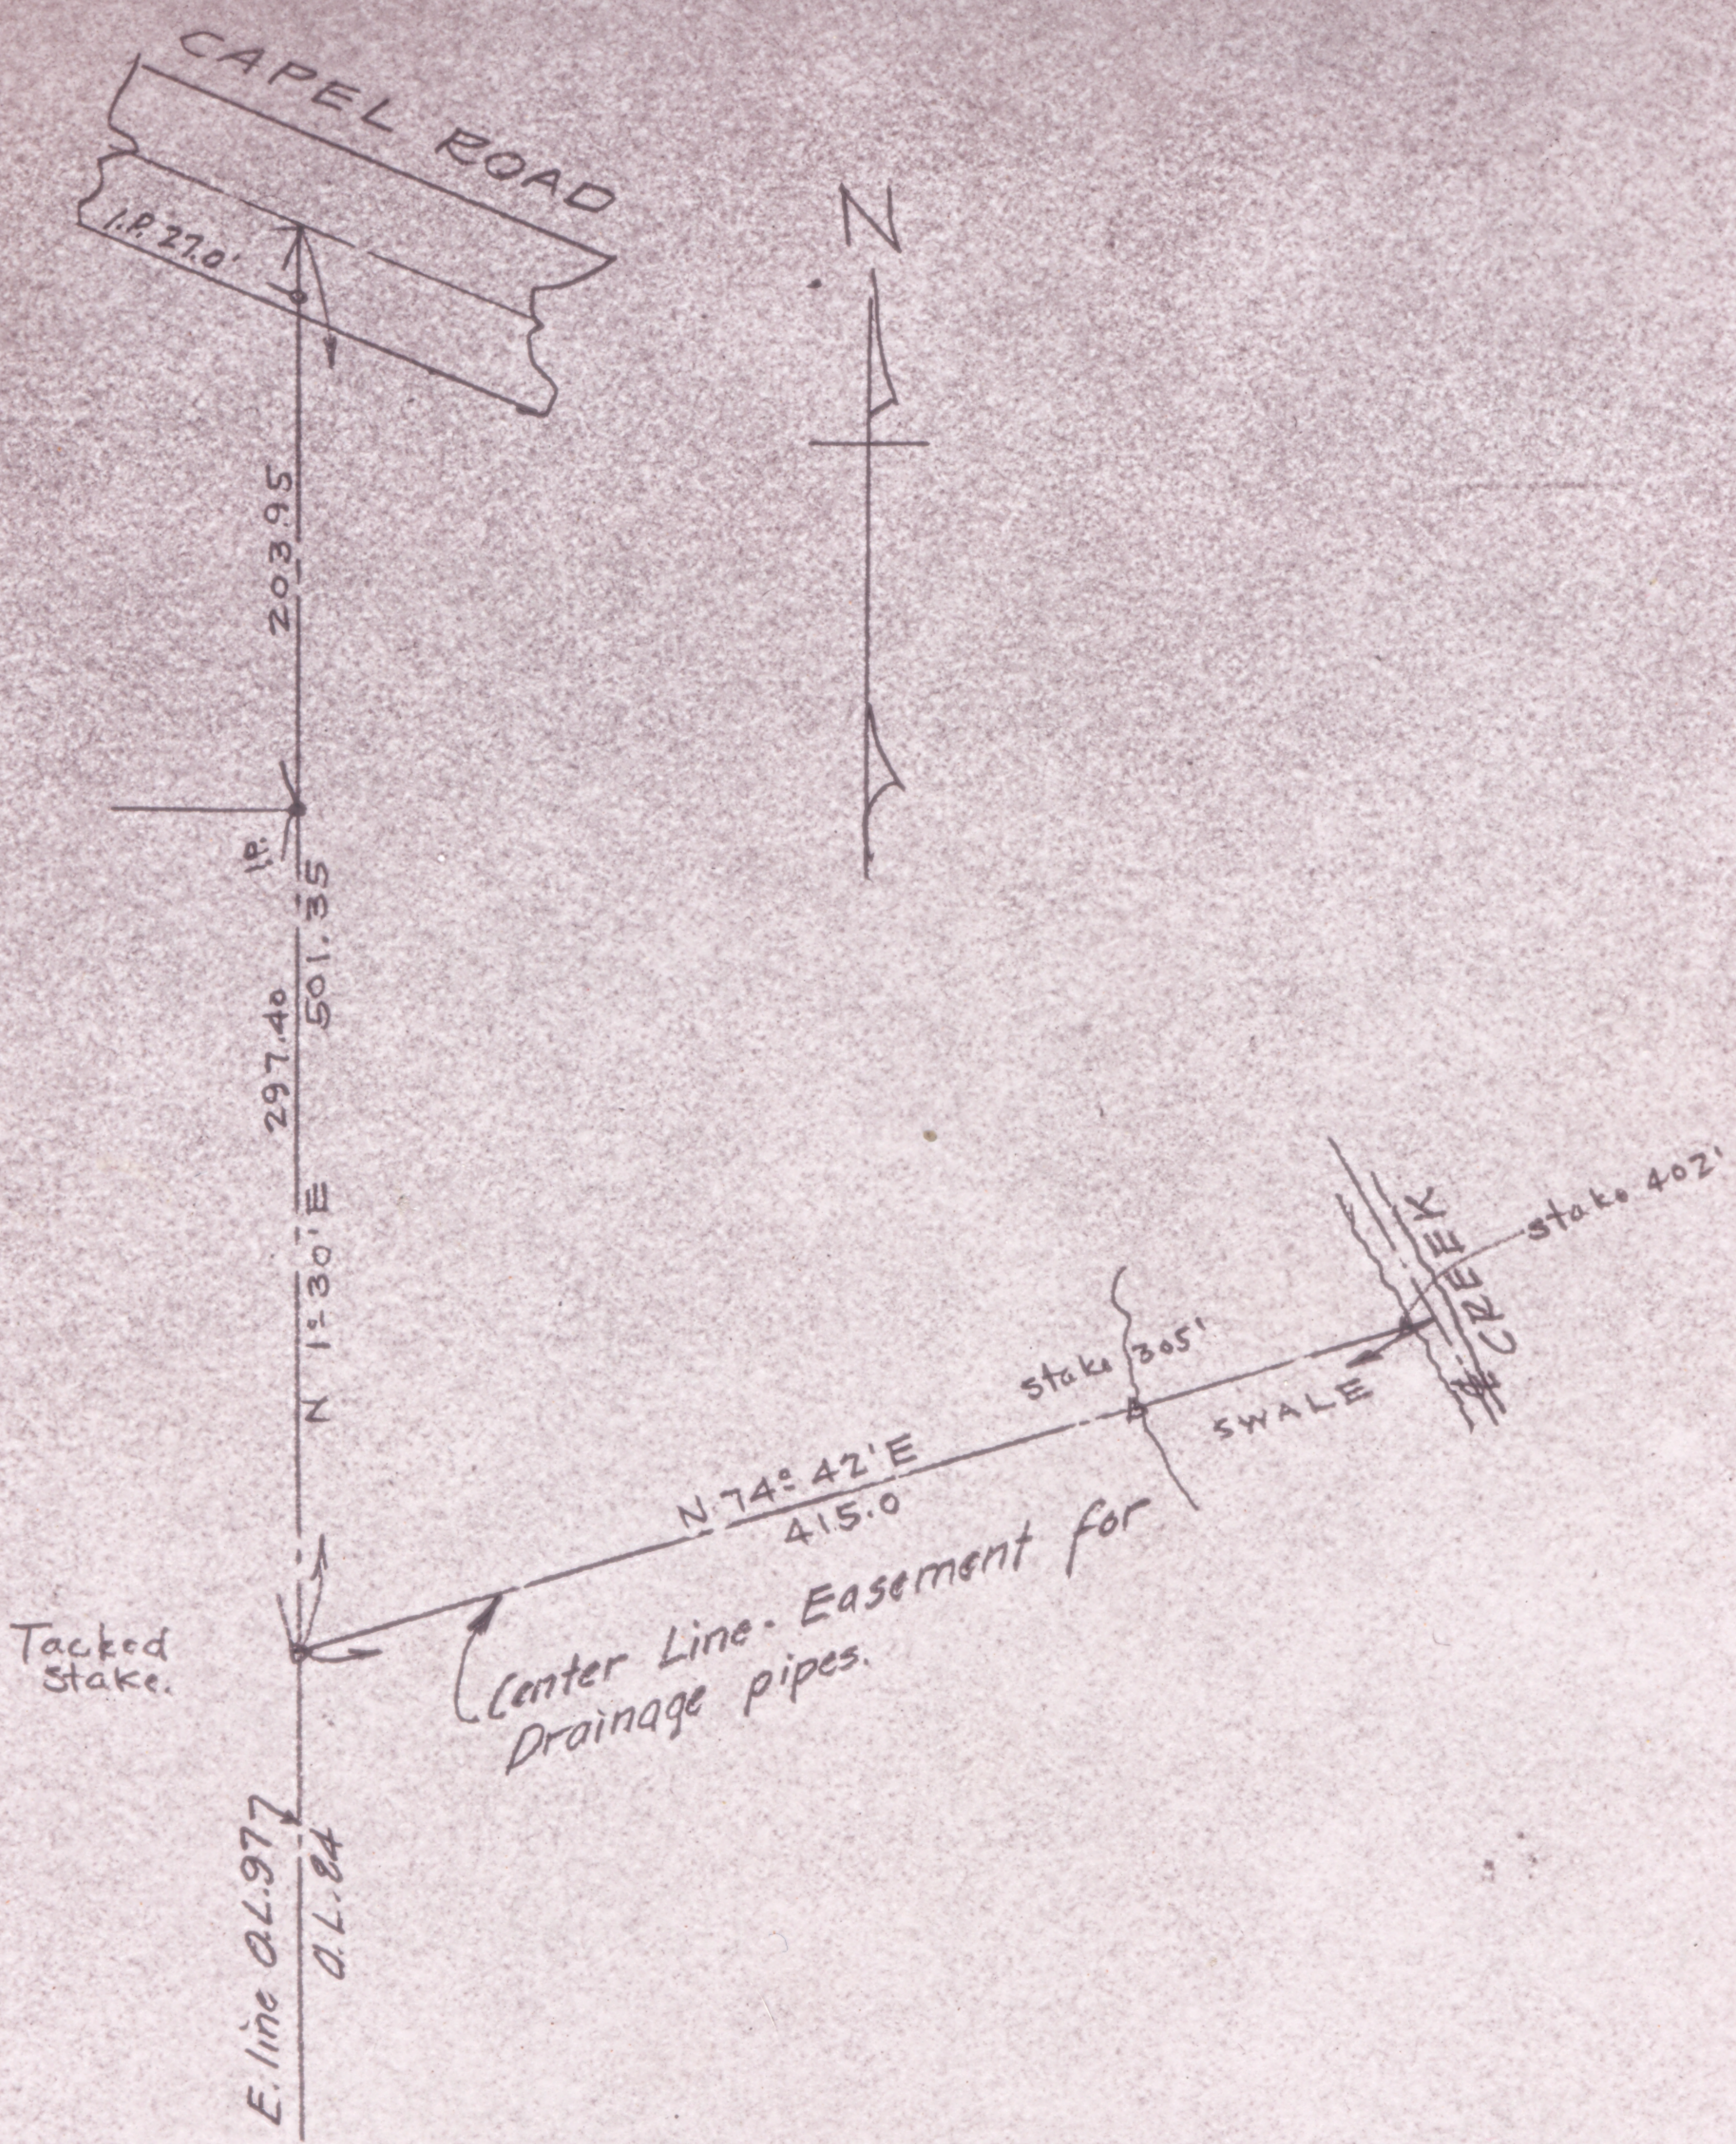

SURVEY FOR MIDVILLE BD OF EDUCATION
EASEMENT FOR DRAINAGE PIPES.
O.L. 84. EATON TP. LORAIN CO. OHIO
SCALE 1"=100' AUG. 17. 1954
T.W. LAUNDON REG. SURVEYOR. #689.