


FILE SEP. 11-00-087-000-003
11-00-087-B
SCAN # 46738

CARL HILLMAN
5/28/28 D.V. 236 P. 413

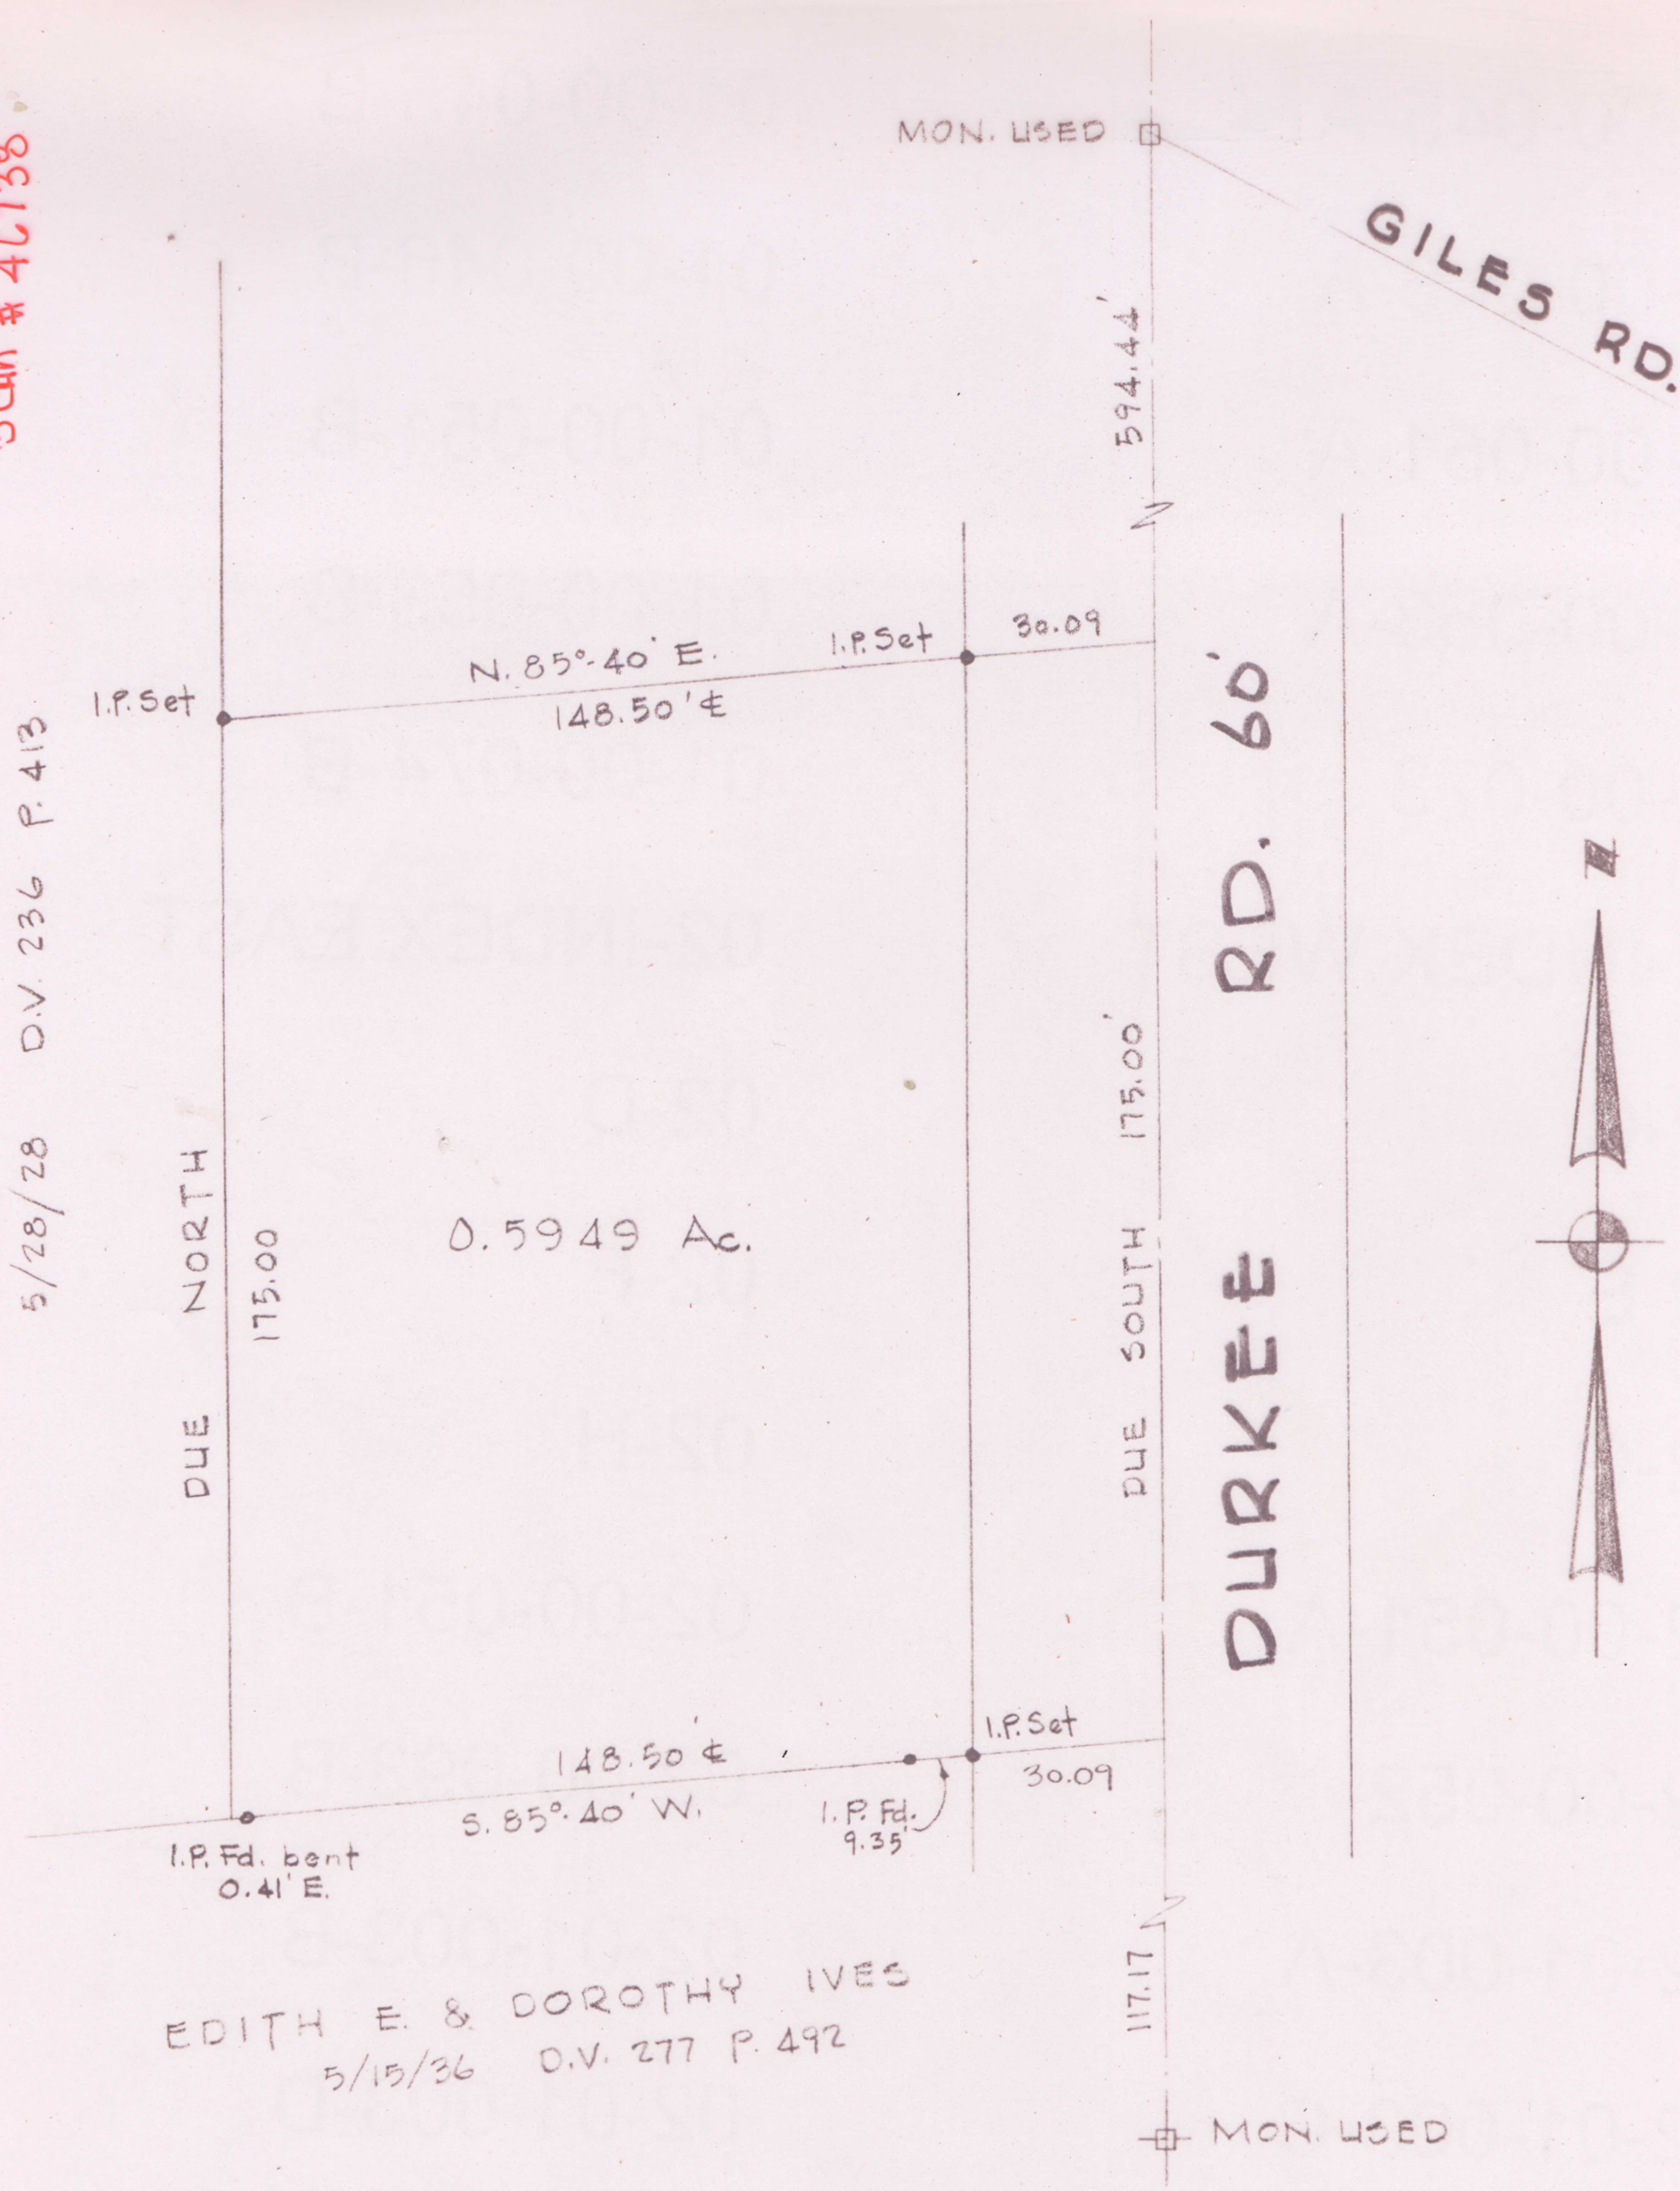

EDITH E. & DOROTHY IVES
5/15/36 D.V. 277 P. 492

SCOTT & BILLIE I. SMITH

O.L. 87 EATON TWP. LORAIN COUNTY OHIO

SCALE 1"=40' SEPT. 1978

LAUNDON • SIMON • CAHL & ASSOC.
ENGINEERS SURVEYORS

78-798 F.B. 156/28