



11-00-088-000-  
11-00-088-B  
SCAN # 46739

ELMER C YARNISH  
6-24-58 D.V. 724 P. 102

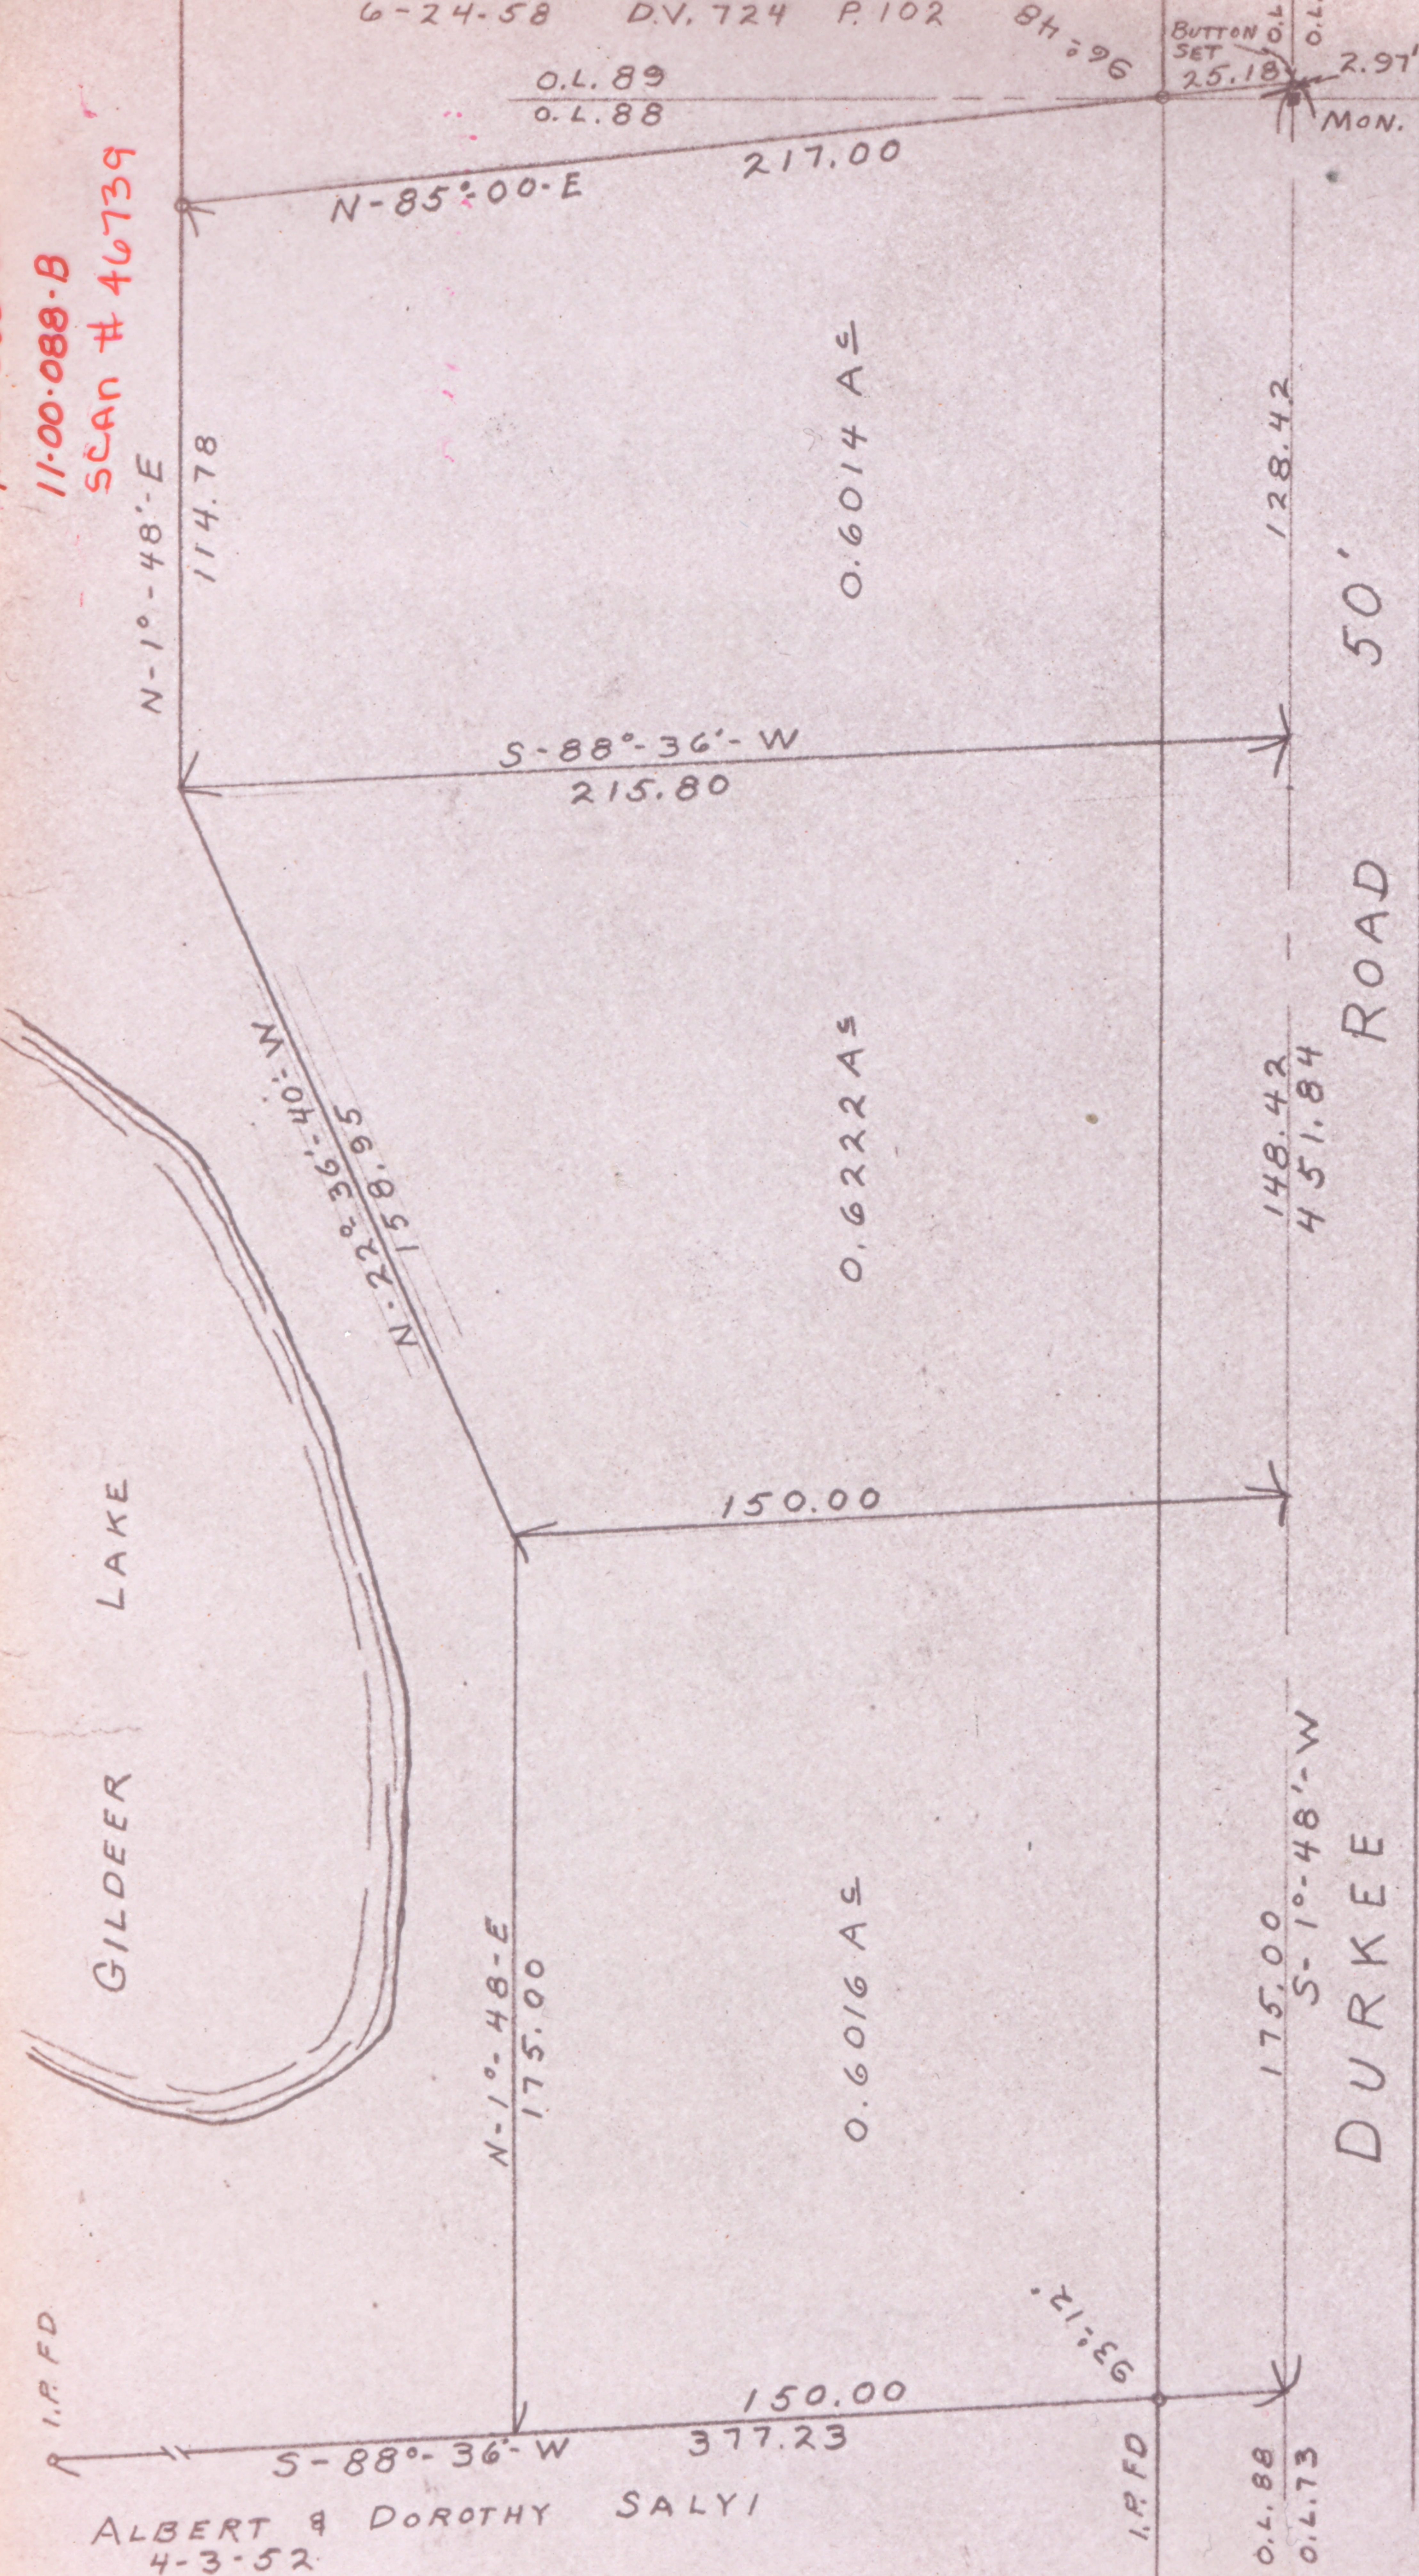

ALBERT & DOROTHY SALYI  
4-3-52

SURVEY FOR  
CLETE GILGENBACH  
PART OF O.L. 88 & 89  
EATON TOWNSHIP  
LORAIN CO., OHIO  
T.W. LAUNDON REG. SURVEYOR  
SCALE 1"=50' JULY 1958

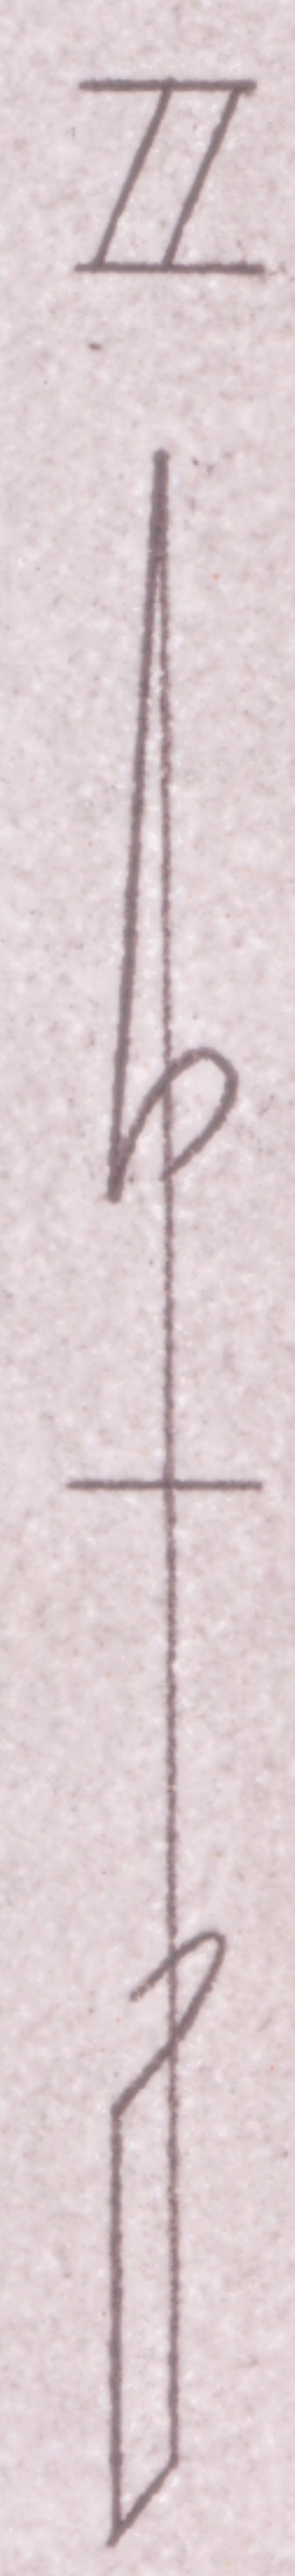

I.R.F.D.

I.R.F.D.

93:12'