


11-00-098-000-023
11-00-098-000-024
11-00-098-A
SCAN # 46772

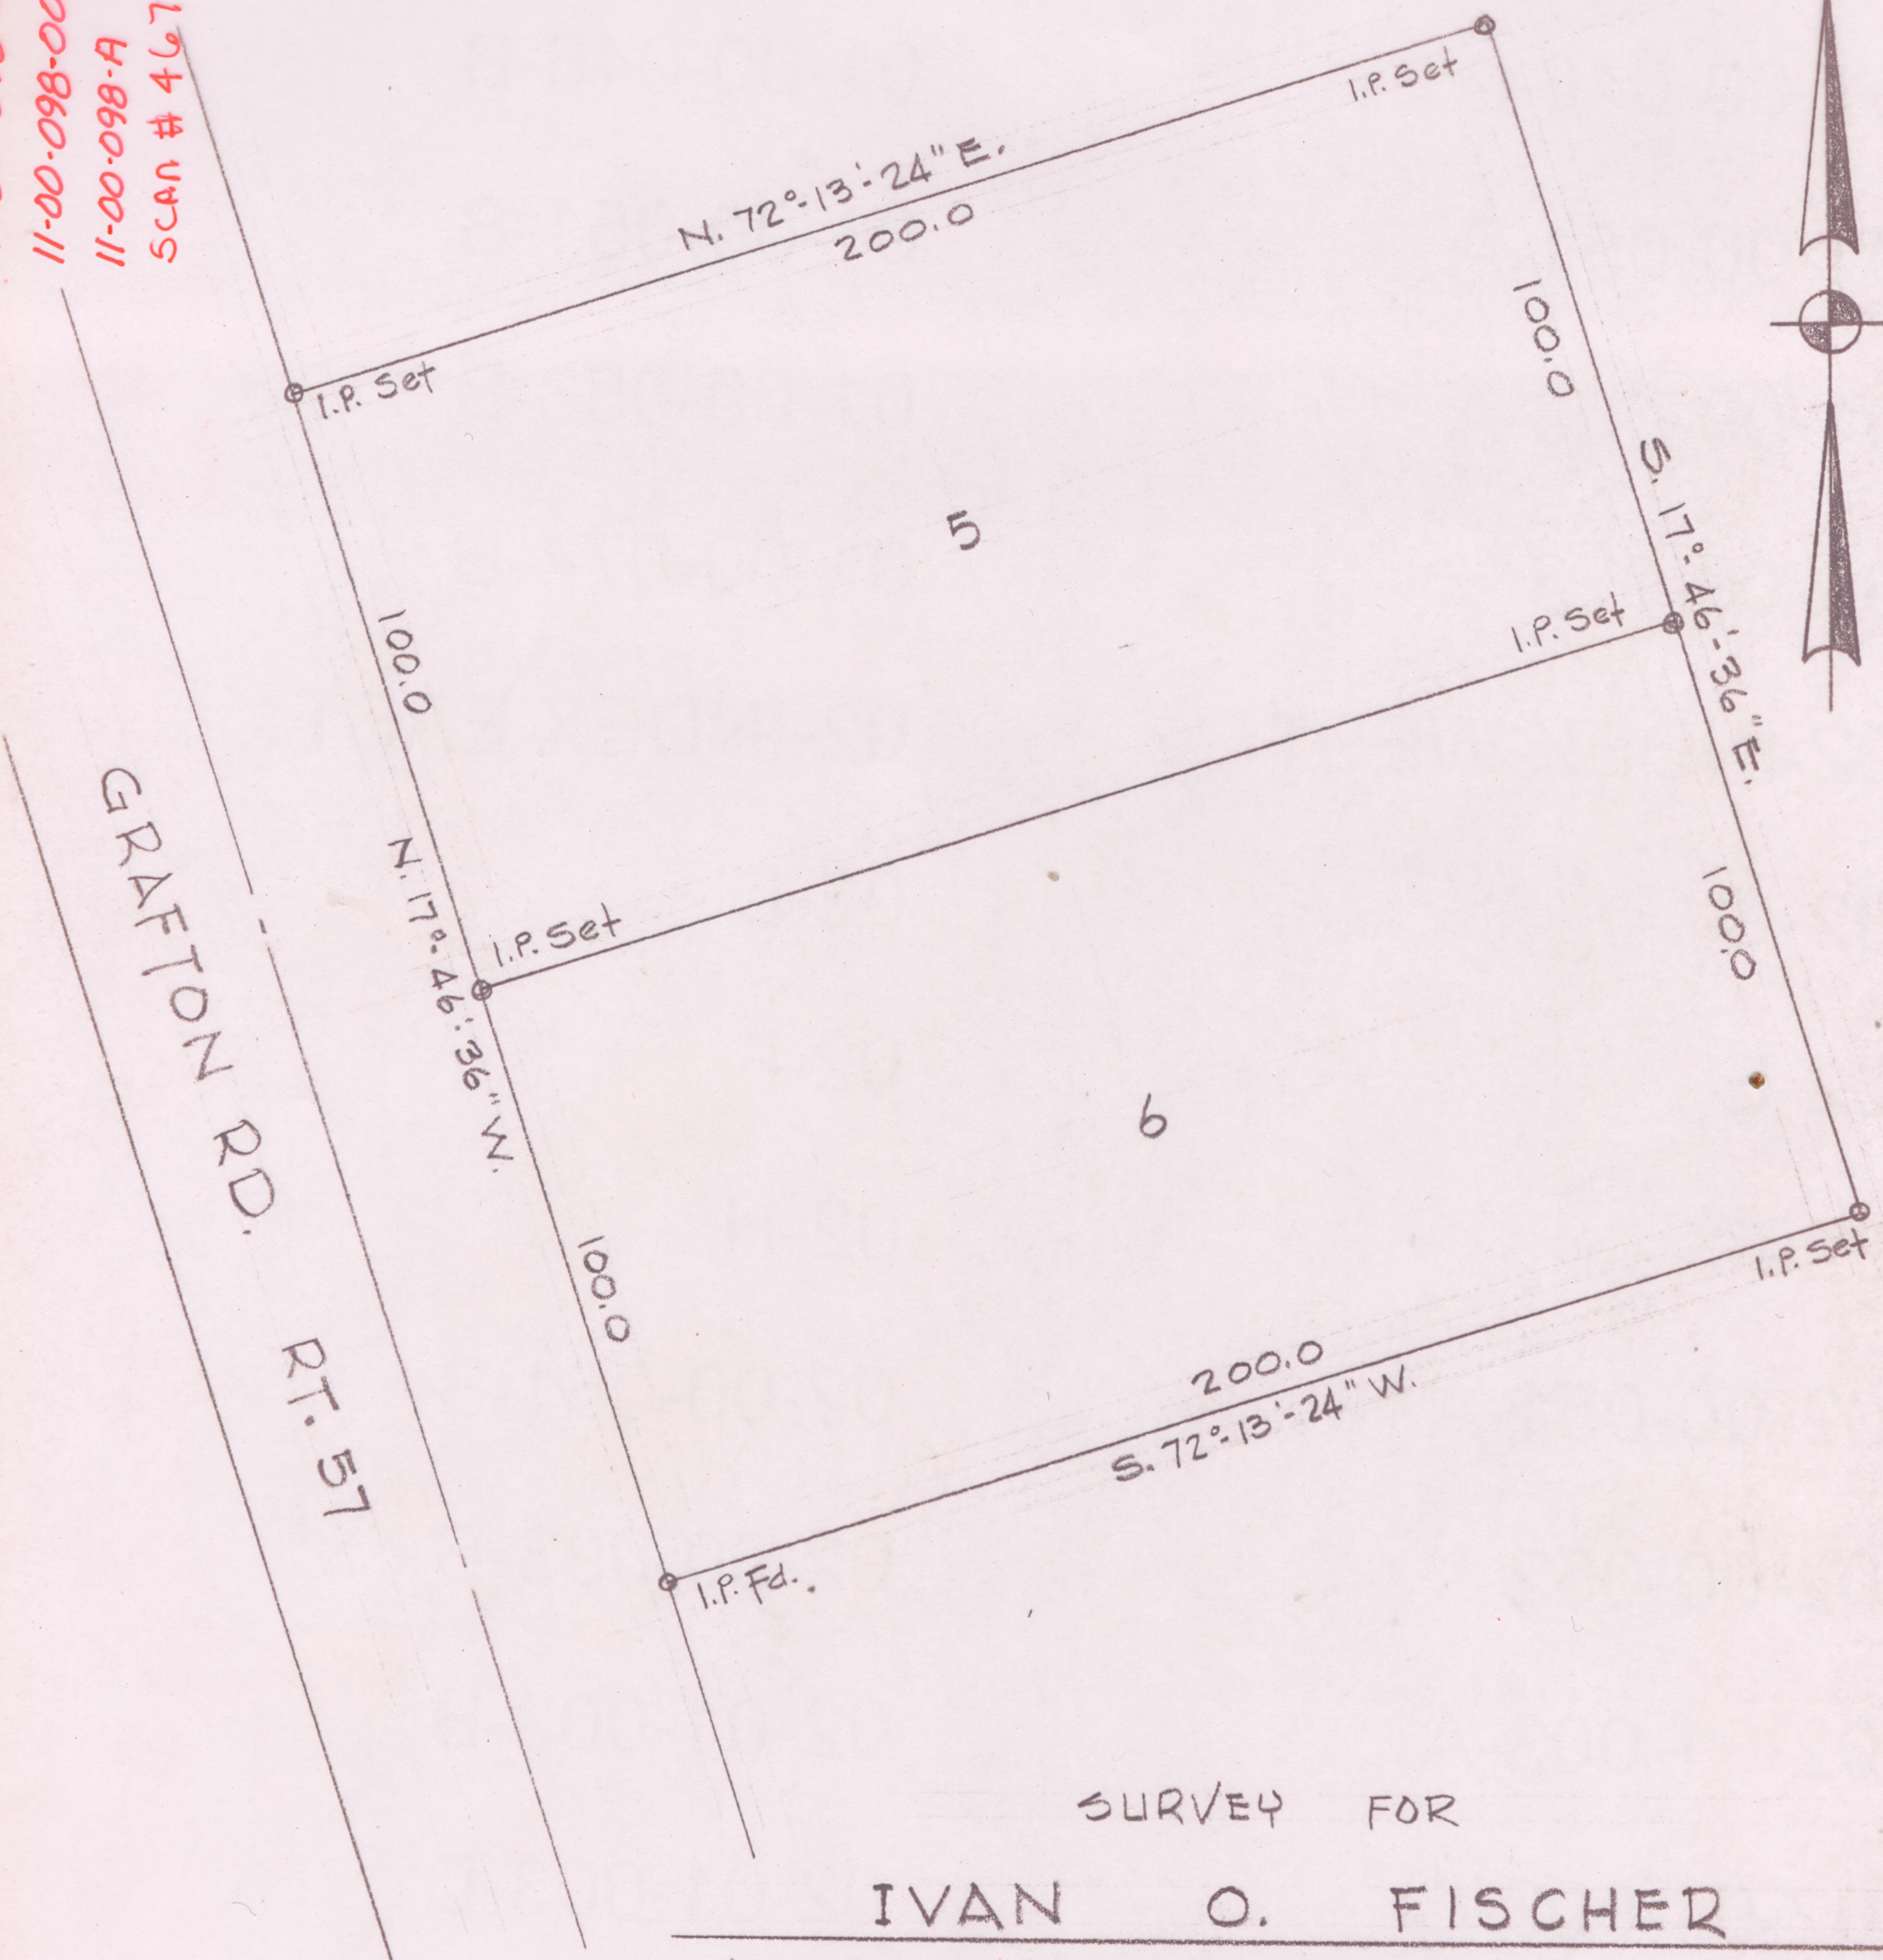

SURVEY FOR

IVAN O. FISCHER

S/L's 5 & 6 of C.A. MILLER SUB'N. PV. 17 P. 13-A
O.L. 98 EATON TWP. LORAIN CO. OHIO
SCALE 1"=40' JULY, 1978
LAUNDON • SIMON • CAHL & ASSOC.
ENGINEER SURVEYORS

Job - 78-750