


12-00-043-000-004  
12-00-043-B  
SCAN # 46783

WM. H. & EVA. A. BEAUMONT D.V. 101 PG. 89

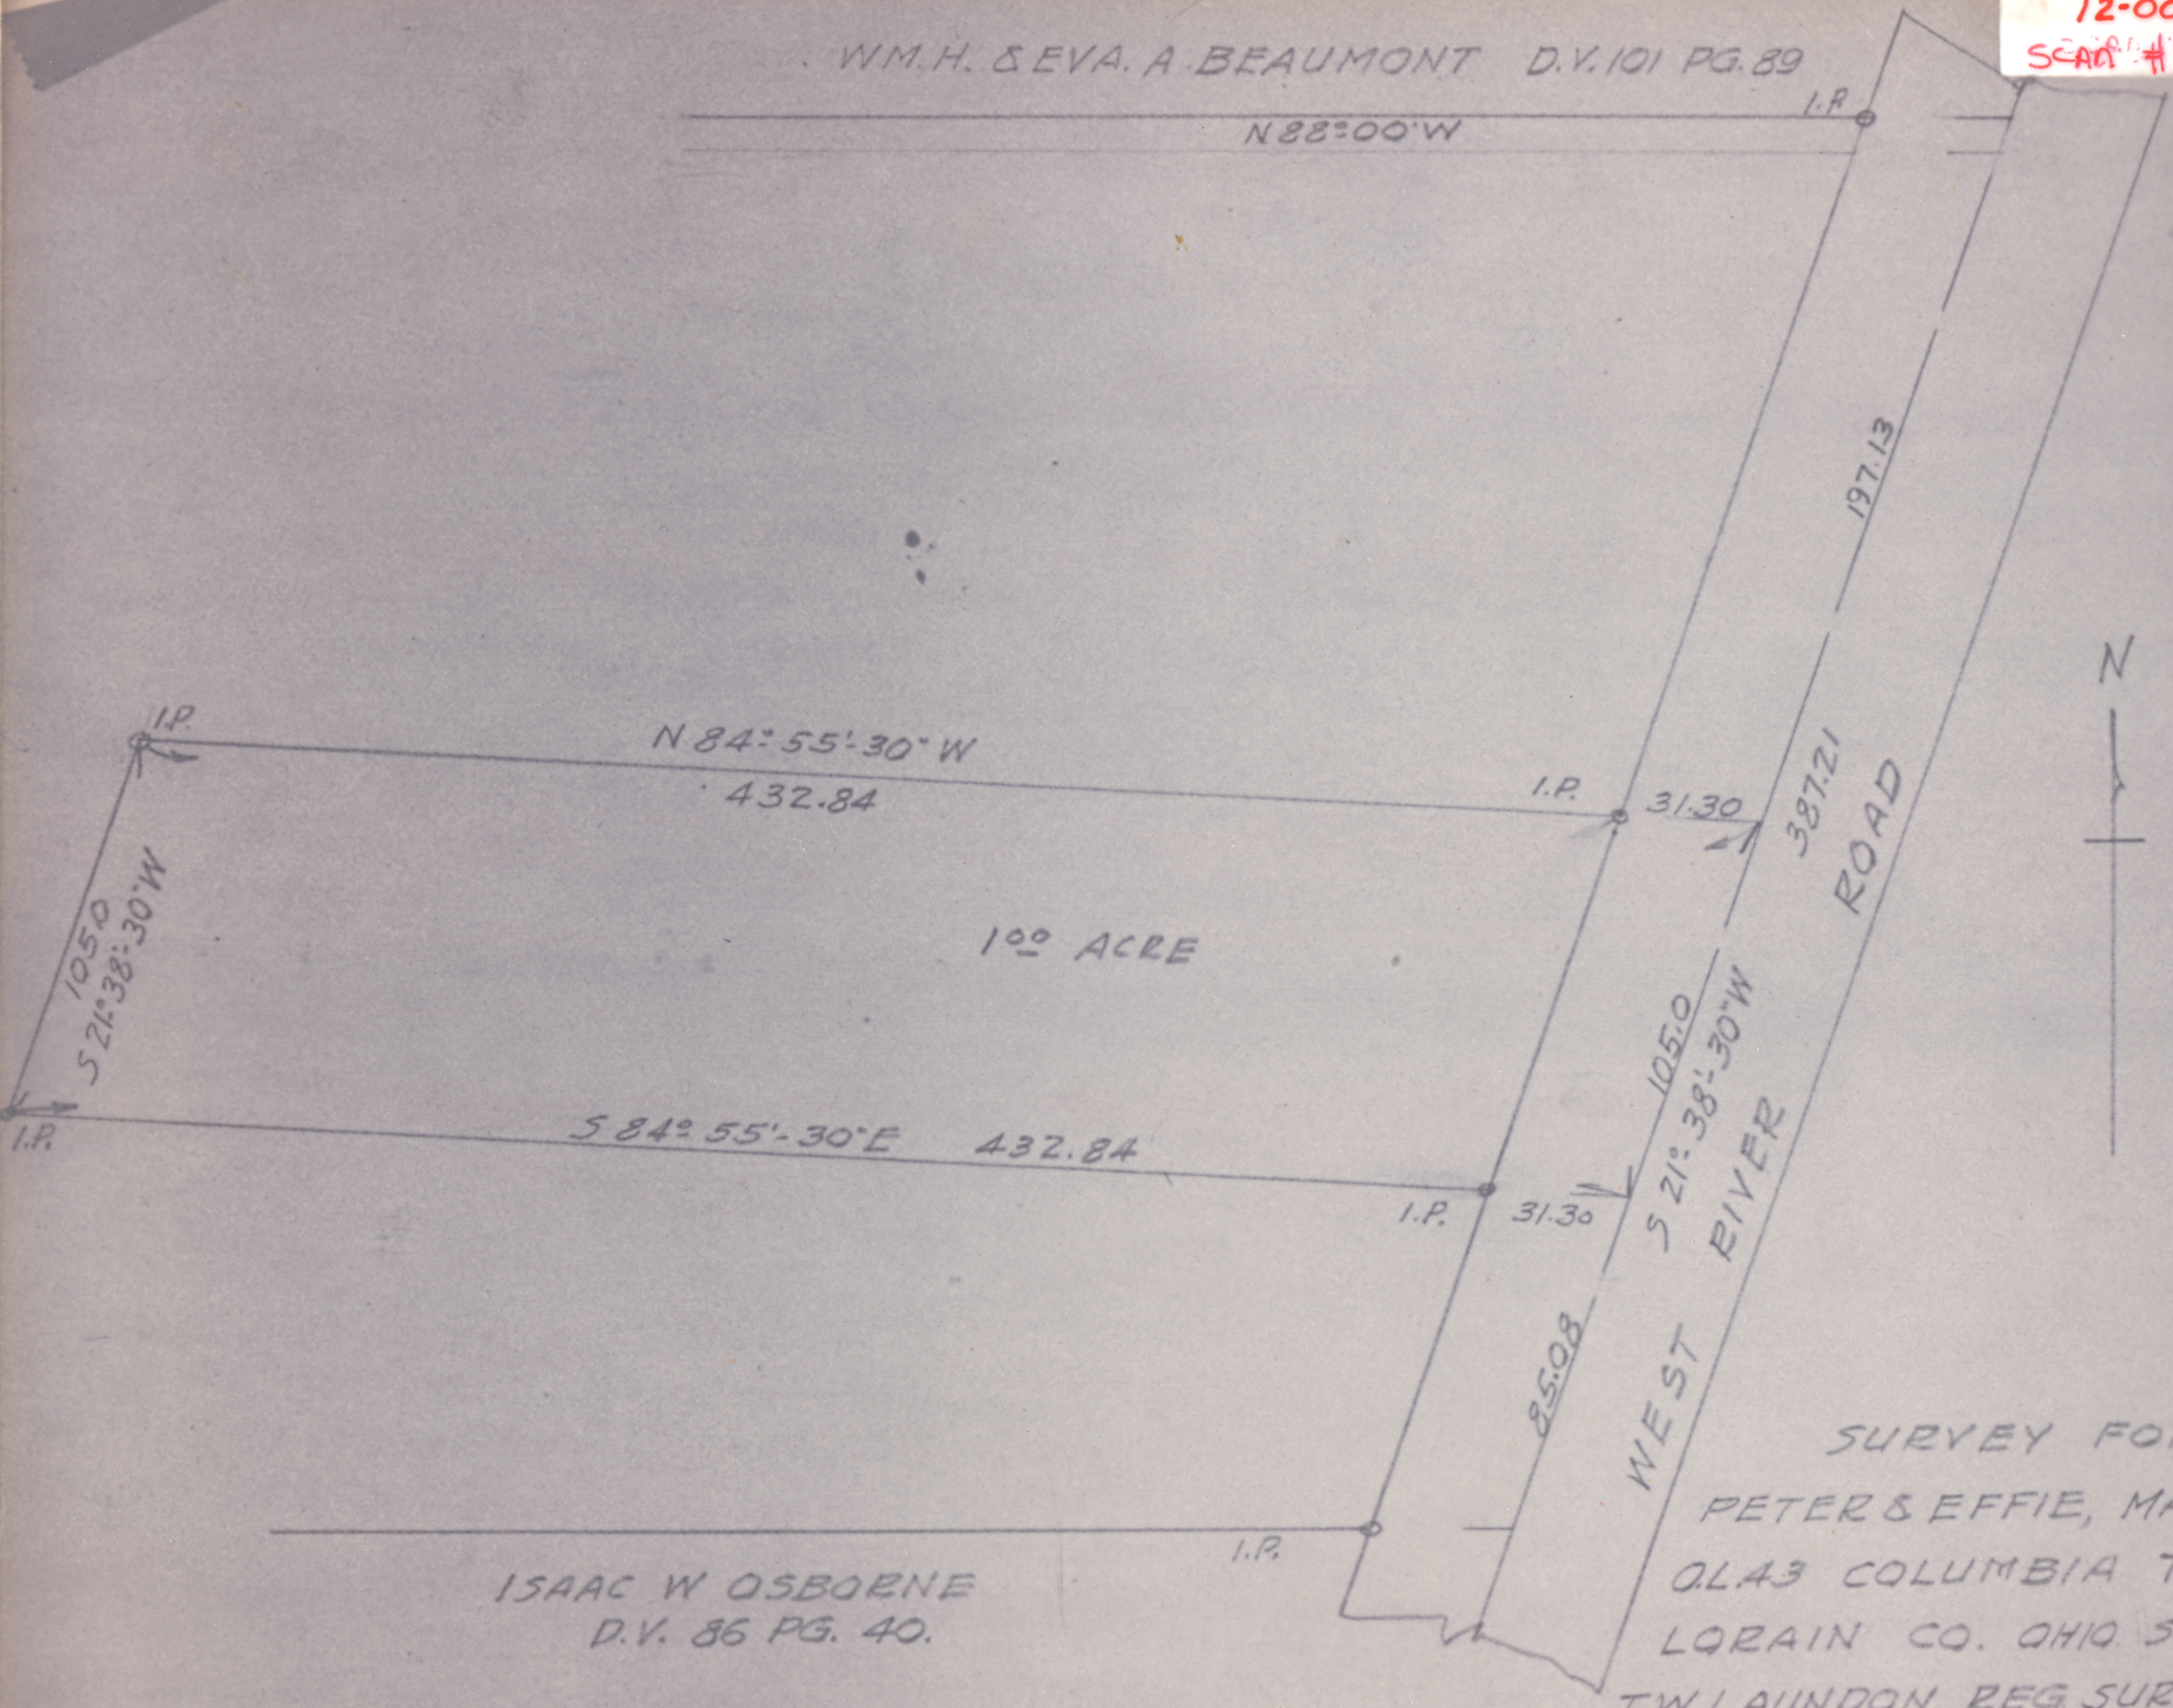

N 84° 55' 30" W

432.84


S 84° 55' 30" E 432.84

105.0  
S 21° 38' 30" W

I.P.

31.30

387.21  
ROAD

197.13

105.0  
S 21° 38' 30" W

WEST RIVER

I.P.

31.30

85.08

I.P.

ISAAC W OSBORNE  
D.V. 86 PG. 40.

SURVEY FOR  
PETER & EFFIE, MALATINKA  
OL43 COLUMBIA TWP  
LORAIN CO. OHIO SCALE 1"=60'  
T.W. LAUNDON REG SURVEYOR.

