


5 CAN# 12-00-044-000  
46785 12-00-044

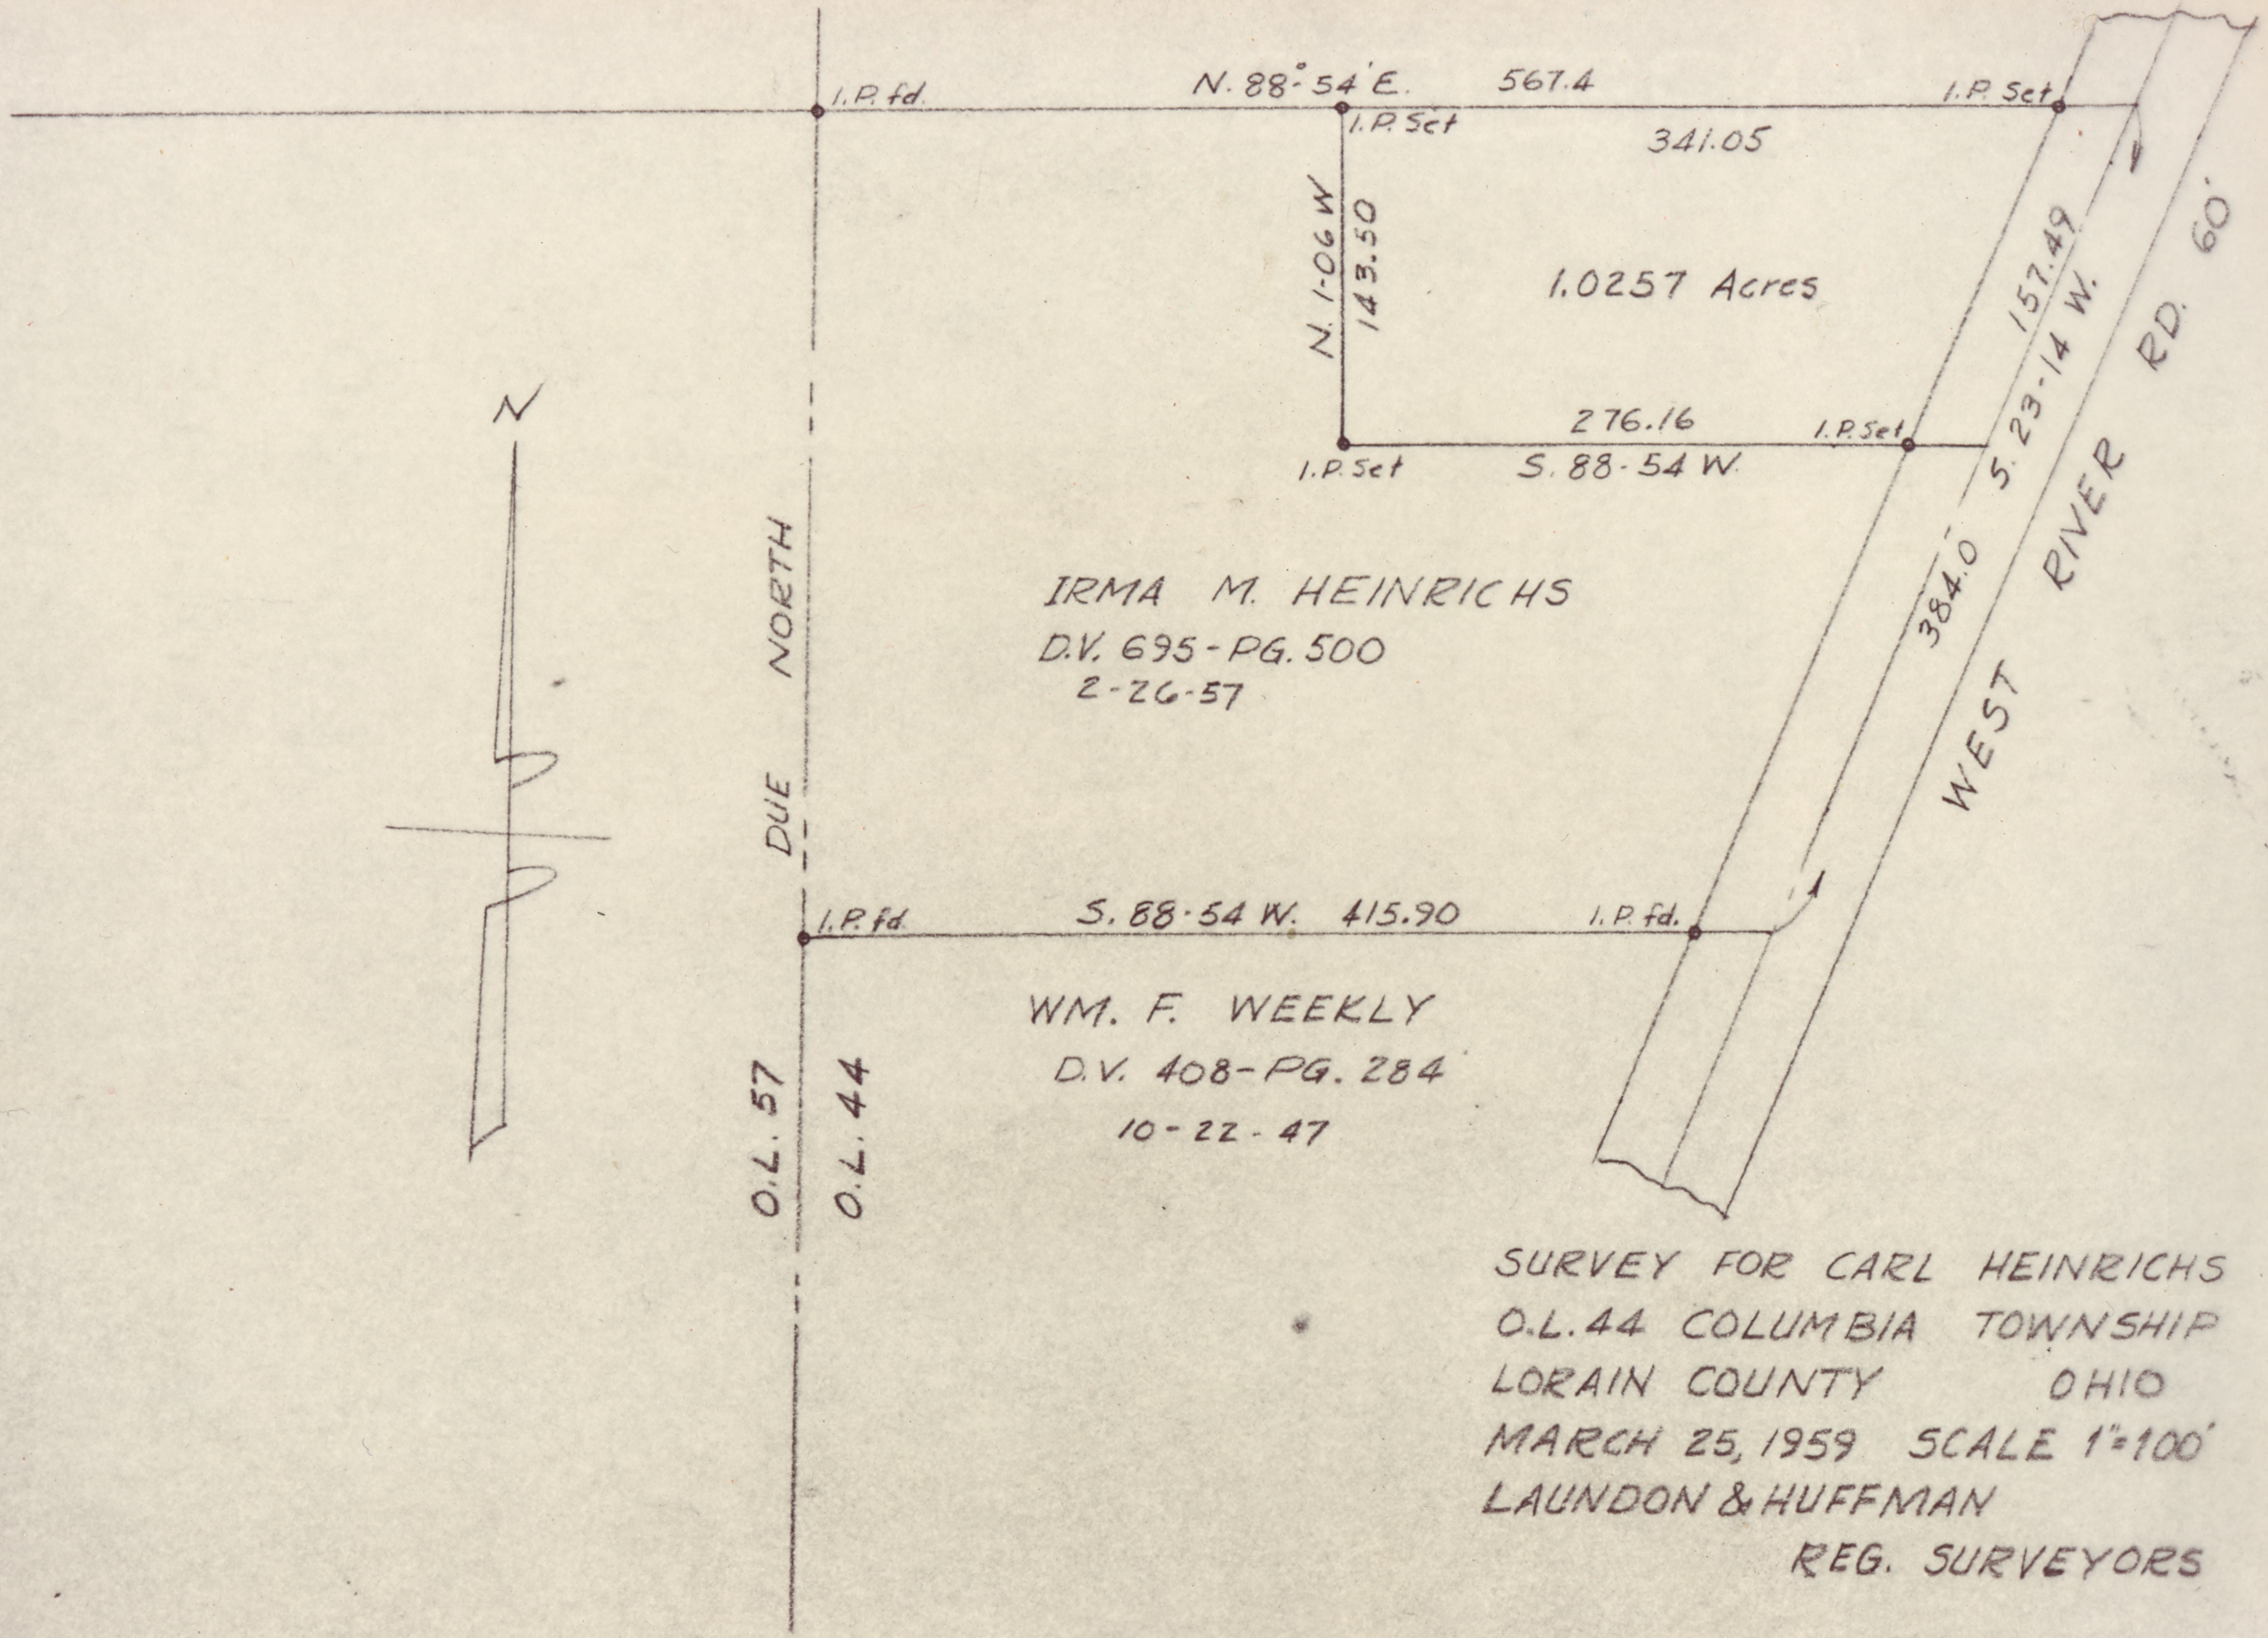

IRMA M. HEINRICHS  
D.V. 695 - PG. 500  
2-26-57

WM. F. WEEKLY  
D.V. 408 - PG. 284  
10-22-47

SURVEY FOR CARL HEINRICHS  
O.L. 44 COLUMBIA TOWNSHIP  
LORAIN COUNTY OHIO  
MARCH 25, 1959 SCALE 1"=100'  
LAUNDON & HUFFMAN  
REG. SURVEYORS