

12-00-059-000-005
12-00-042-A
SCAN# 46788



THEODORE SANNA, PUPAKOWSKI

I.P. $S 87^{\circ} 52' E$
234.2 I.P.

$N 2^{\circ} 11' E$
558.0

558.0
 $S 2^{\circ} 11' W$

3.00 Acres

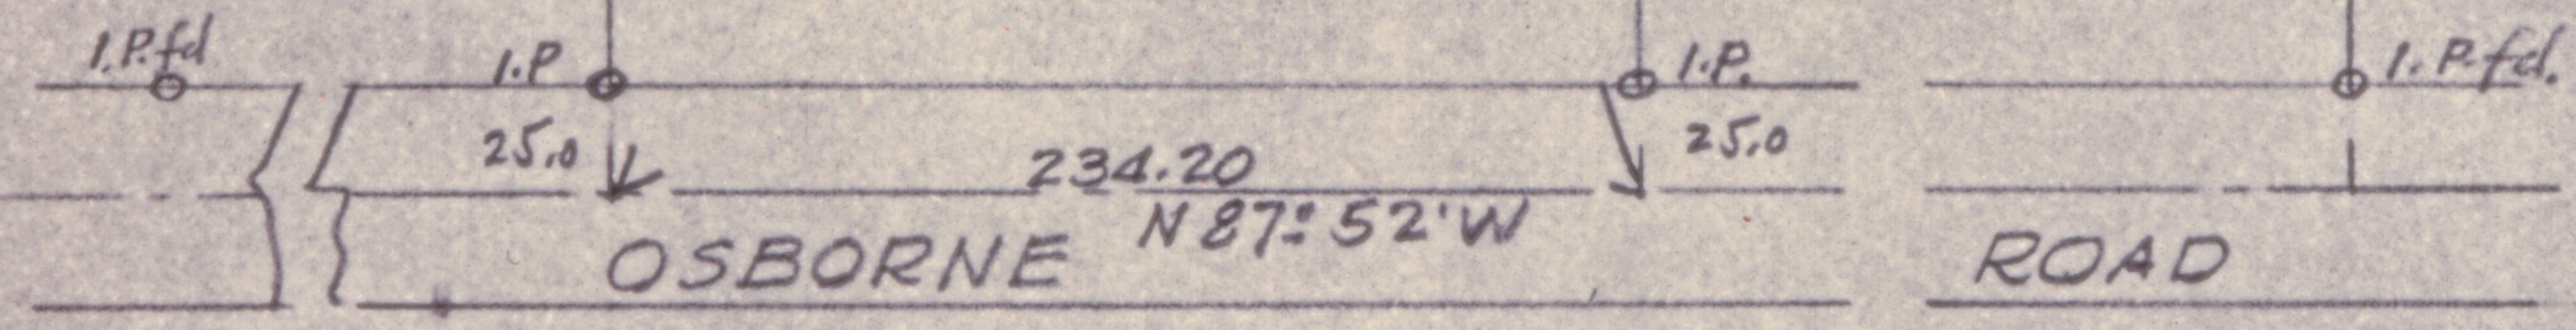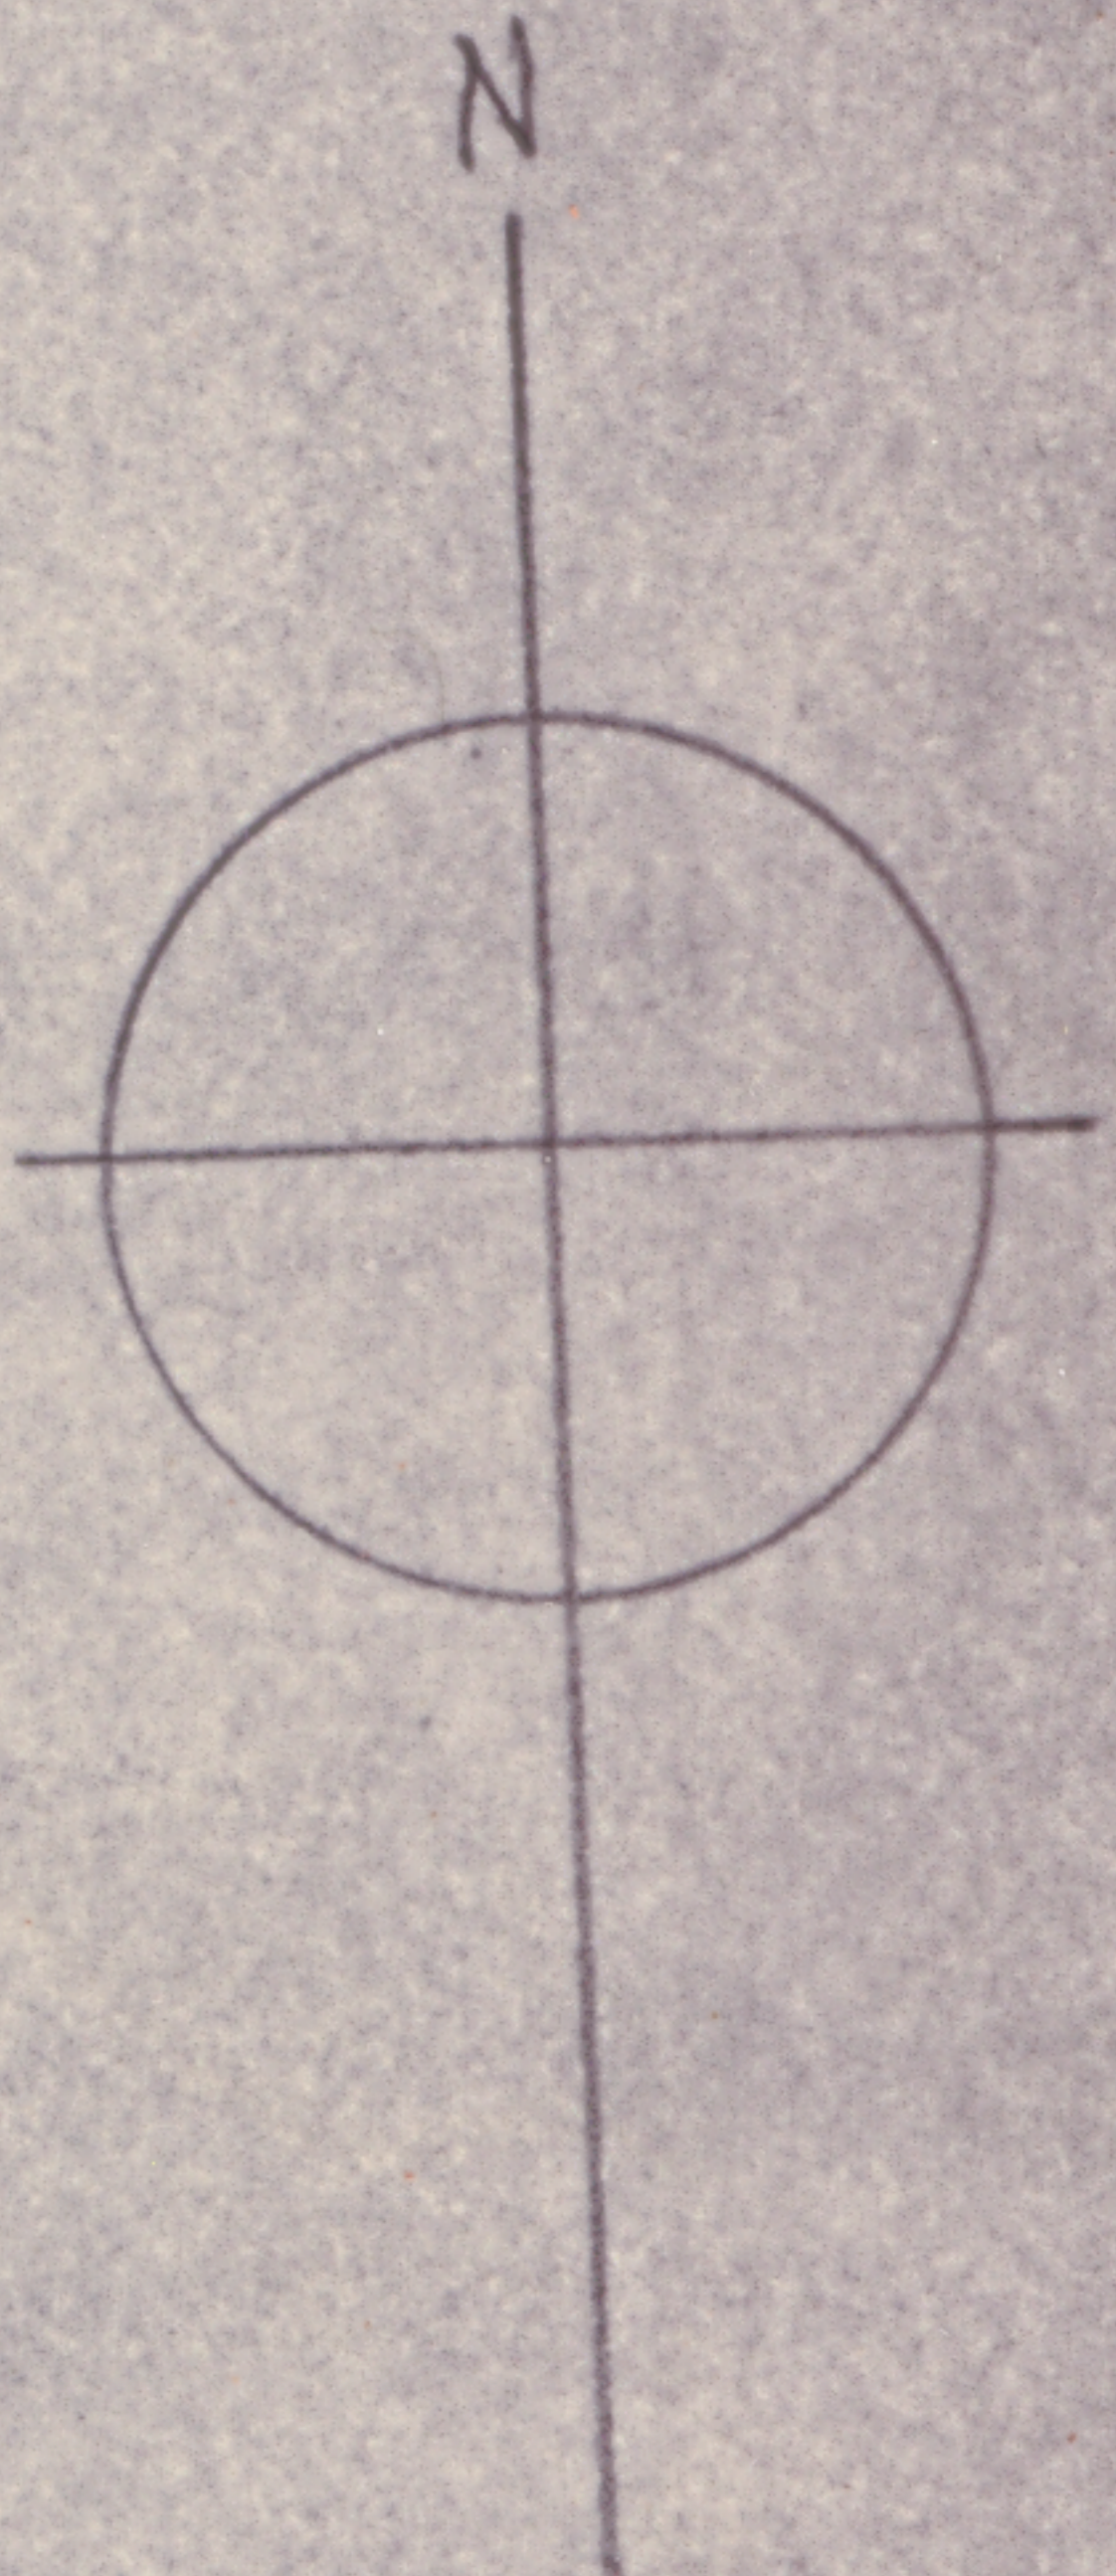

SURVEY FOR JOHN & MARY, HRIVNAK
PART OF ORIGINAL LOT N^o 42
COLUMBIA TWP. LORAIN CO. OHIO
SCALE 1" = 100' JULY 1, 1950
T.W. LAUNDON, REG. SURVEYOR