


13-10-20-000-001
13-B
SCAN # 46799

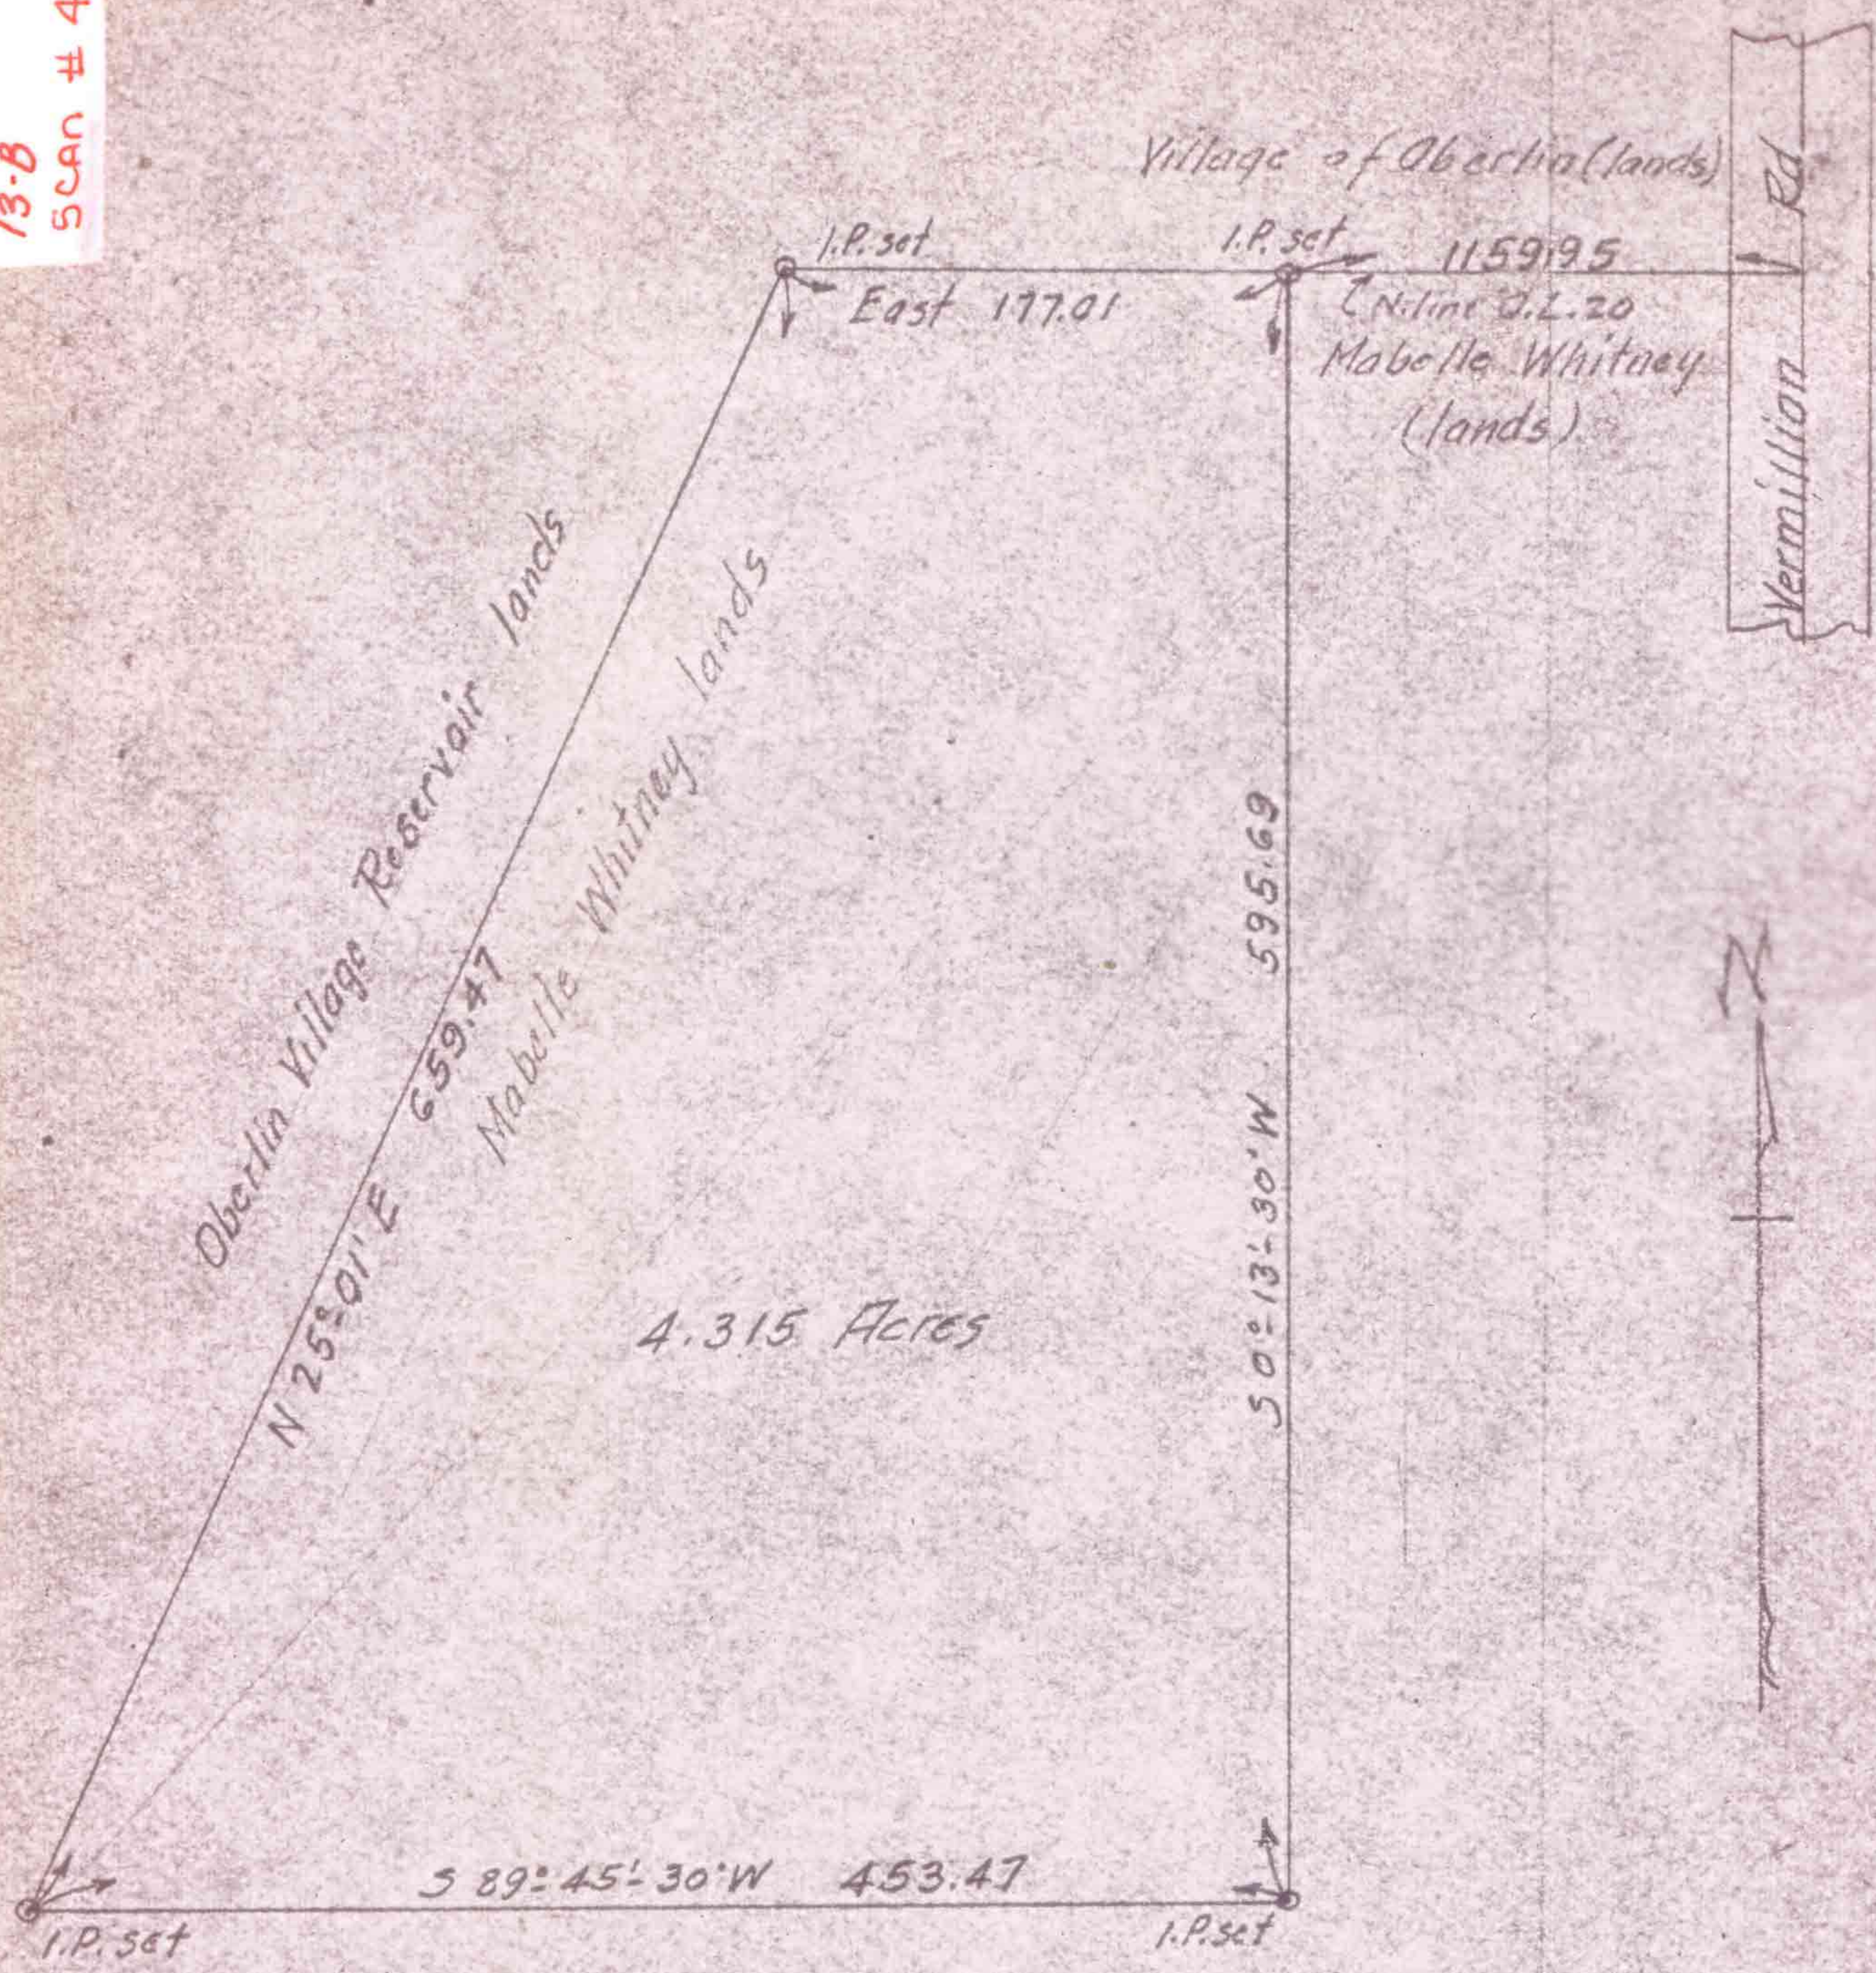

Survey for The Village of Oberlin
Part of Orig. Lot 20 Tr. 10. Camden Twnp.
Lorain Co. Ohio. Scale 1"=100'
T.W. Laudon Registered Surveyor.
11-1-44