13 - 11 - 024 - 000 - 001
13-B
SCAN #408804

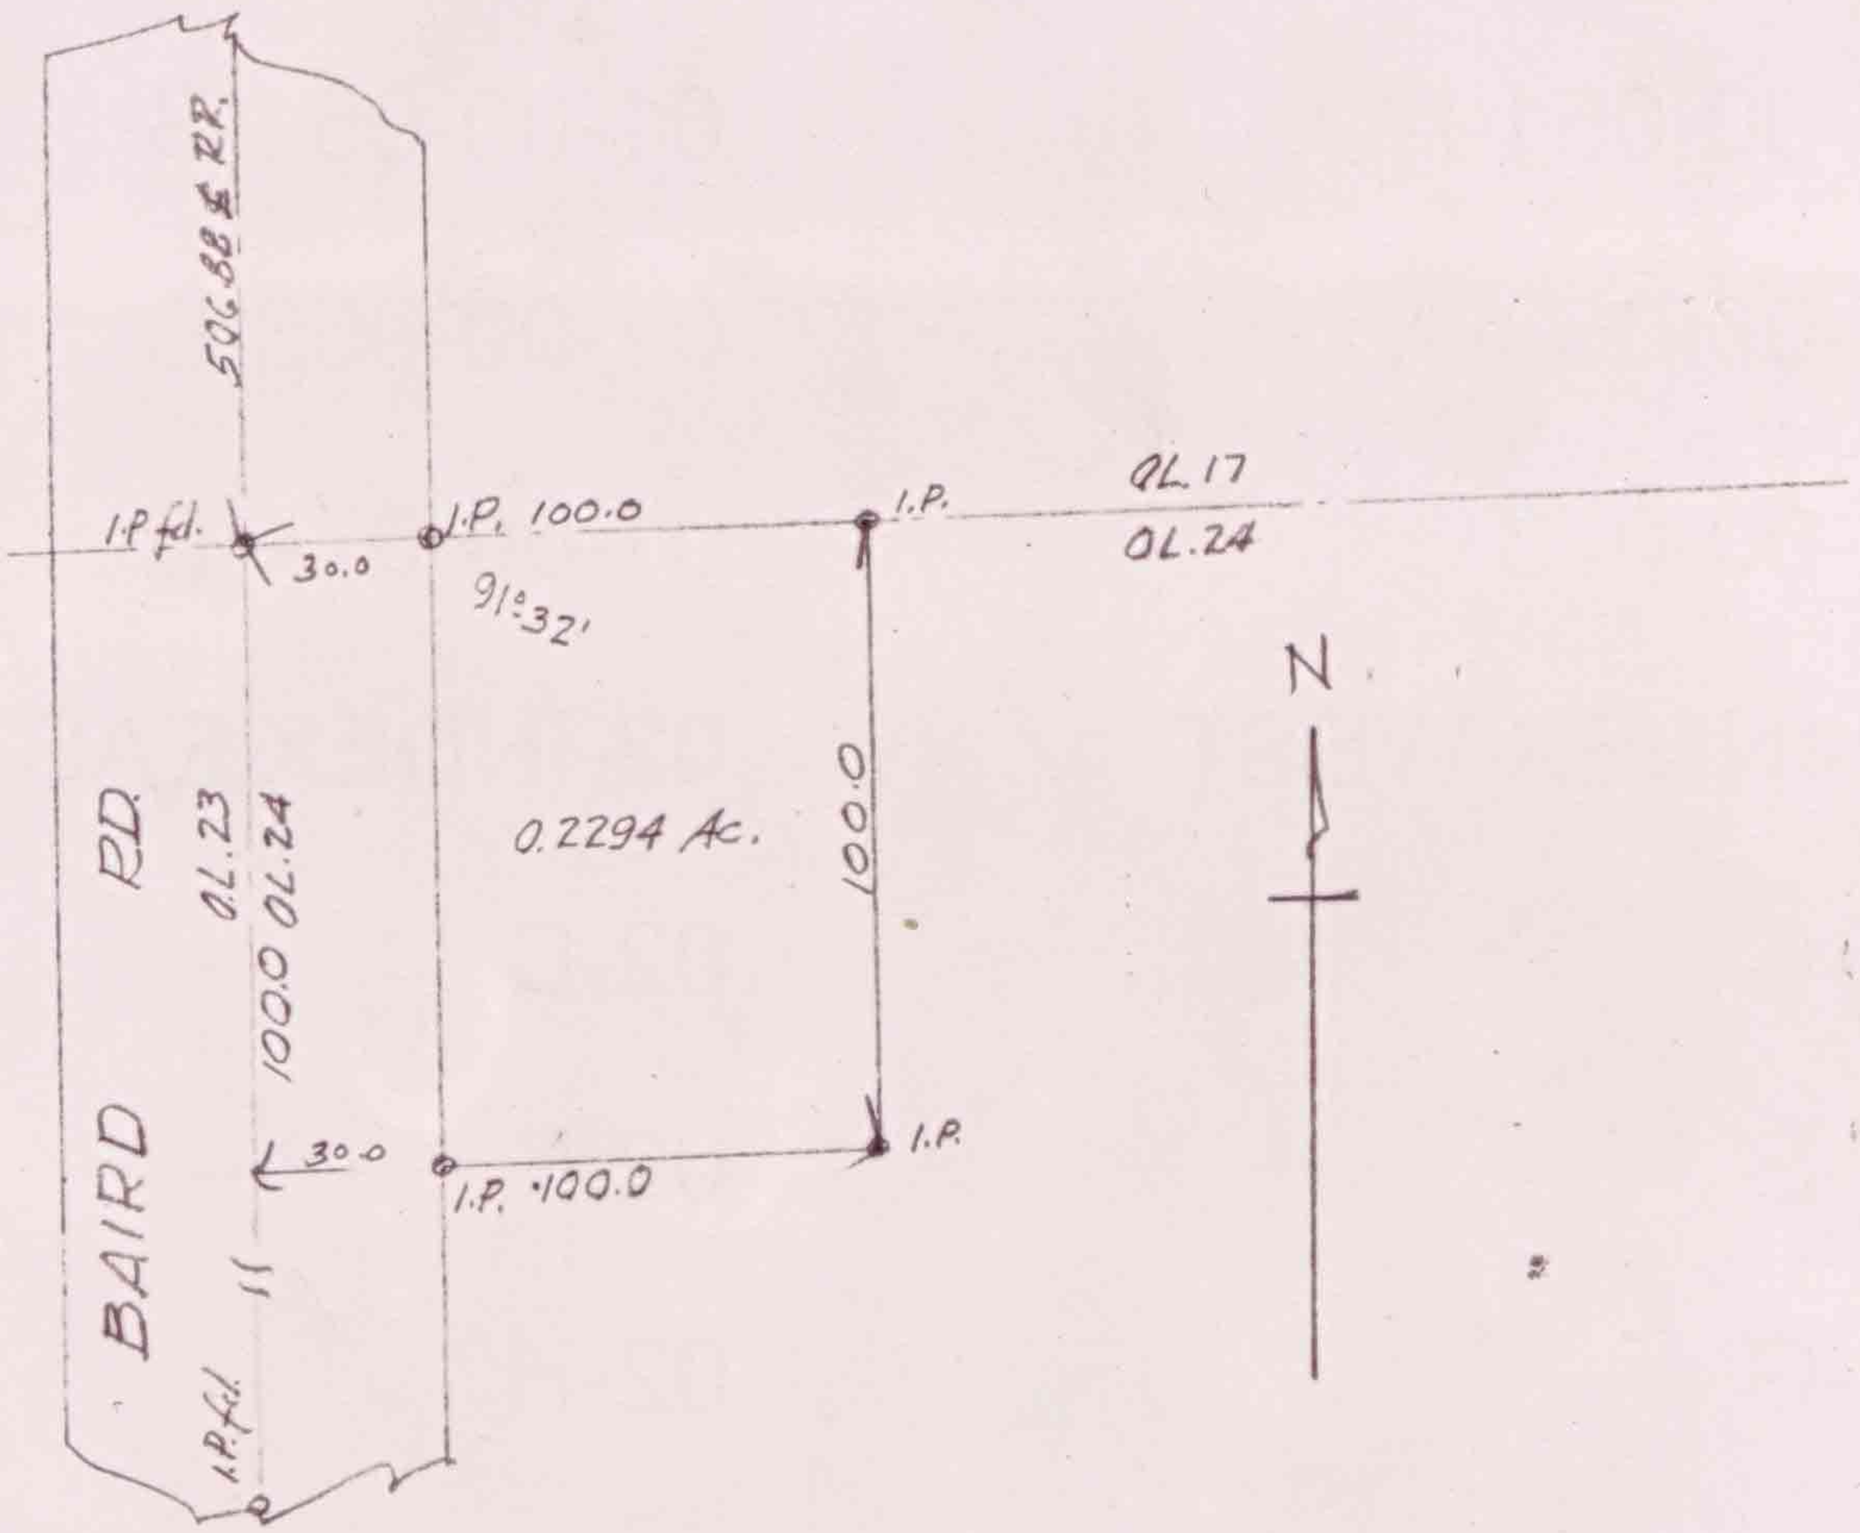

SURVEY FOR STANLEY BOWMAN

PT. OF O.L. 24 TR. 11 CAMDEN TWNP.

LORAIN CO. OHIO. SCALE 1" = 50'

T.W. LAUNDON REGISTERED SURVEYO

SEPT. 28, 1951.