14-00-003-000-008..

14-C

Scan #46806

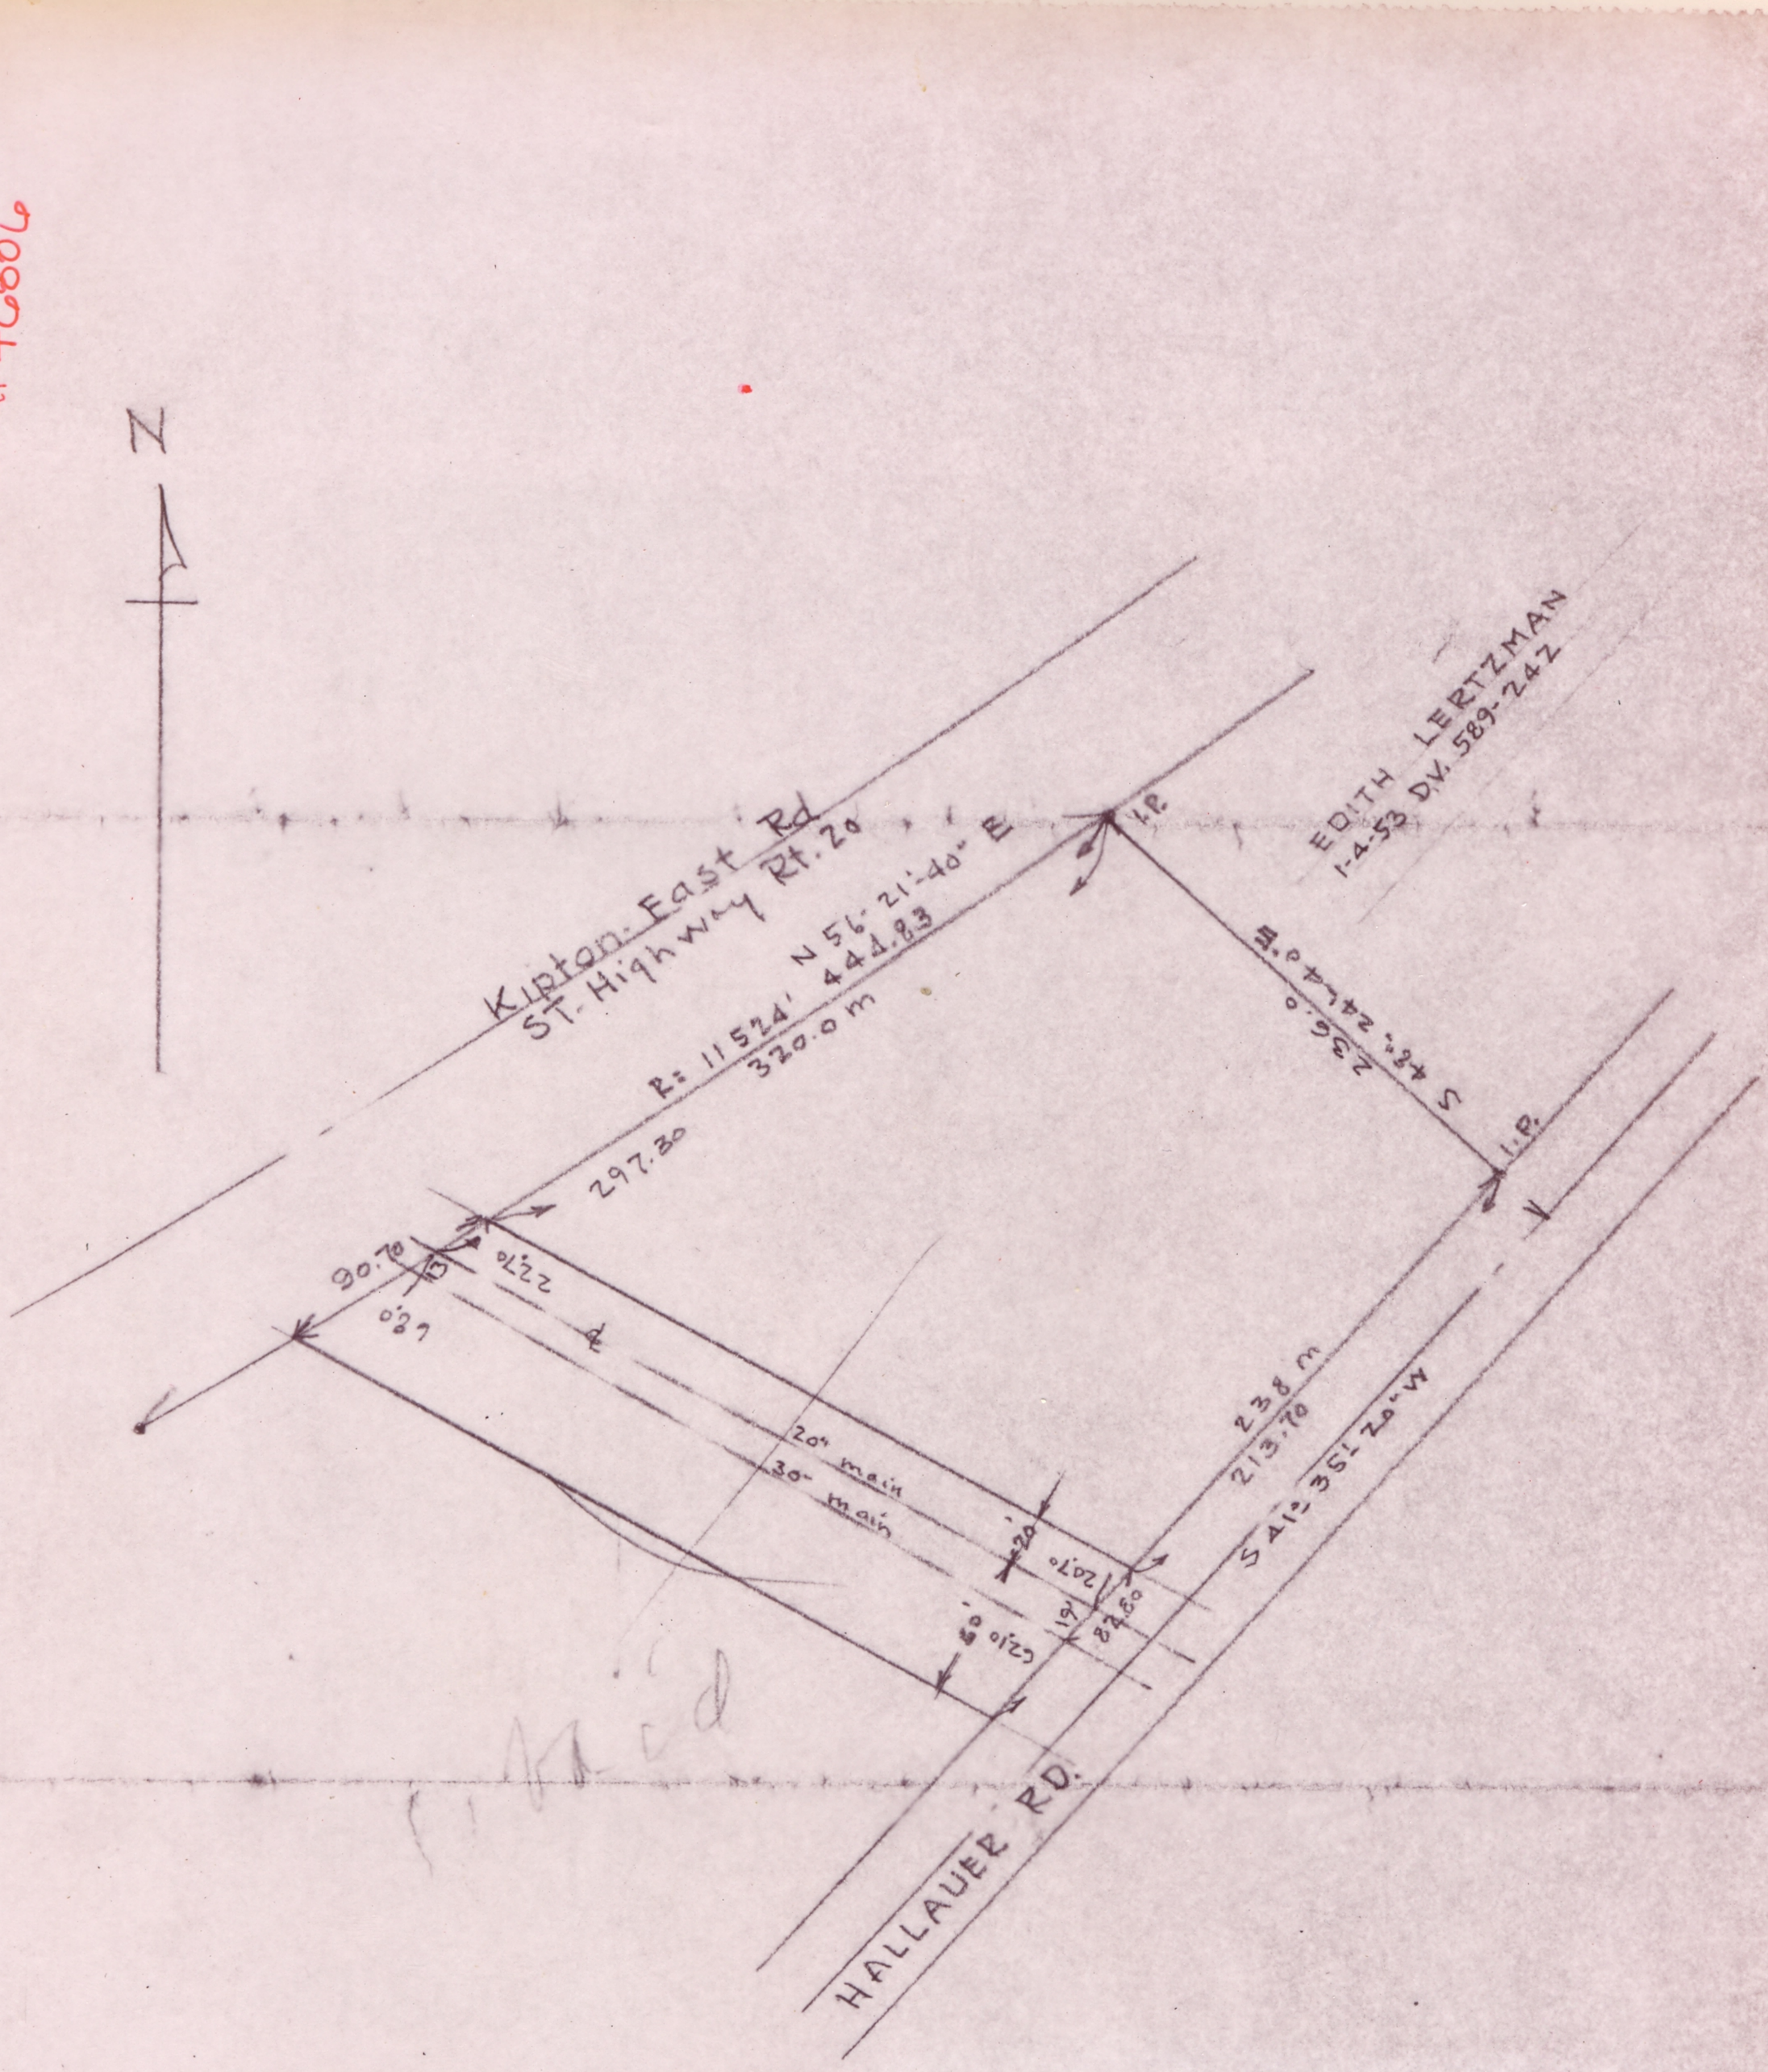

GAS MAINS EAST OHIO GAS CO.
LANDS OF WILLOUGHBY HARRIS
O.L. 3 PITTSFIELD TWP
LORAIN CO. OHIO- SCALE 1"=100'
LAUNDON & HUFFMAN-ENGINEERS
146 MIDDLE AVE ELYRIA OHIO