


Pt. 14-00-014-000-002

14 B

SCAN # 46808

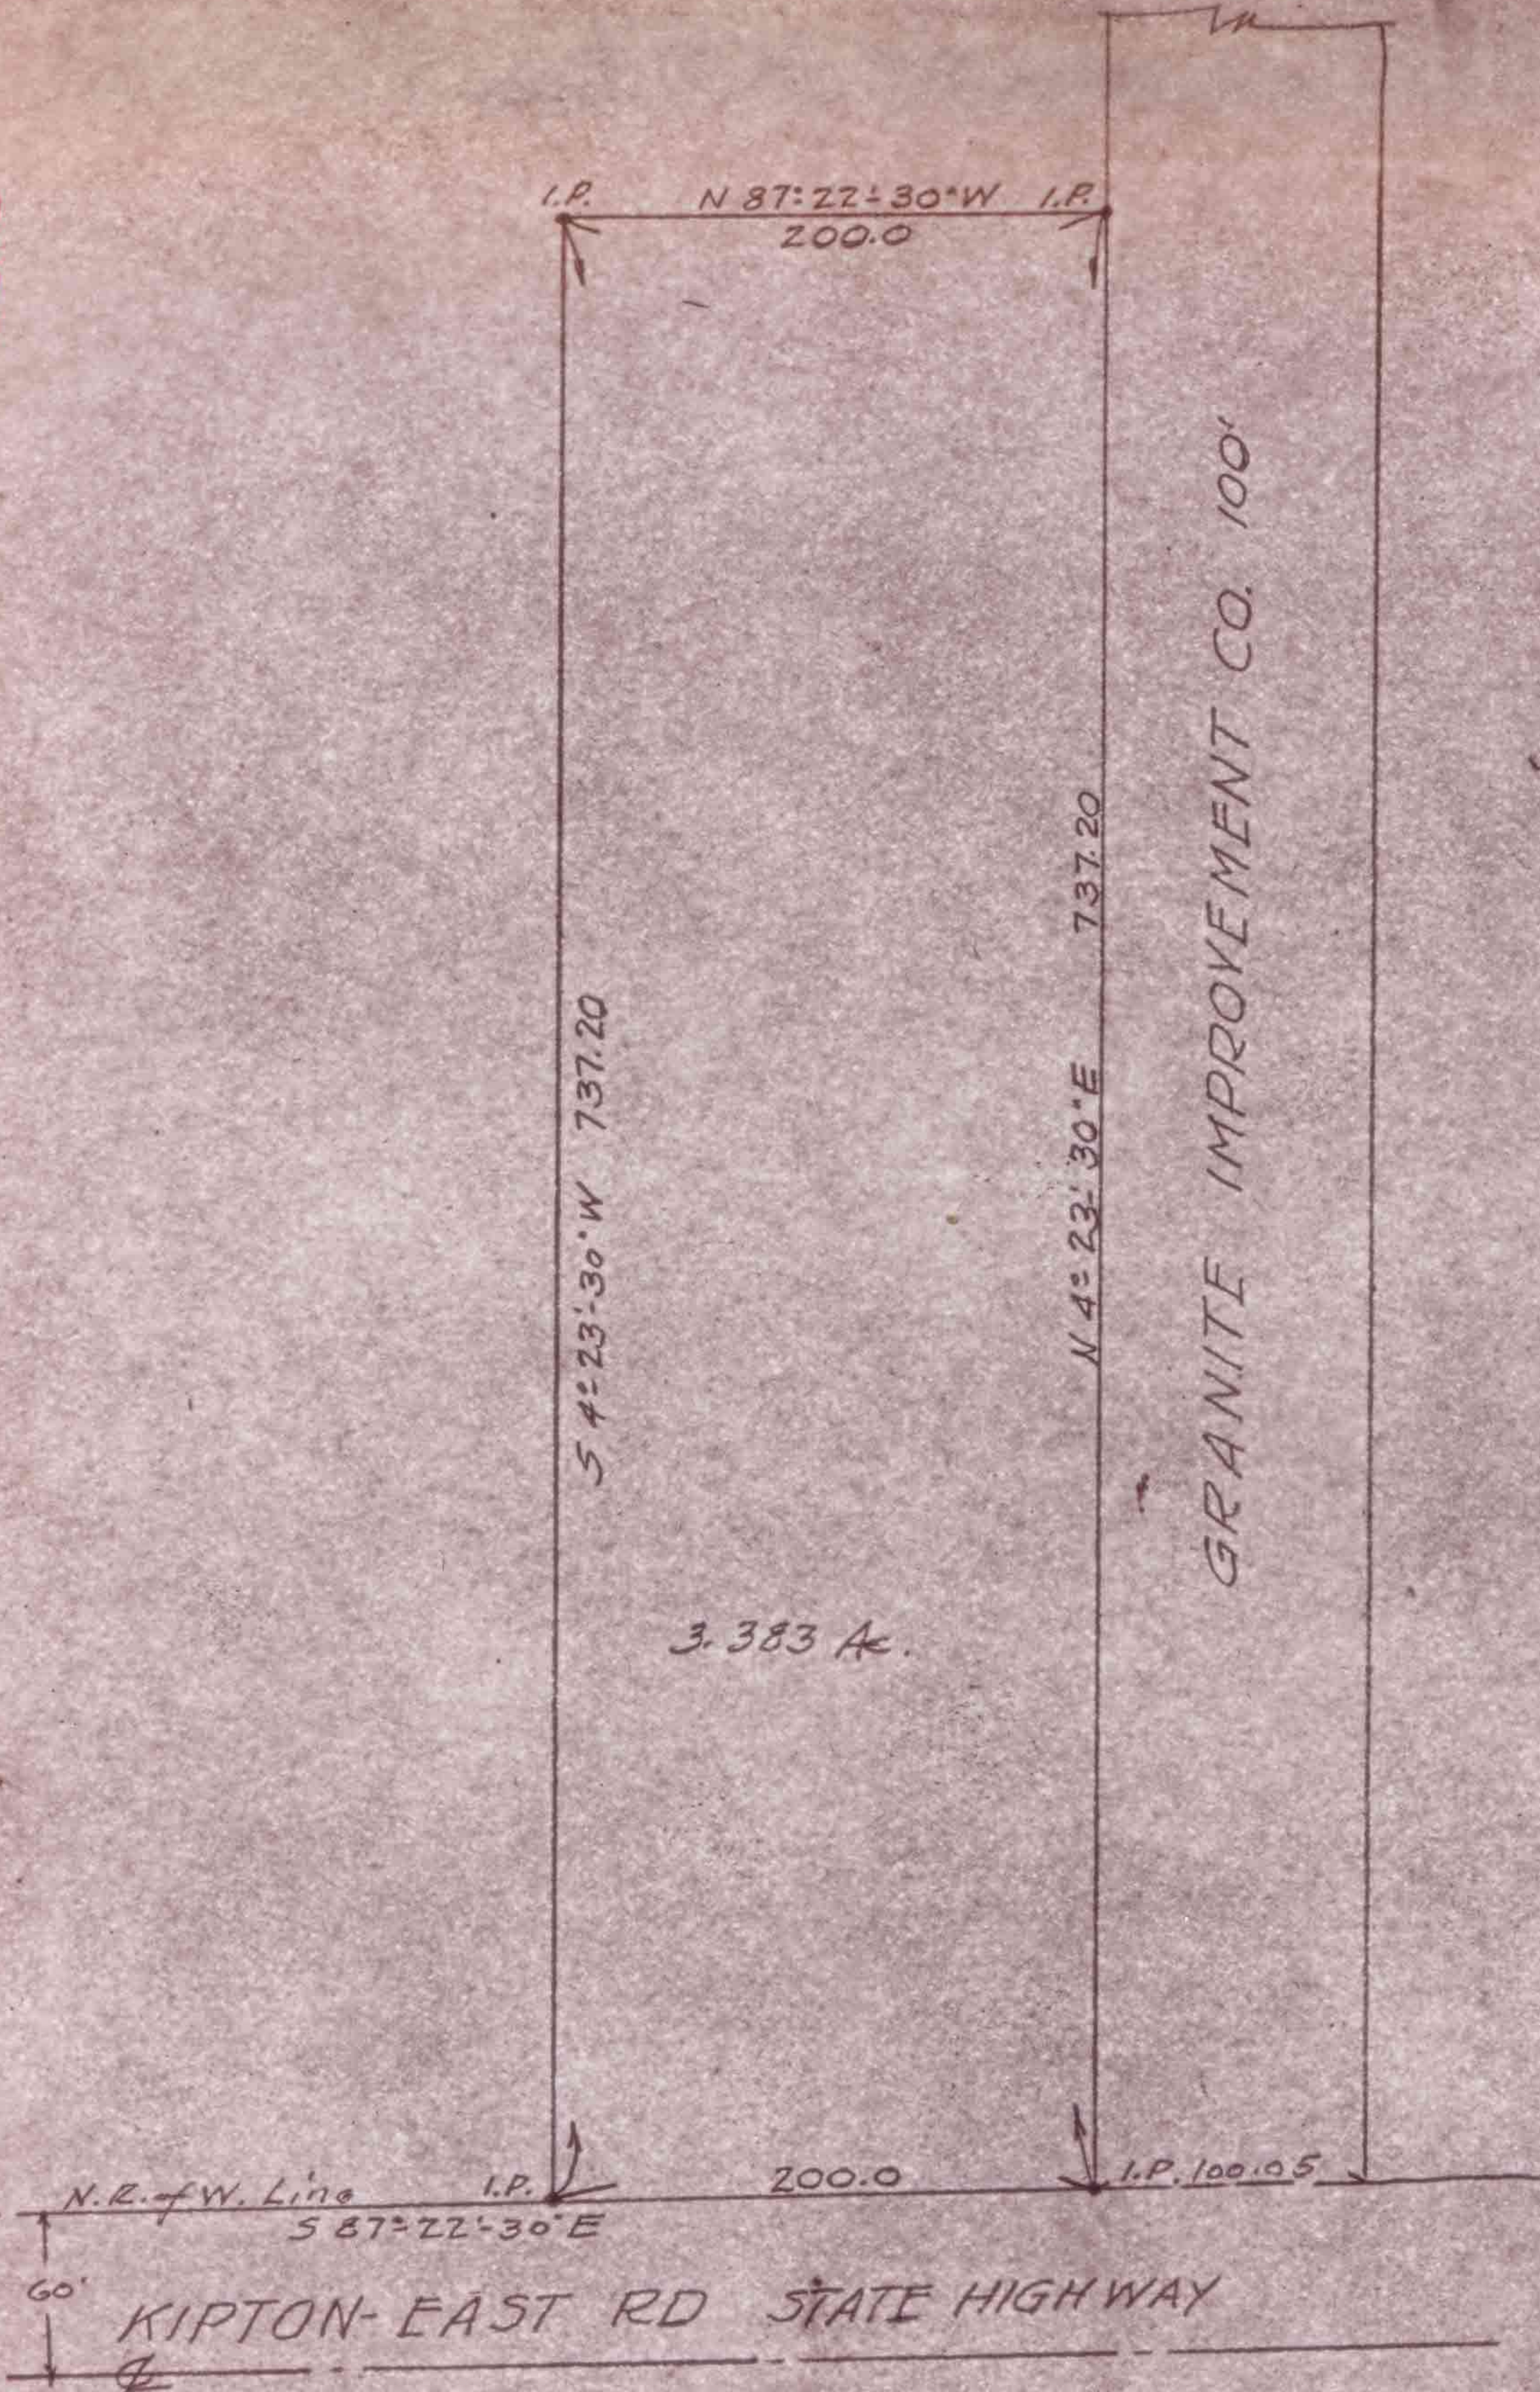

SURVEY FOR MYRON BATES
 PART OF O.L. 14 PITTSFIELD TP LORAIN, CO OHIO
 SCALE 1" = 100' JAN. 31, 1953
 T.W. LAUNDON REG. SURVEYOR #689