


14-00-016-000-009 14-C  
Scan # 46810

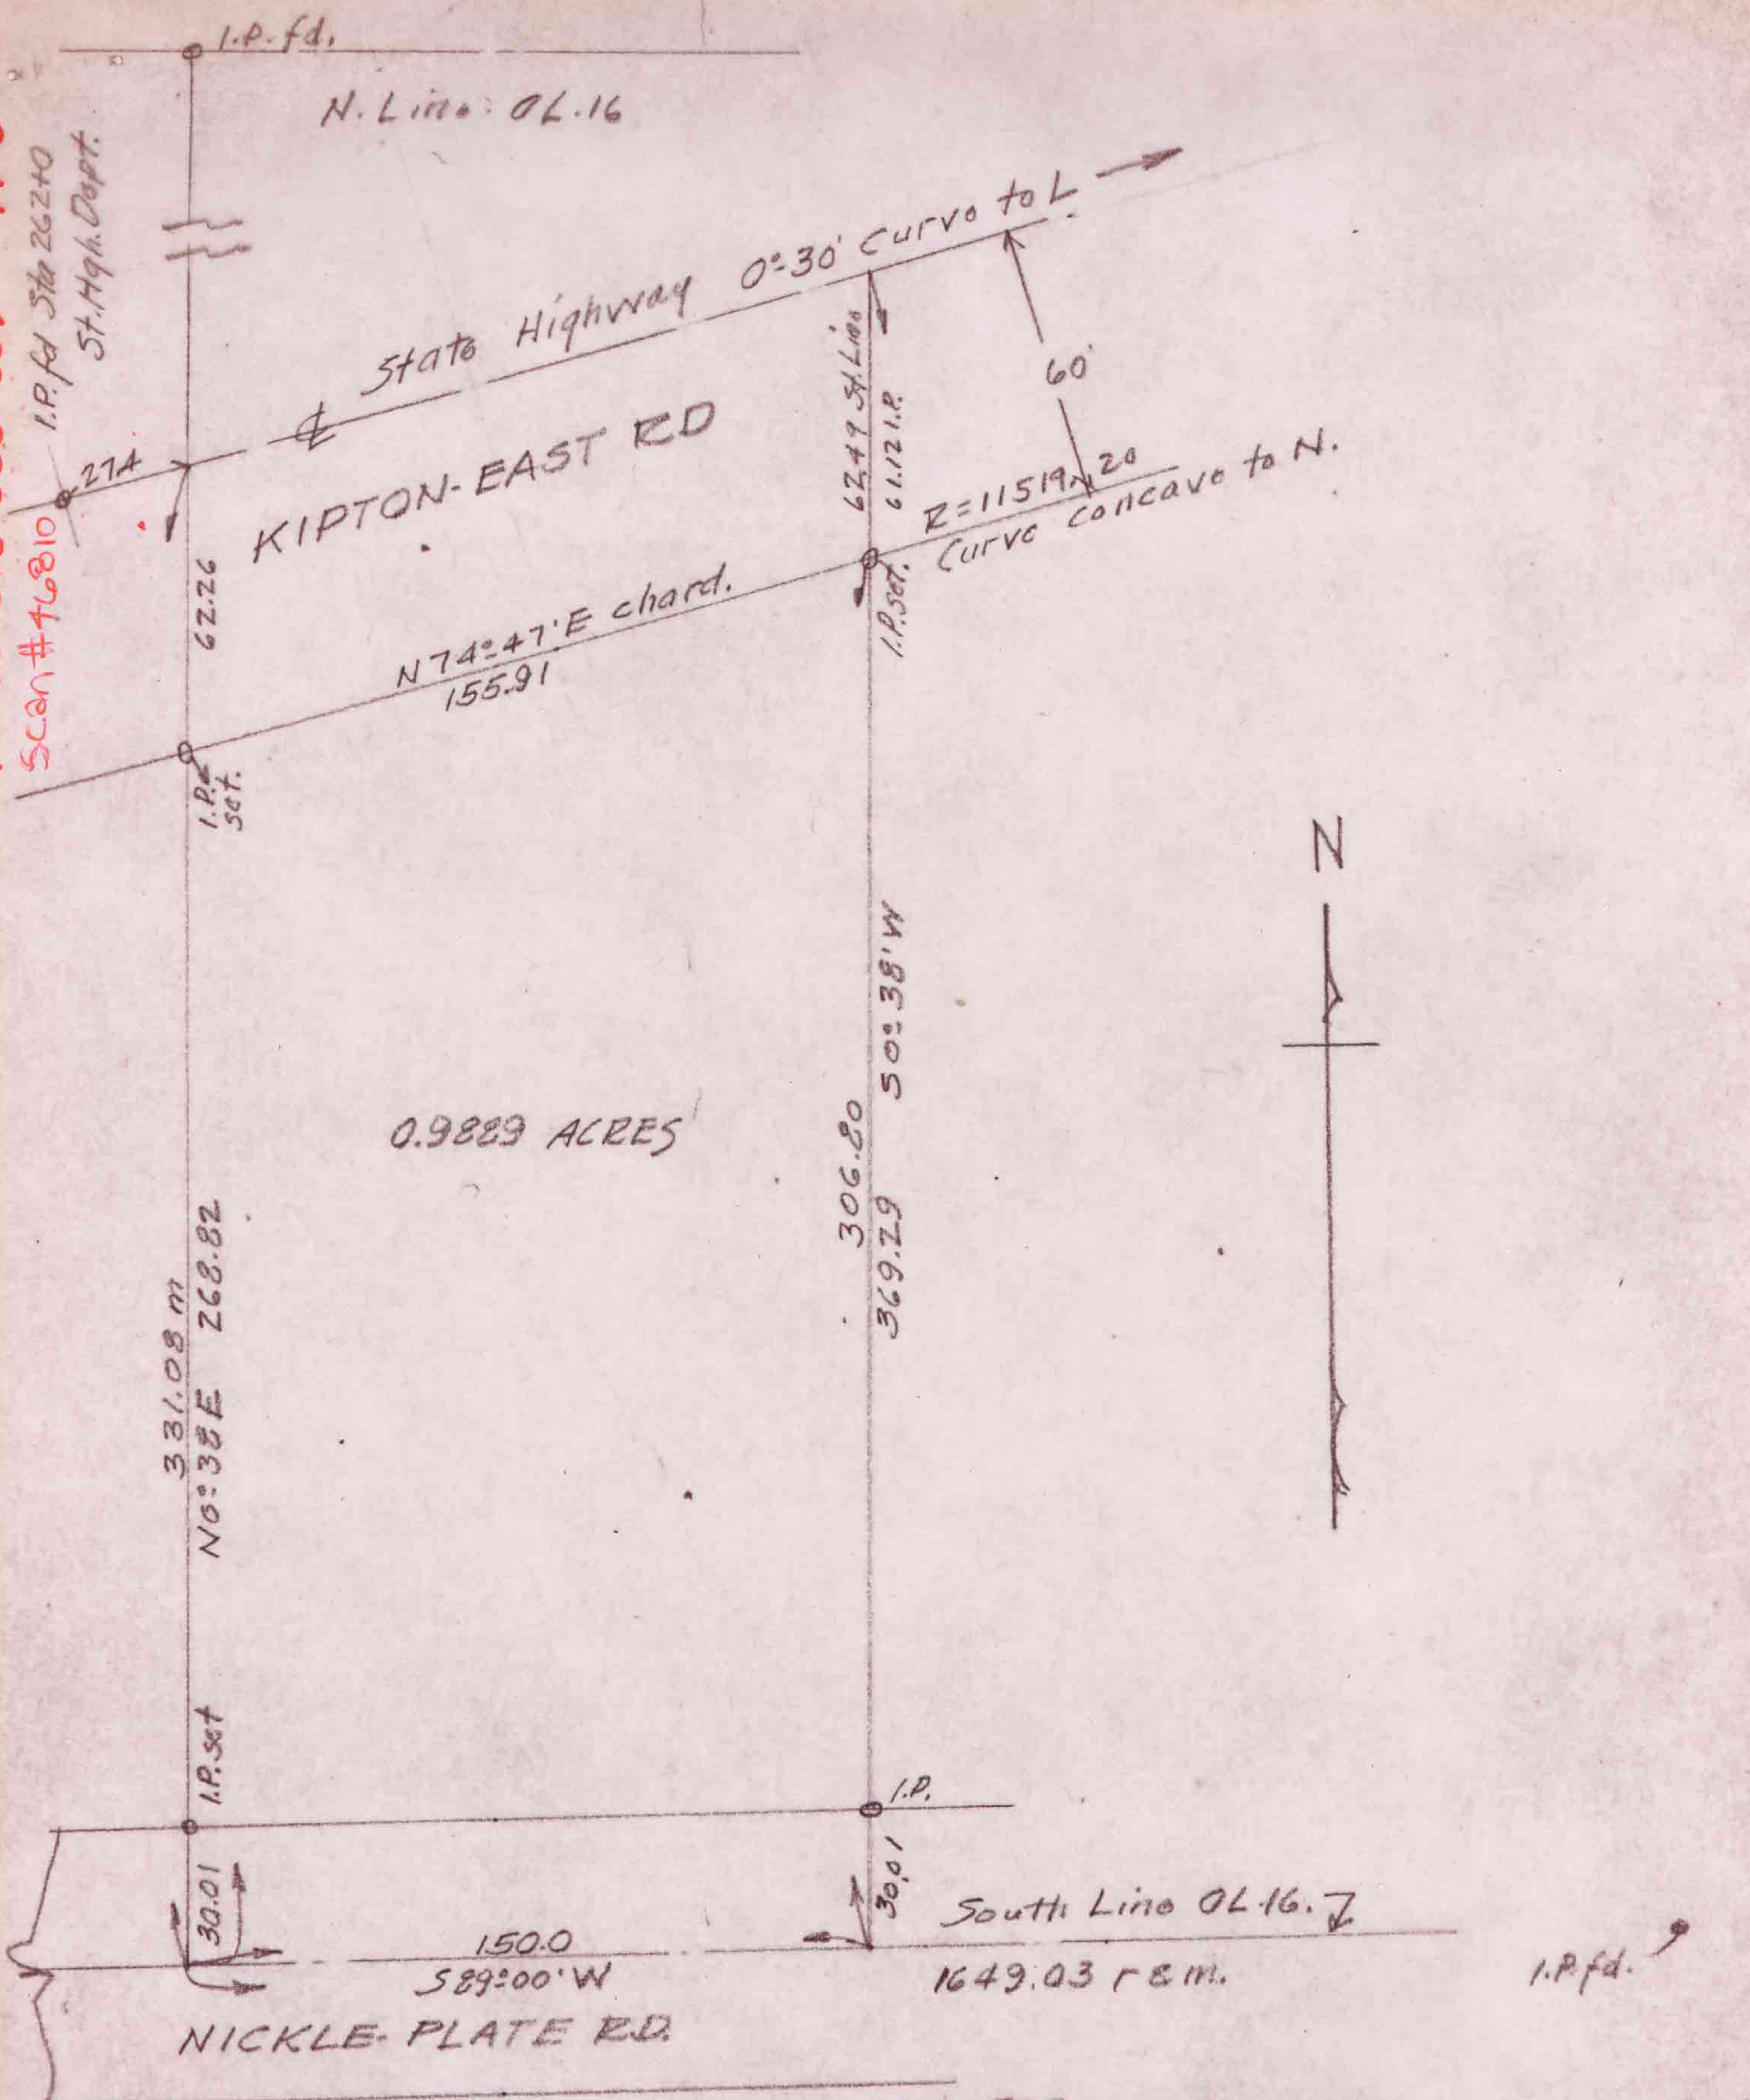

SURVEY FOR  
 PART OF OL.16 PITTSFIELD TR. LORAINCO OHIO  
 SCALE 1"=50'  
 T.W. LAUNDON REG. SURVEYOR.  
 JAN. 16 1951