14-00-016-000-011
14-C
Scan# 45812

LAUNDON - HUFFMAN - SIMON
CIVIL ENGINEERS - SURVEYORS
~~200 Robinson Building Annex~~
~~401 W.~~ 517 Broad St. Elyria, Ohio

Thomas W. Laundon, P.E.
David C. Huffman, P.E.
Rodger G. Simon, R.S.

Municipal Engineering
Subdivisions
Land Surveys

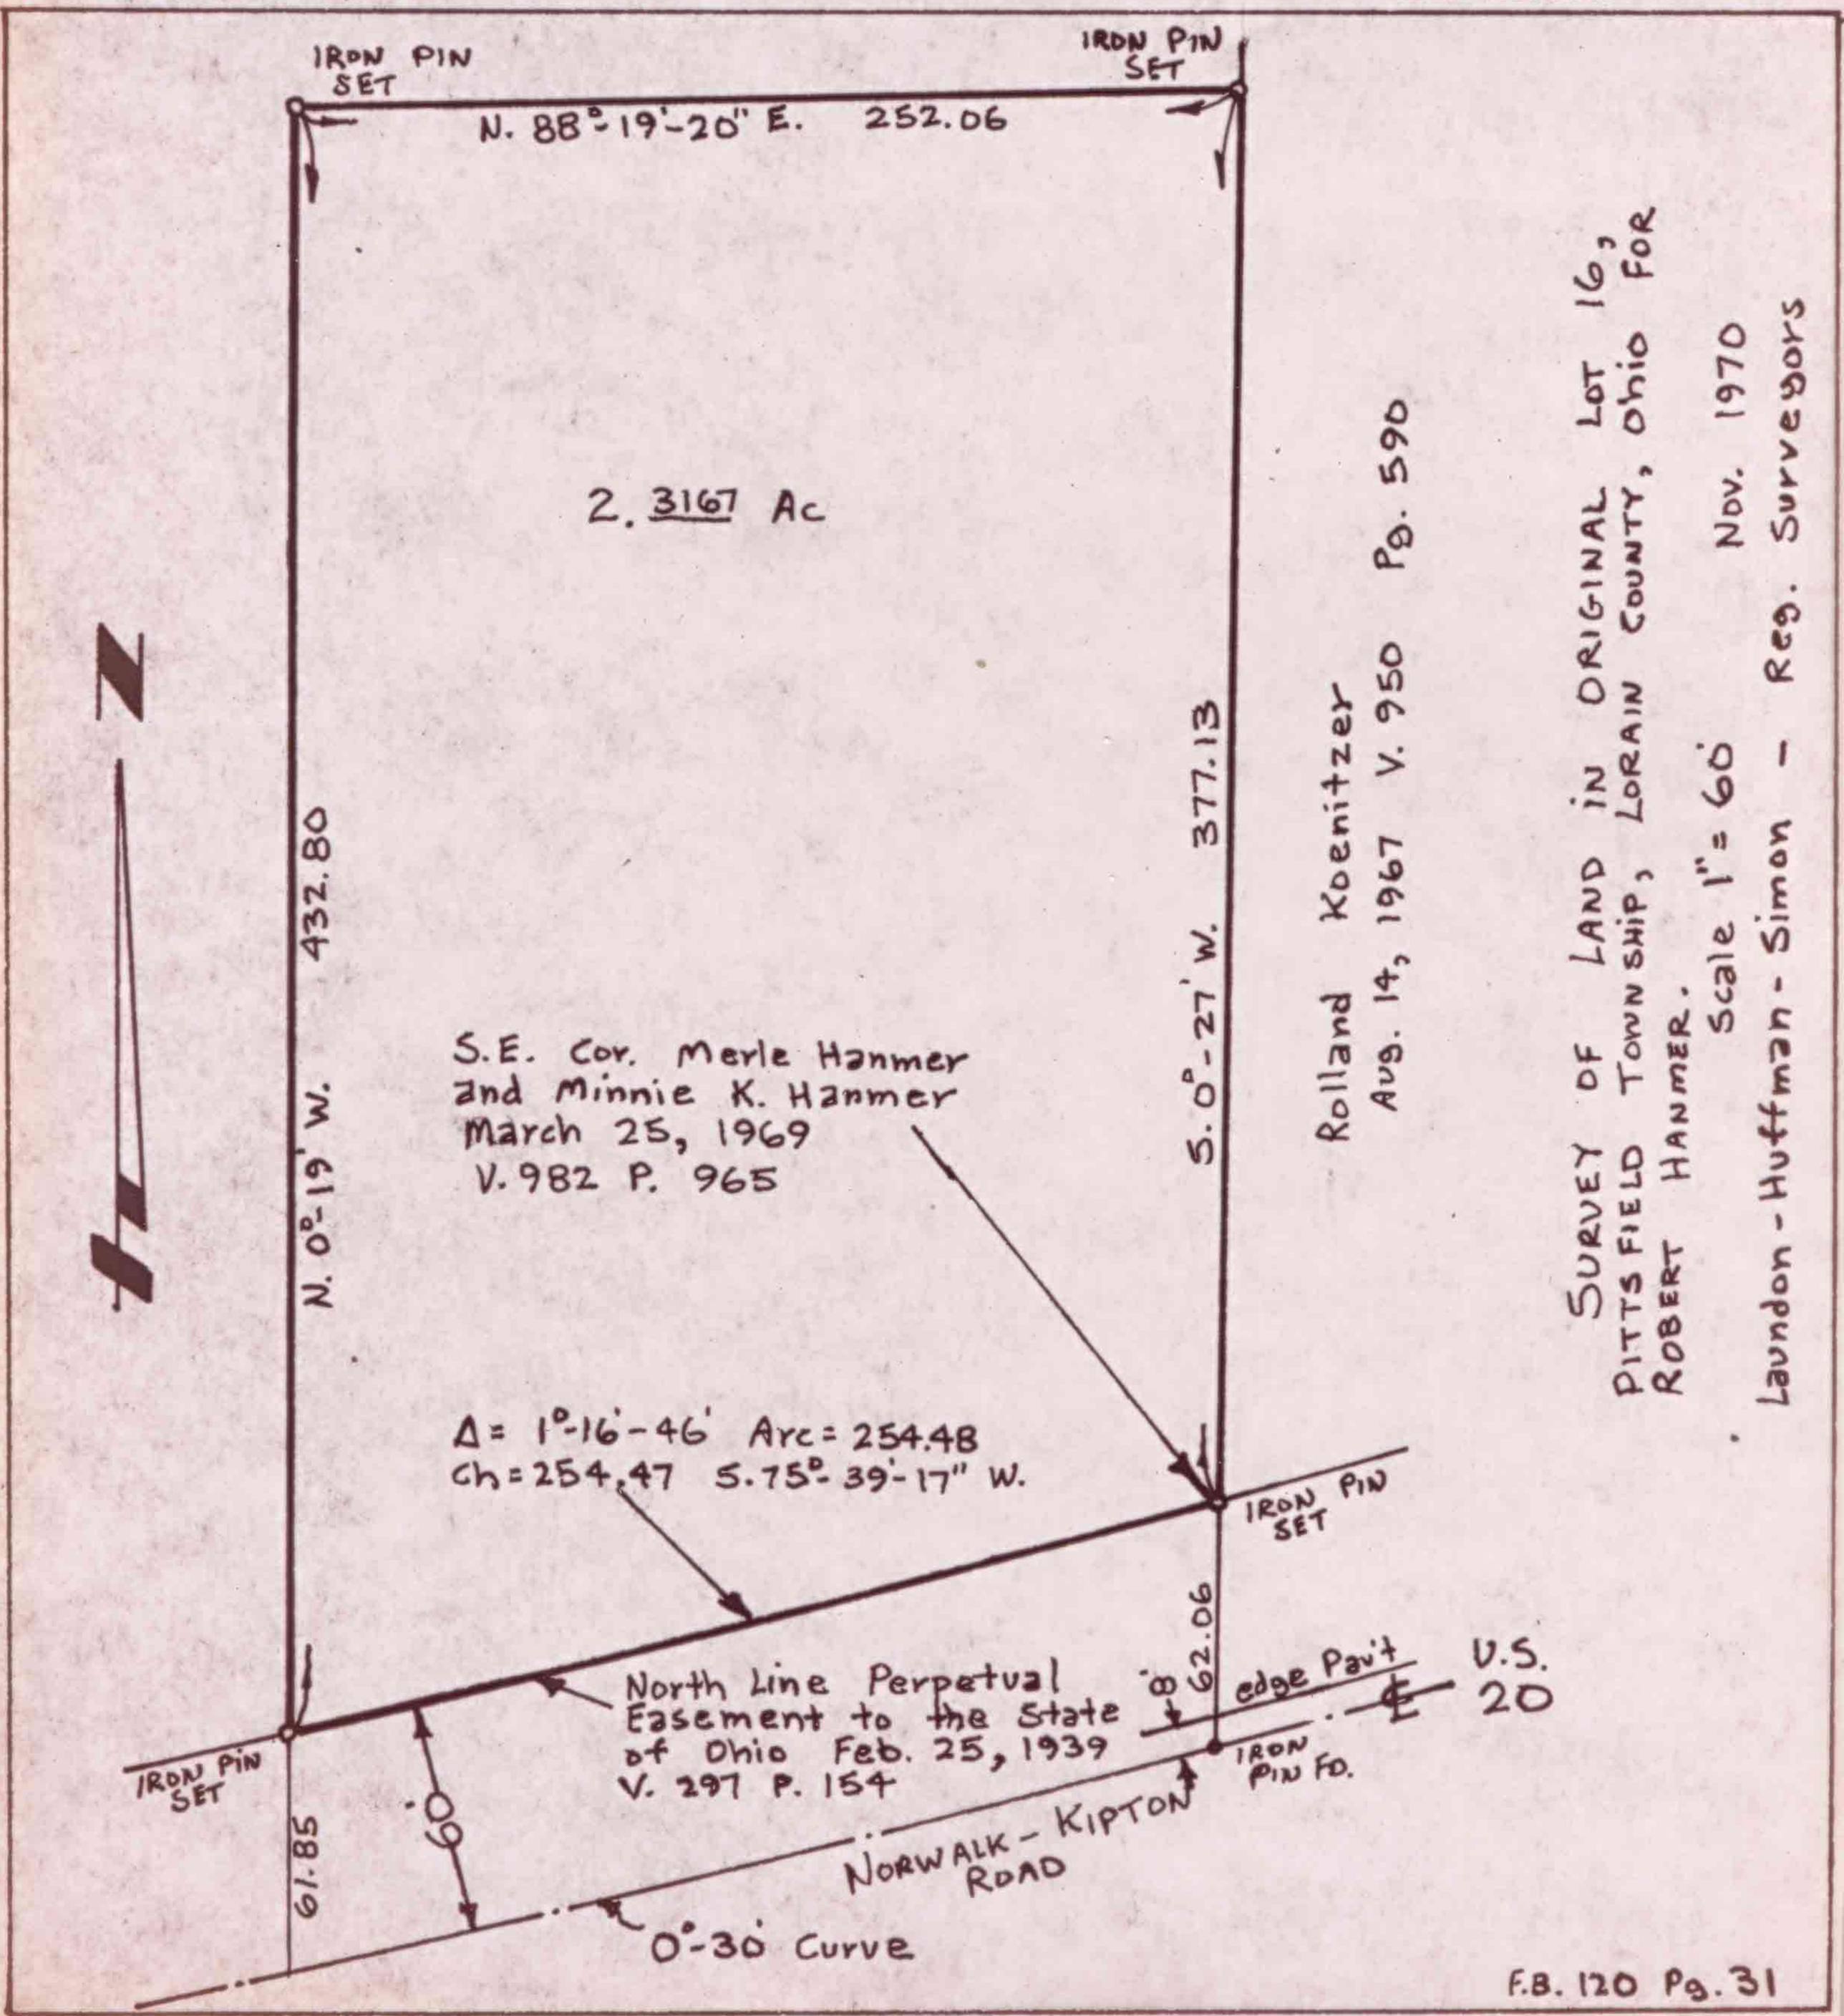

F.B. 120 Pg. 31