


14-00-076-000-003

TAX MAP 14C SCAN # 46823

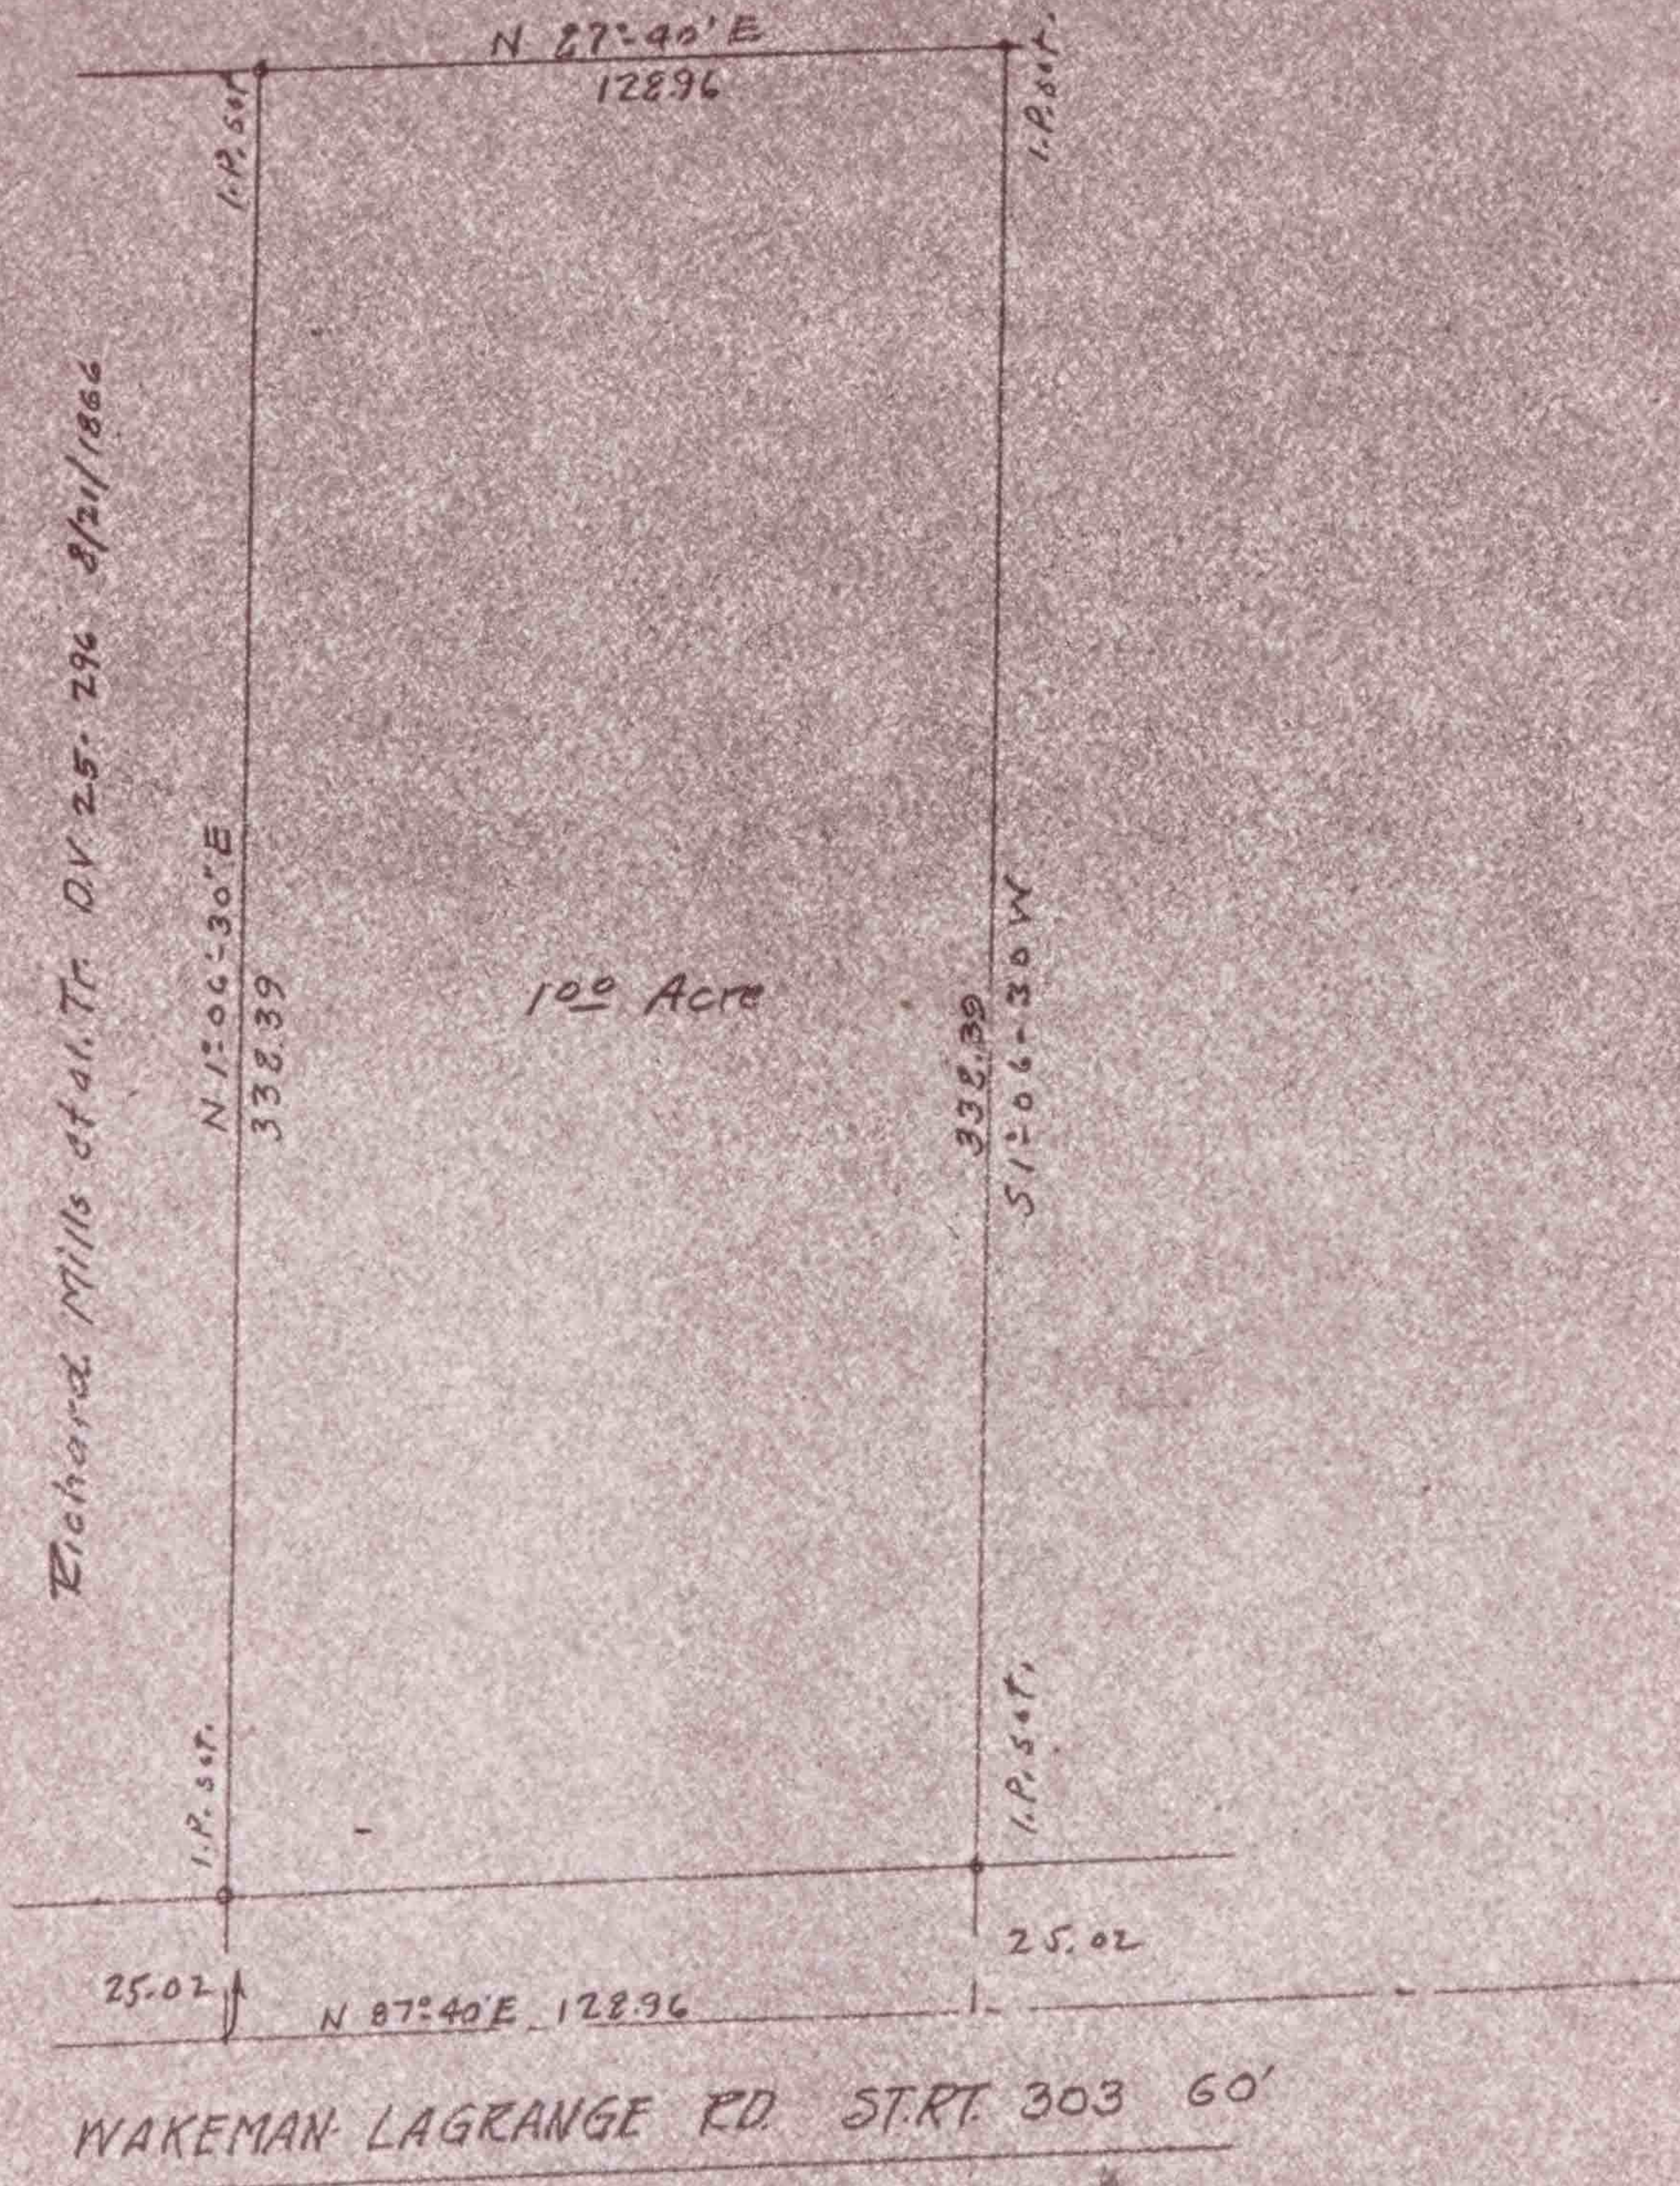

SURVEY FOR
 CARL C. & CATHERINE C. DEWEY
 PART OF ORIG. LOT 76 OF
 PITTSFIELD TR. LORAIN CO. OHIO
 SCALE 1"=50' OCT. 26, 1961
 LAUNDON & HUFFMAN
 REG. SURVEYORS.