14-00-082-000-004
14-H
SCAN #468824

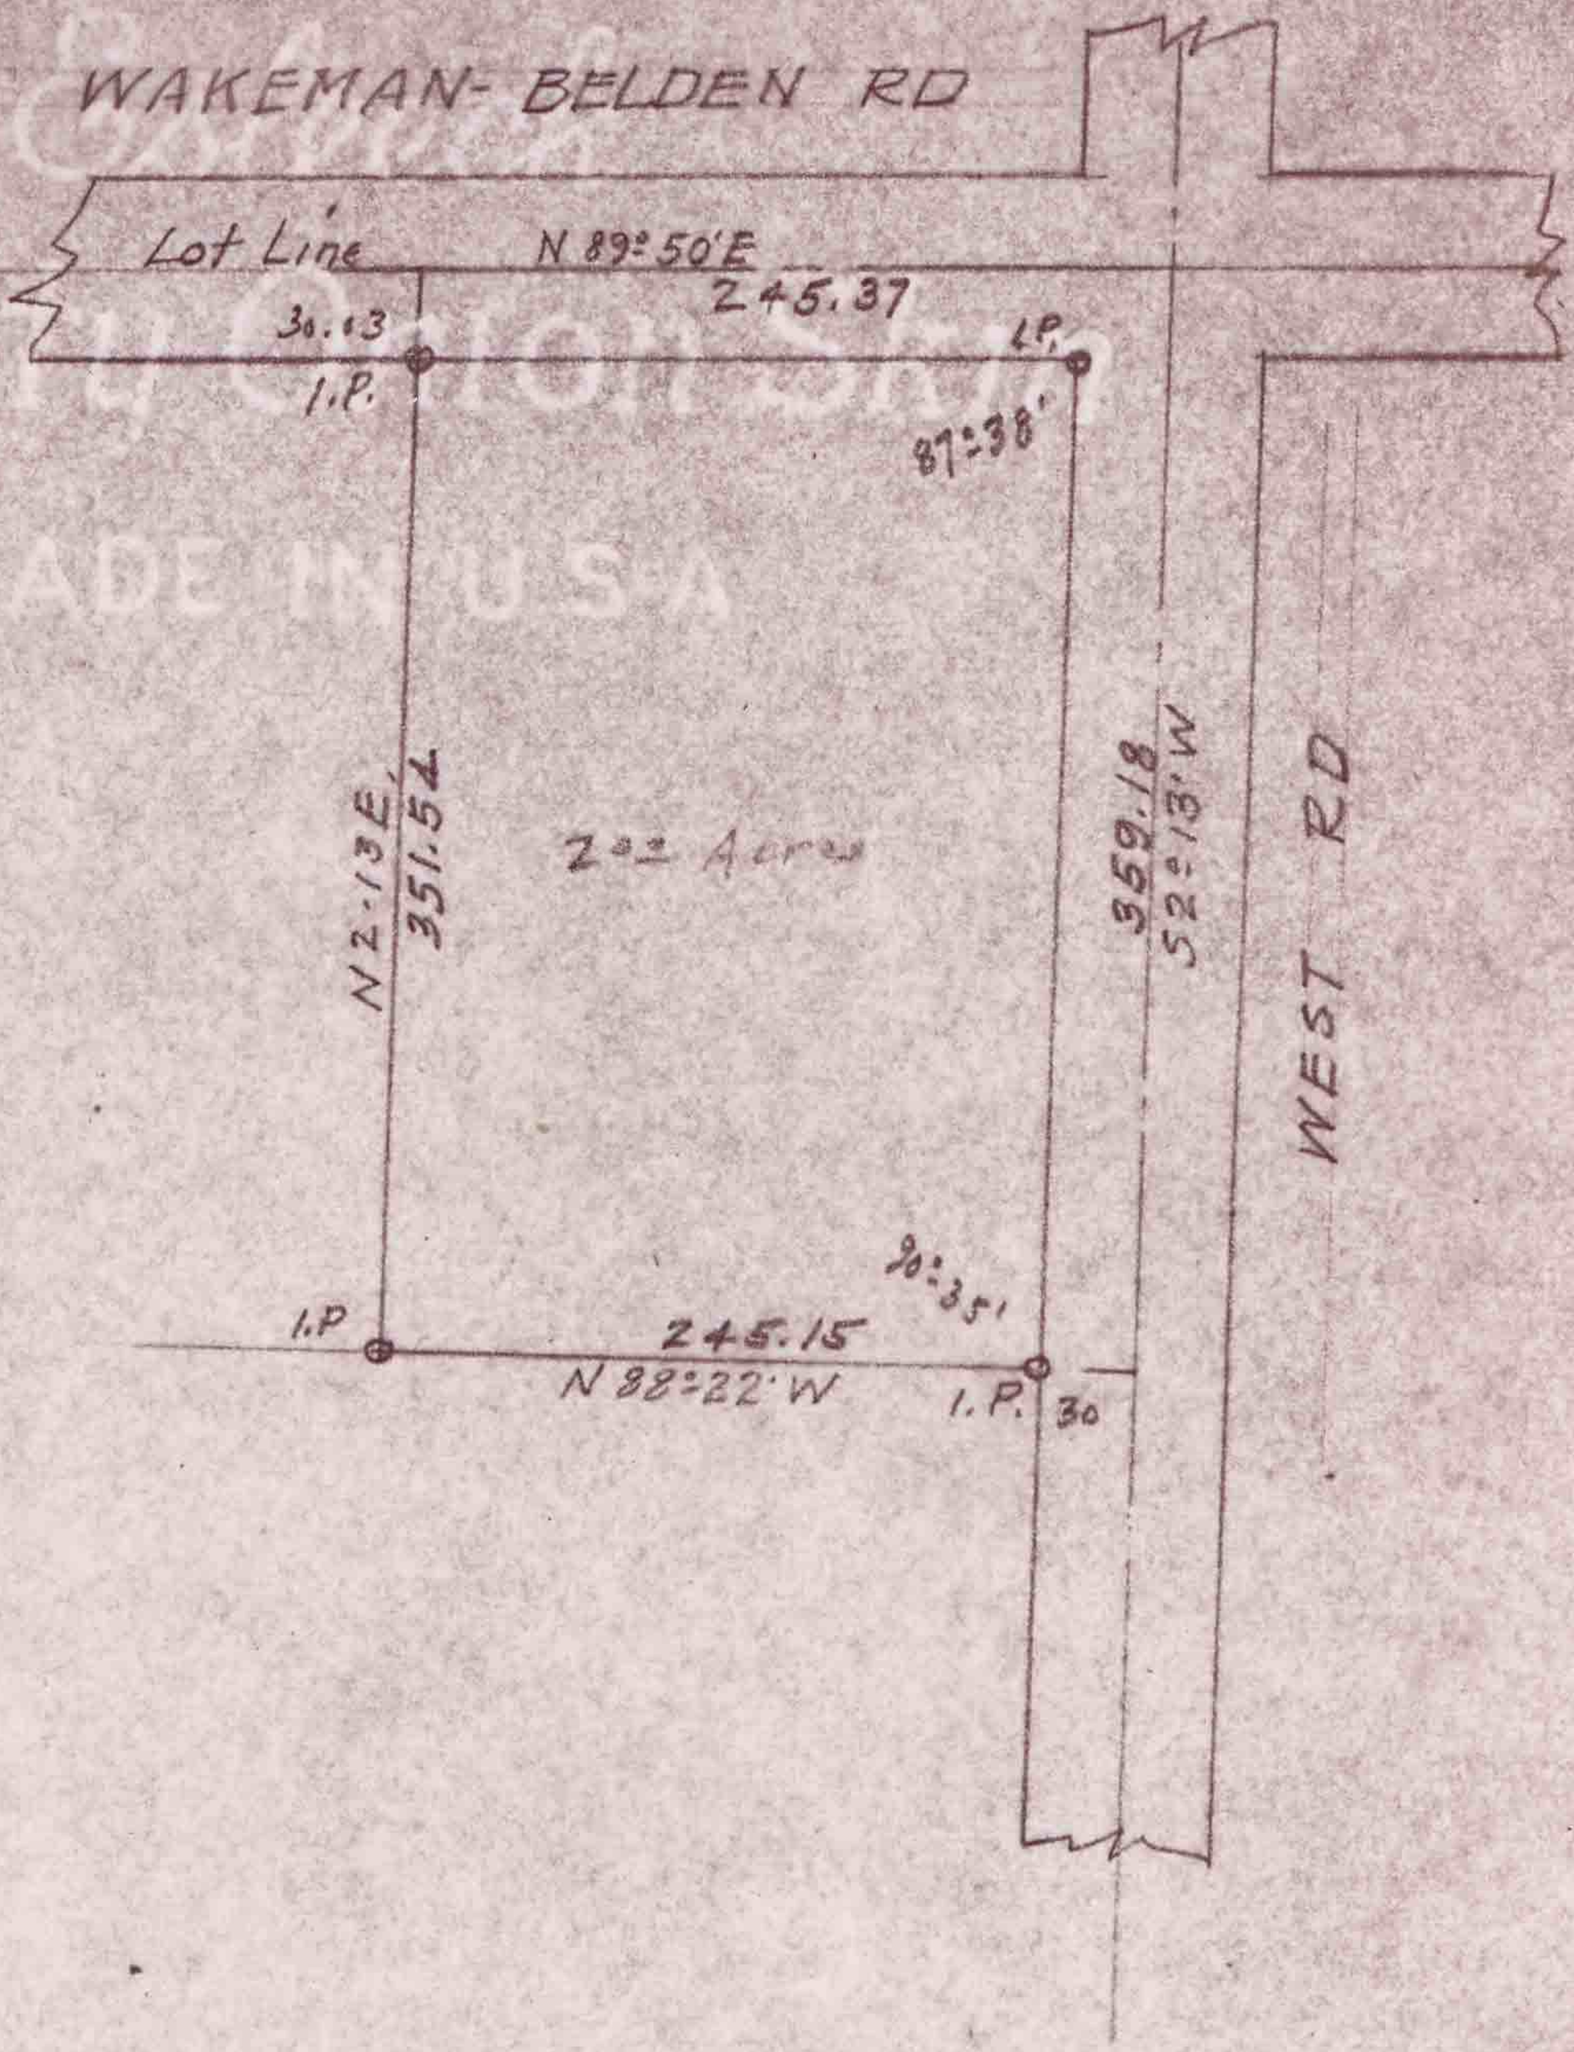

SURVEY FOR HERBERT PYCRAFT

WM EZRA MULL FARM

PART OF ORIG. LOT 82 PITTSFIELD TP

LORAIN CO. OHIO SCALE 1"=100'

T.W. LAUNDON REG. SURVEYOR.