
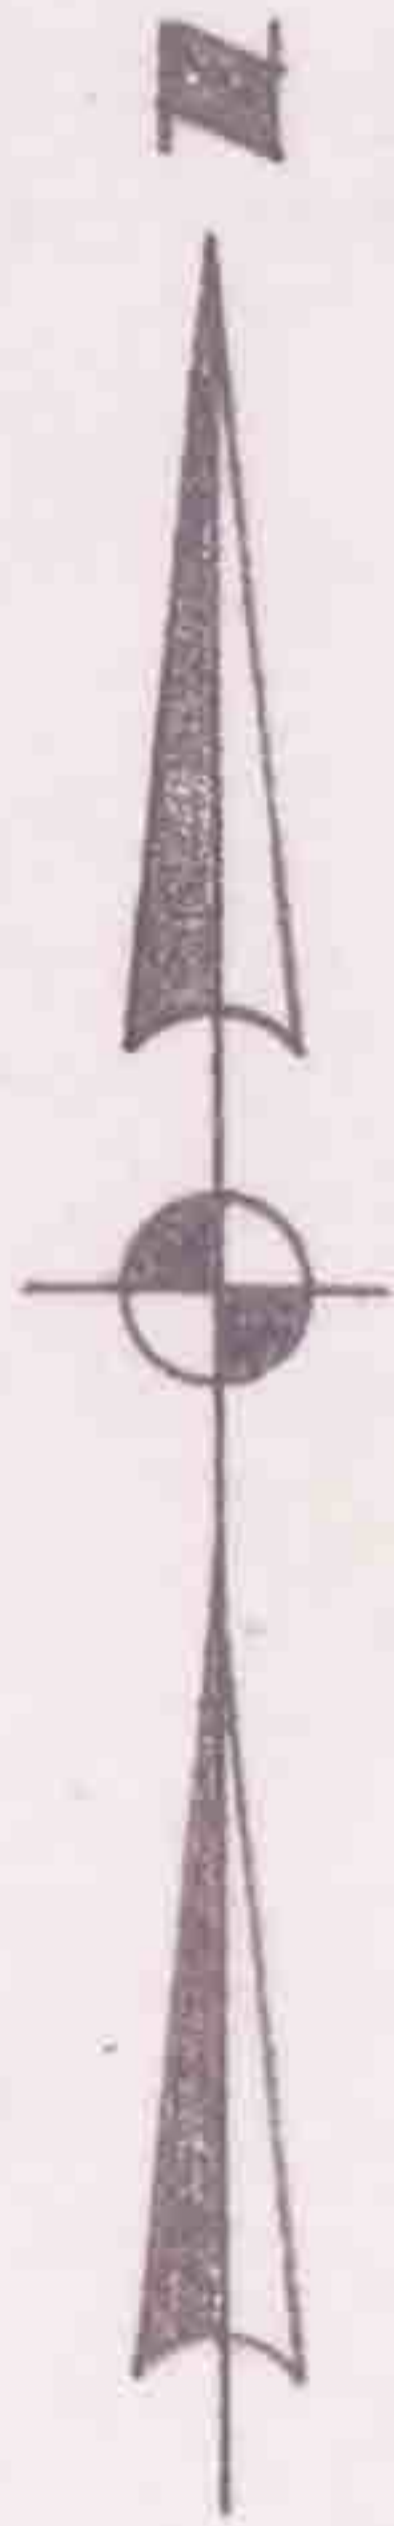


14-00-088-000-010

14-F
SCAN.# 46828

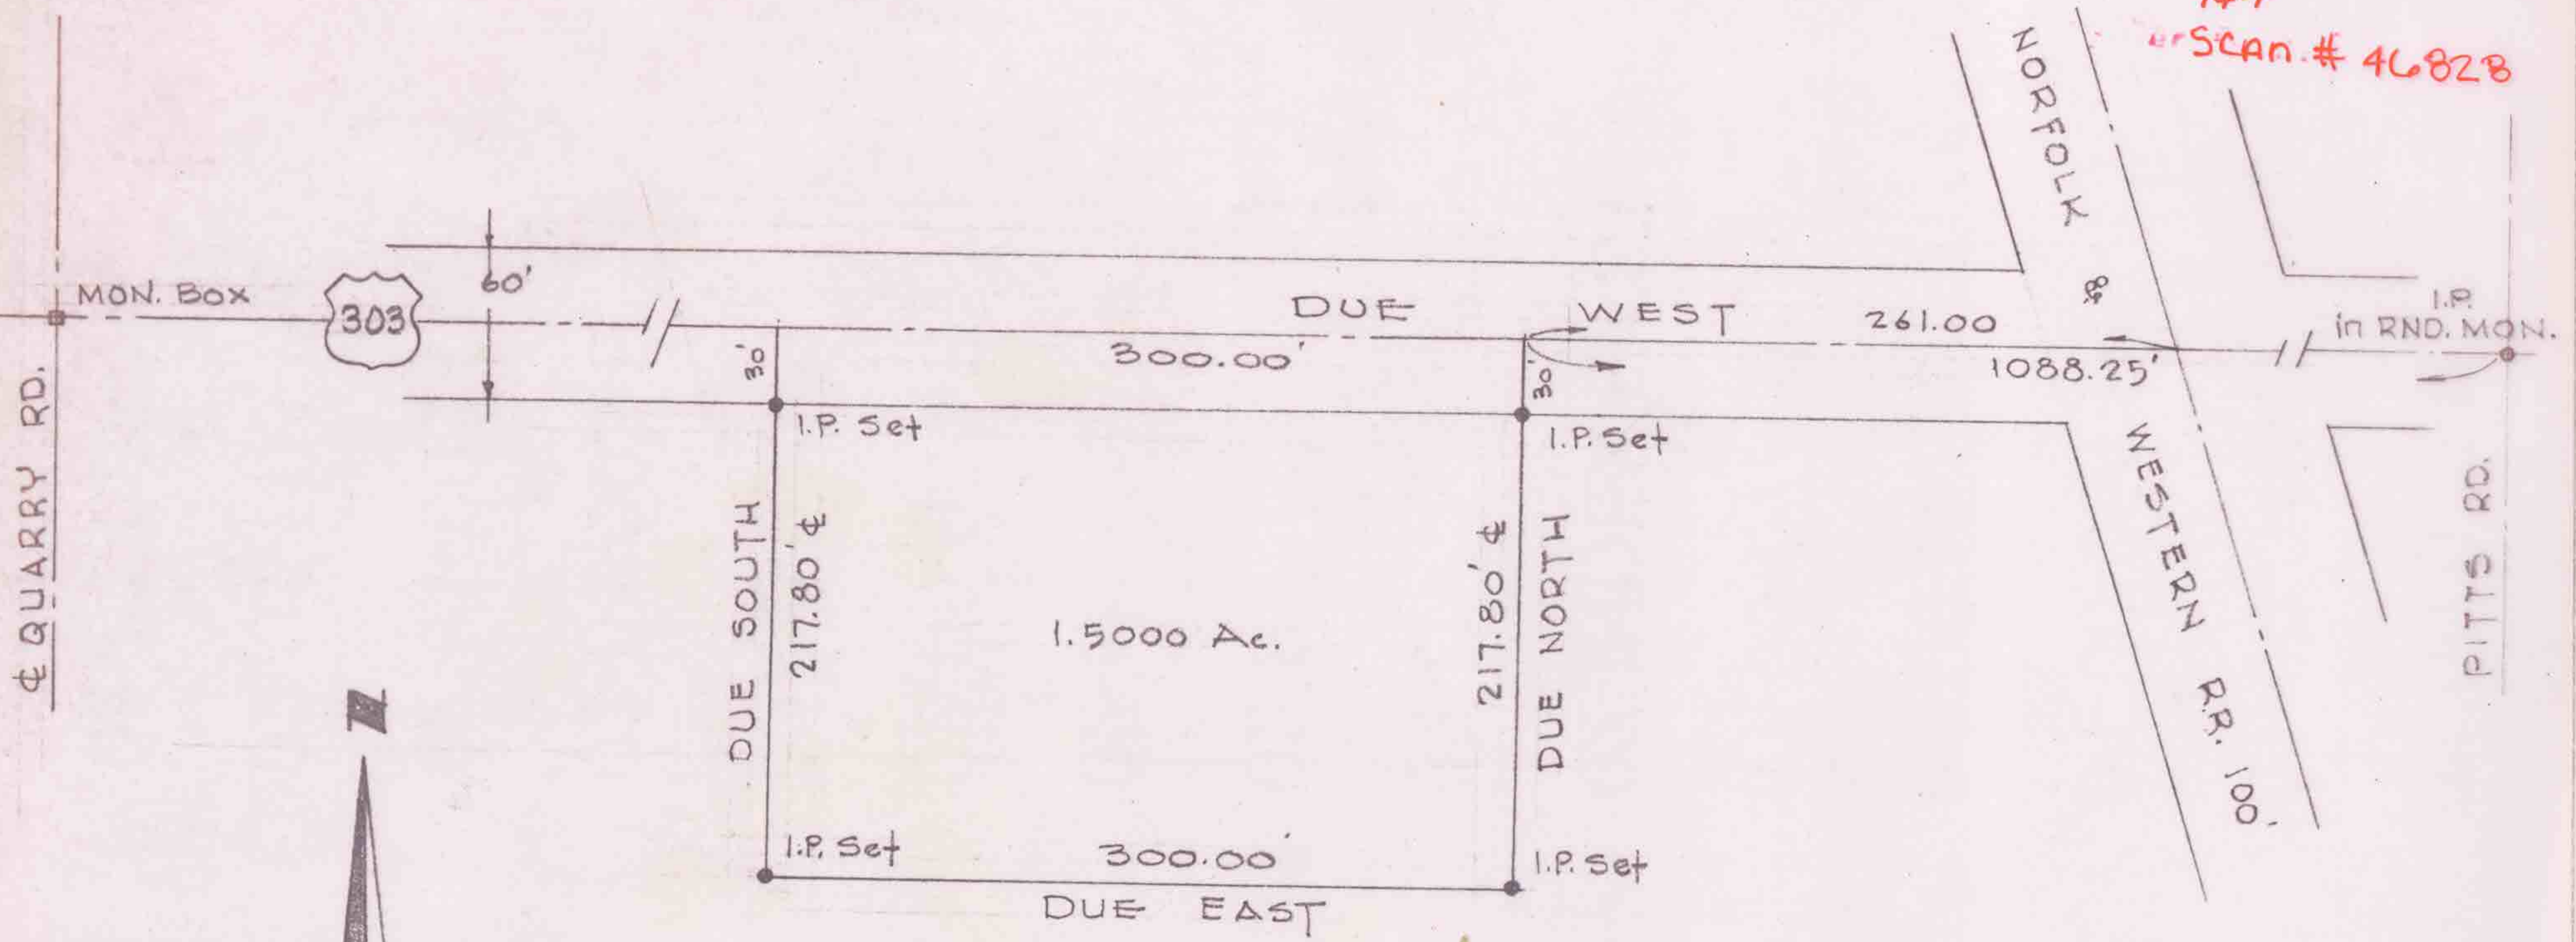

SURVEY FOR
LLOYD MULL

O.L. 88 PITTSFIELD TWP., LORAIN CO., OHIO
 SCALE 1"=100' MAY, 1976
 LAUNDON • SIMON • CAHL & ASSOC.
 ENGINEERS SURVEYORS

BEARINGS SHOWN ARE ASSUMED
 AND USED TO DESCRIBE ANGLES ONLY

Job No. 76-496
 FB-193-30