


15-00-027-000-023

15-C

SCAN # 46841



CARLTON F. & RHODA A. SAYERS
4-5-46 D.V. 387 P. 229

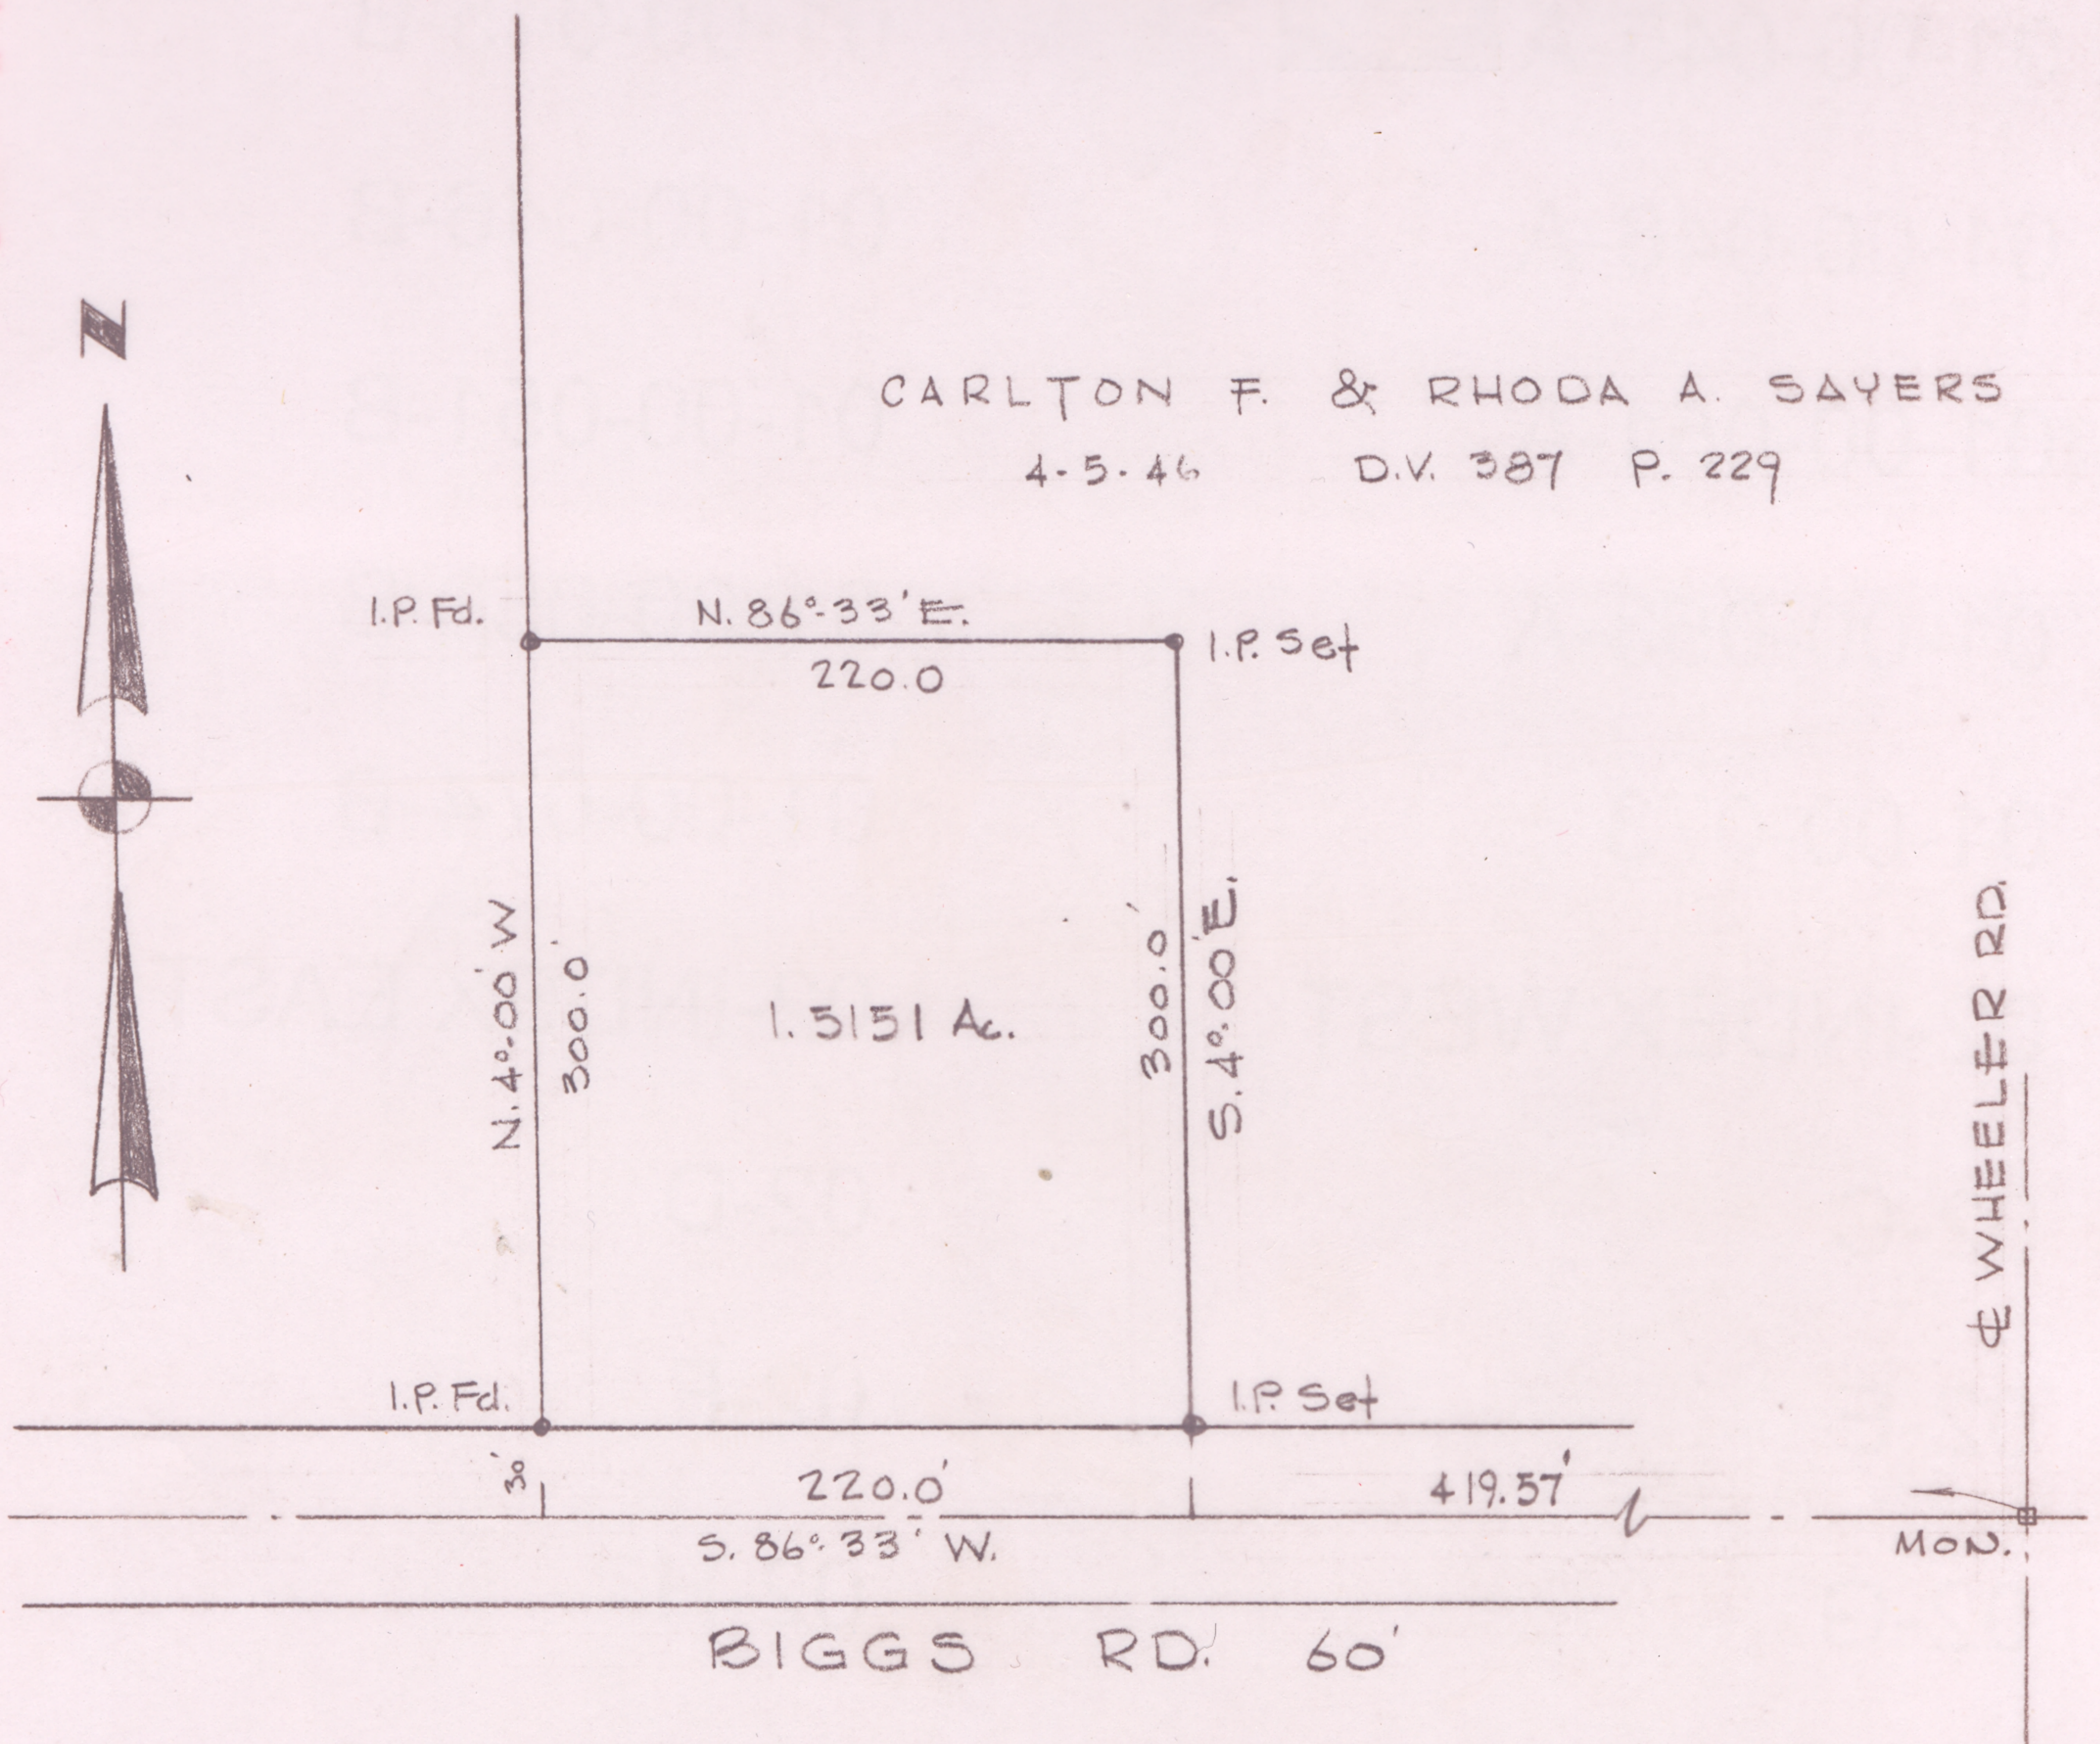

SURVEY FOR

MERLE KRAGE

O.L. 27

LAGRANGE TWP.

LORAIN COUNTY

OHIO

SCALE 1"=100'

NOV. 1977

LAUNDON • SIMON • CAHL & ASSOC.

ENGINEERS

SURVEYORS

JOB No 77-686