



LAUNDON • SIMON • CAHL and ASSOC.  
ENGINEERS  
504 MIDDLE AVE.

SURVEYORS  
ELYRIA, OHIO 4035

FOR: PHILLIP WILSON

TOWNSHIP LAGRANGE  
ORIG. LOT or SEC. 46  
CITY

VILLAGE LAGRANGE  
COUNTY LORAIN  
STATE OHIO


DATE 4-20-82  
SCALE 1"=100'  
JOB NO. 82-1124 F.B. NONE

73-117 FILE

15-00-046-106-006  
15-00-046-106-030  
15-00-046-B  
SCAN #46846



CONRAIL R.R. 100'

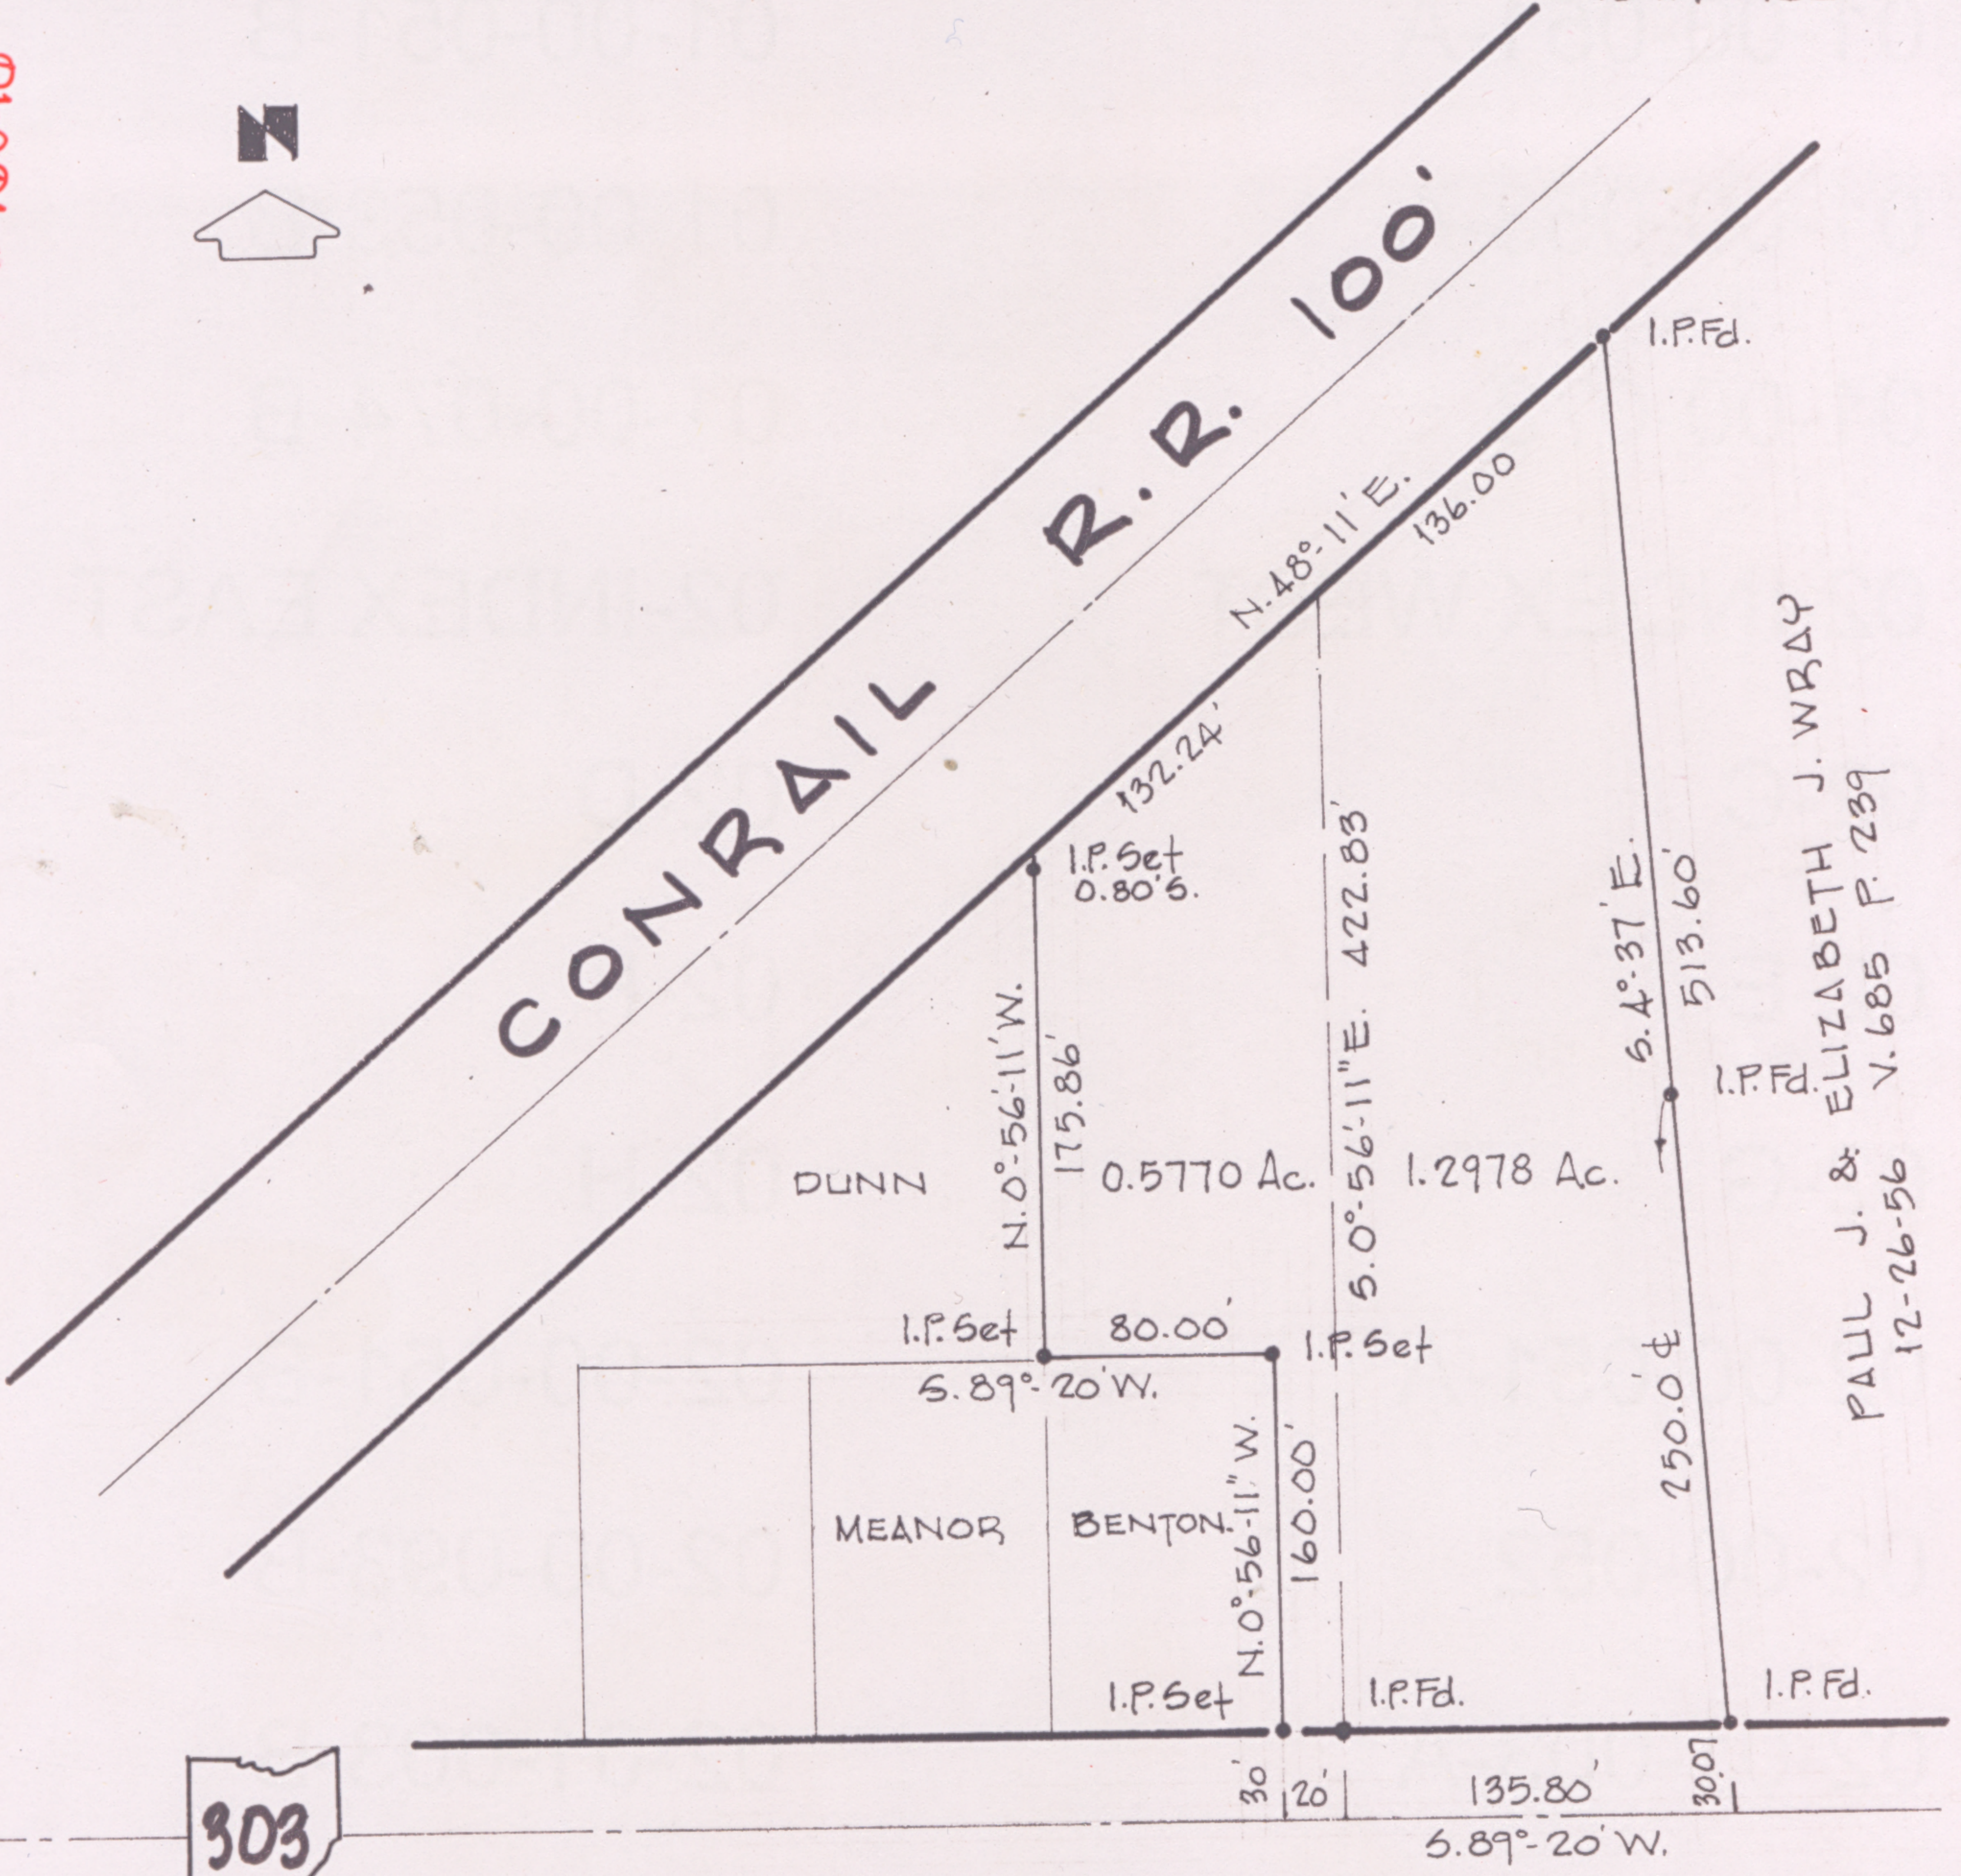

PAUL J. & ELIZABETH J. WRAY  
V. 685 P. 239  
12-26-56



WAKEMAN-LAGRANGE-RICHFIELD RD. 60'